

16-2E

HENDRICKS COUNTY

DESIGNATION OF MARKER East half mile Sec. 2 T 16 N R 2 E

Marker found: yes _____ no _____

Type of Marker: P.K. Nail in Postment

Description: _____



Depth and Marking _____

References set: yes _____ no _____

Sketch References below.

Date: June 15, 1970 Set by: Ray Schunka


Comments: Certified by Gene W. Darnall (Marion County Surveyor's Office)

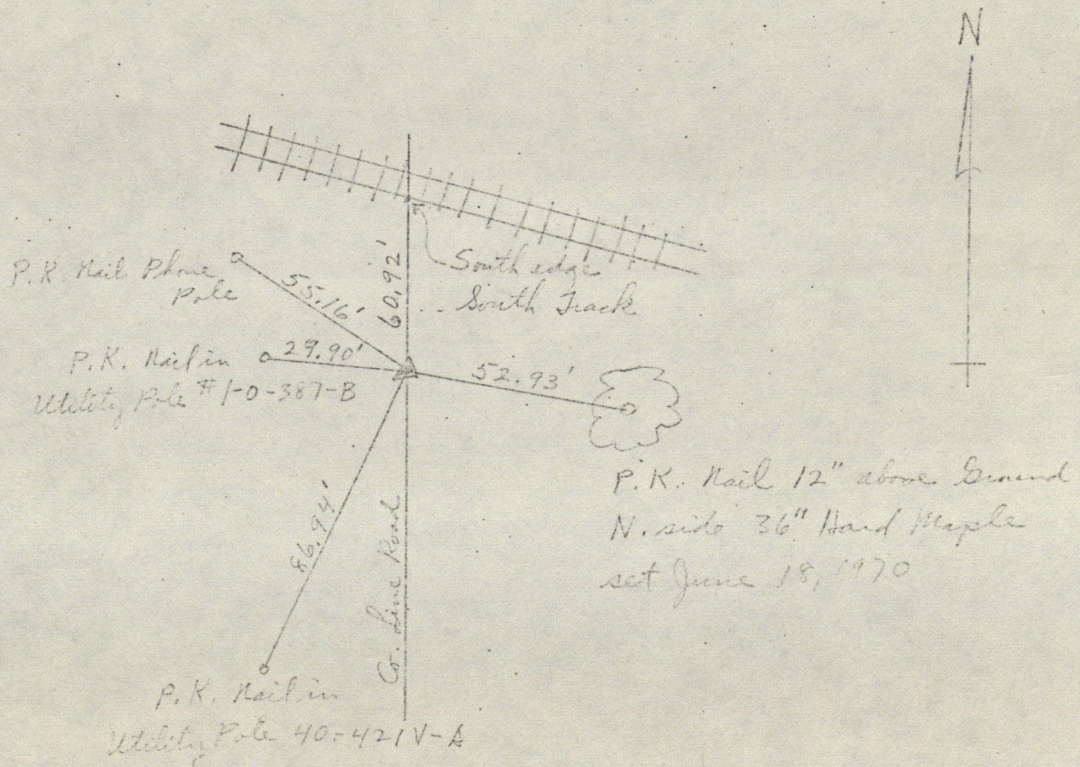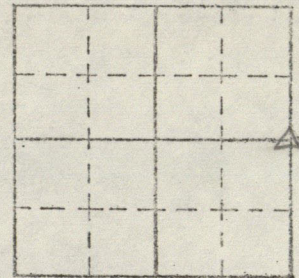

Hendricks County Surveyor

OFFICE OF THE MARION COUNTY SURVEYOR
SECTION RECORD CORNER
SECTION 4 TOWNSHIP 16 RANGE 2
DATE: 6-8-99
PARTY CHIEF: Kiste
CREW: _____
TYPE OF MARKER: PK nail at surface
METHOD OF ESTABLISHMENT: County 9-22-94

IN. S.P.C. E ZONE, NAD 83
NAME: 16020404
N: 512102.3710(m)
E: 43410.3320(m)

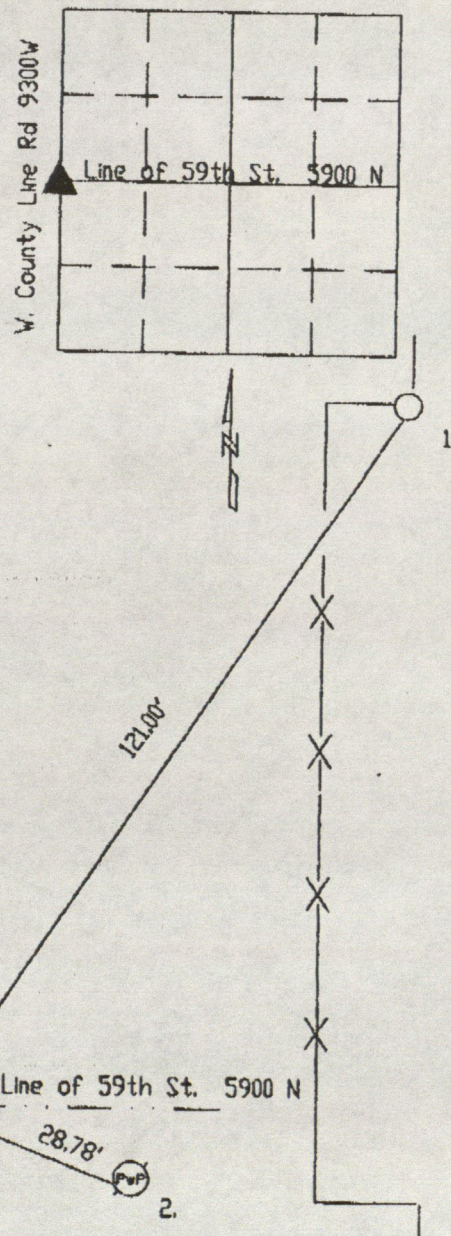

650 N
Hendricks County

SC620404

REF.	DISTANCE	DESCRIPTION
1.	121.00'	NE to face of steel fence post
2.	28.78'	PK nail w/shiner W PwP#15-321WA 12'up
3.	165.15'	SE brick garage for address #9305
4.	54.93'	PK nail N PwP#40-321VA 12'up
5.	29.97'	Railroad spike w/washer E 26' ash 12'up

MARION COUNTY, INDIANA
Sec. 4 T. 16 R. 2



DATE: 7/20/77

CREW: P.C. - R MILLER

Inst. - D. KENT Rod. - T SMITH

TYPE of MARKER: IRON T-POST Cond. of MARKER: GOOD DOWN 4"



METHOD of ESTABLISHMENT: _____

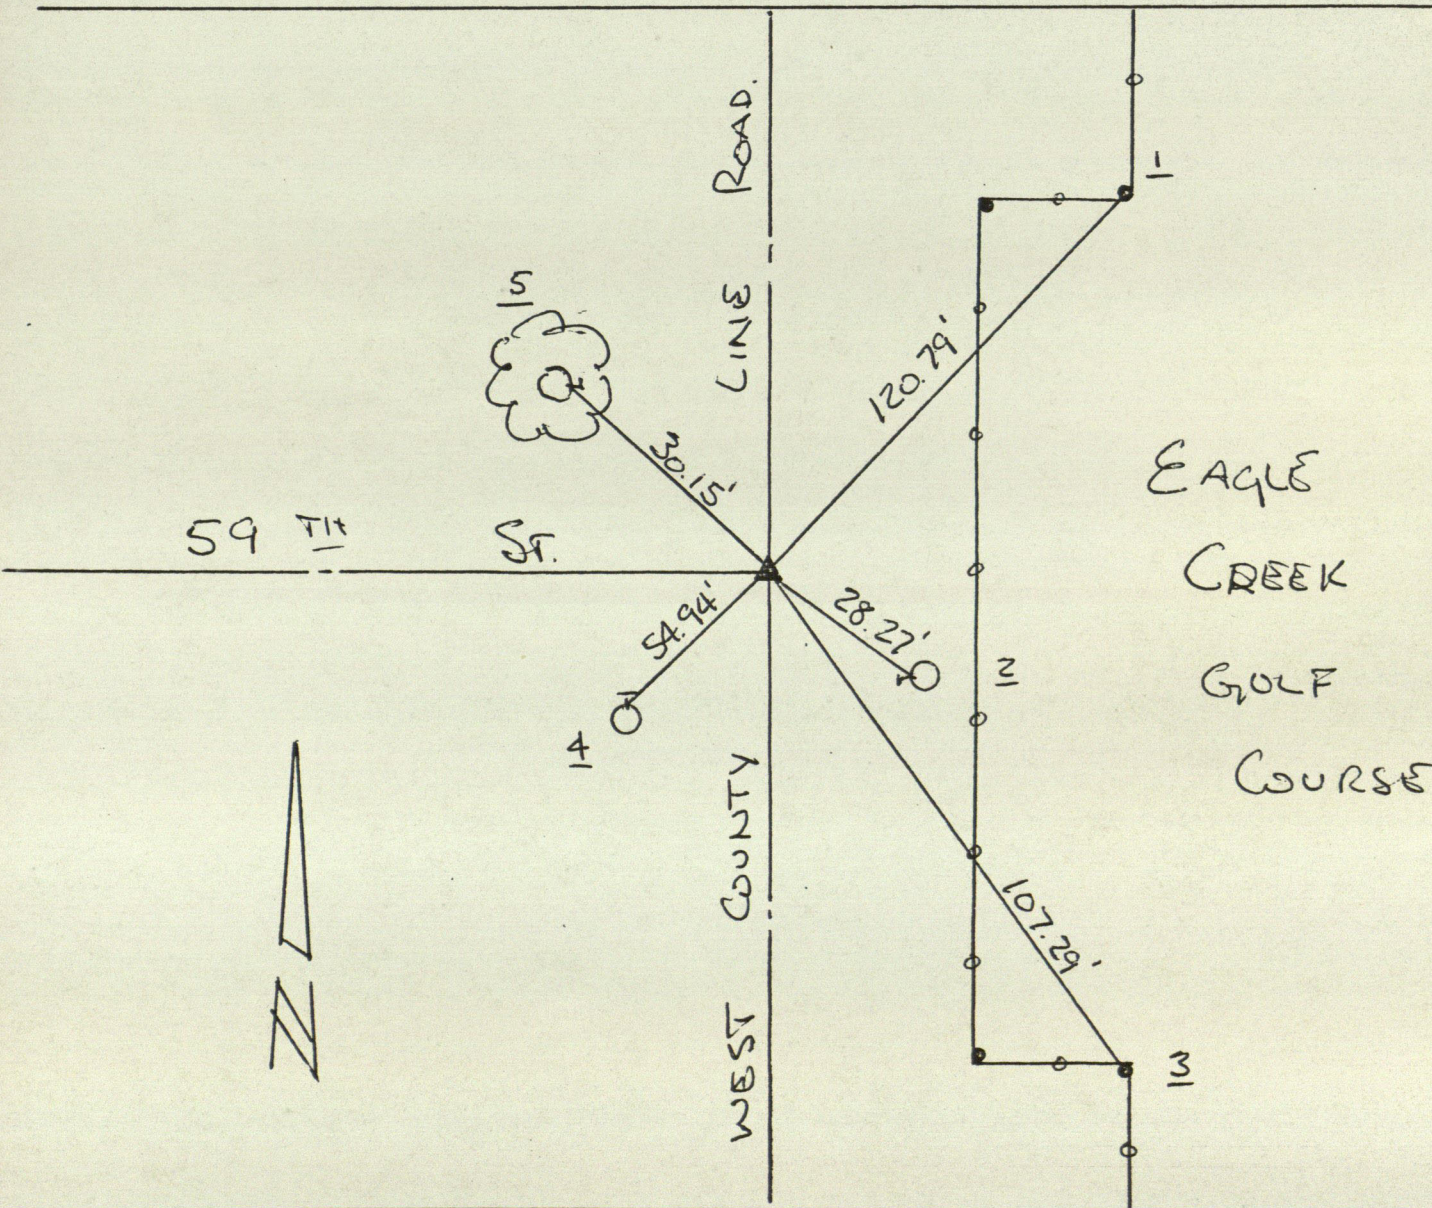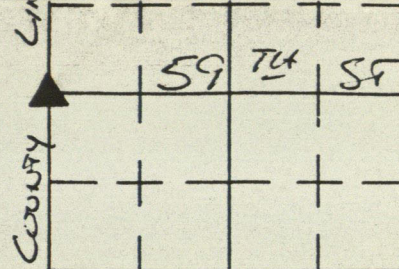

REFERENCE	DISTANCE	DESCRIPTION
1	120.79'	FACE OF STEEL FENCE POST
2	28.27'	PK NAIL WEST SIDE PWP# 5895 8"UP
3	107.29'	FACE OF STEEL FENCE POST
4	54.94'	PK NAIL N. SIDE PWP# 40-321VA
5	30.15'	RP SINK EAST SIDE 3"AL 17"UP

HENDRICKS COUNTY

DESCRIPTION OF MARKER E 1/2 mile Stone SEC. 5 TWP 16 RANGE 2E

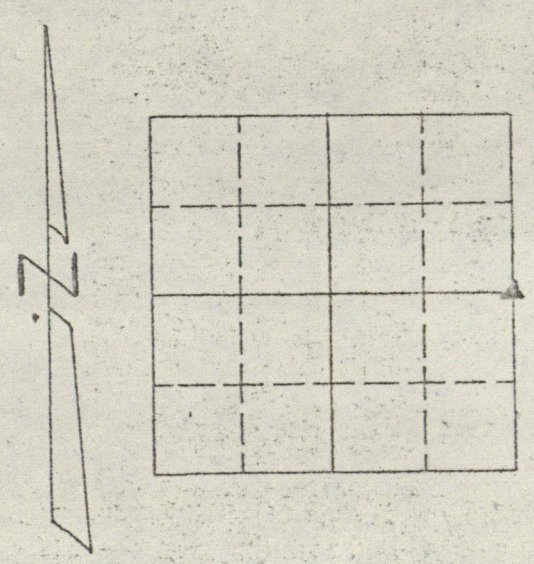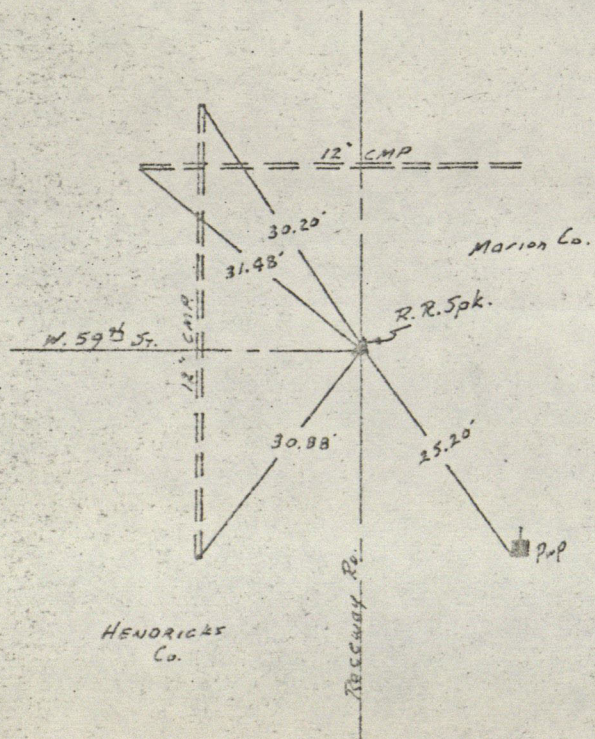

E 1/2 Mile, Sec. 5-16-2E

4-27-73 CB

HENDRICKS COUNTY

DESIGNATION OF MARKER East 1/2 mile Sec. 5 T 16 N R 2 E

Stone
Marker found: yes ☒ no ☐

Type of Marker: _____

Description: _____

Depth and Marking _____


References set: yes ☐ no ☐

Sketch References below.


Date: 1957

Set by: Alan Stanley

Comments:

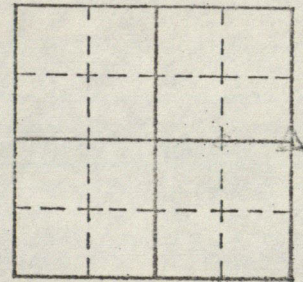

Note: Iron Pipe at
N.E. Corner NE⁴ SE⁴.


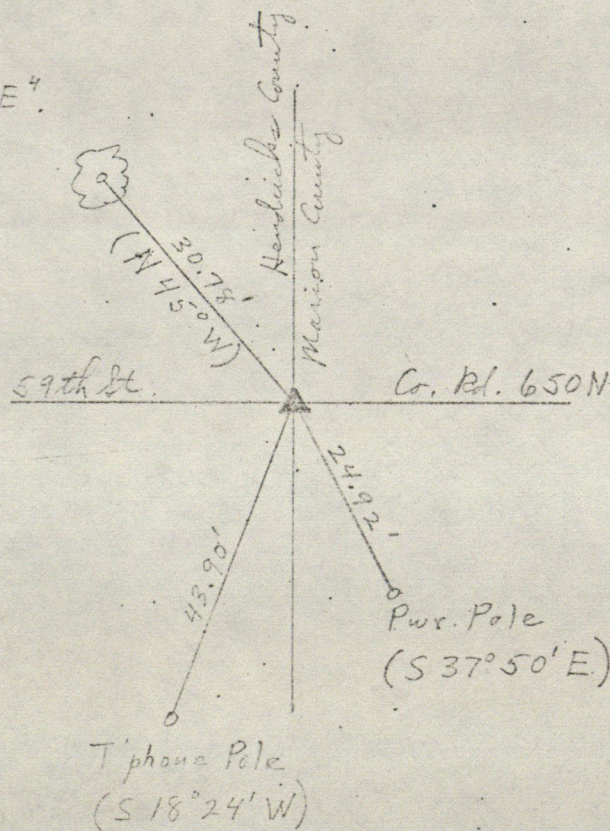


Hendricks County Surveyor

5-16-2E.




G. JONES TIES USED & THE
BRASS PLUG WAS FD.

JONES TIES SAY THERE IS A STONE
UNDER THE PLUG, SO A SEARCH WAS
MADE THERE, BUT NO STONE WAS
FD. THE PLUG IS 0.7' DEEP
A R/R SPK WAS SET ON TOP & NEW
TIES MADE 11-28-33 BY
S. MAXWELL & D. SMITH

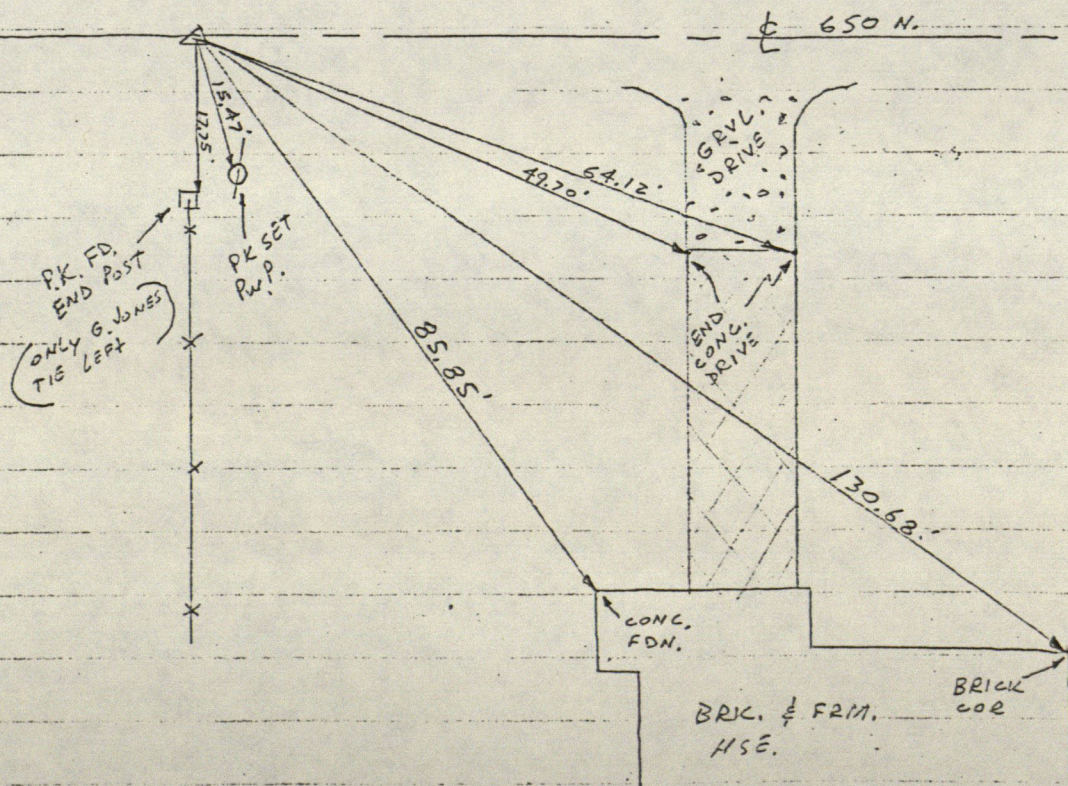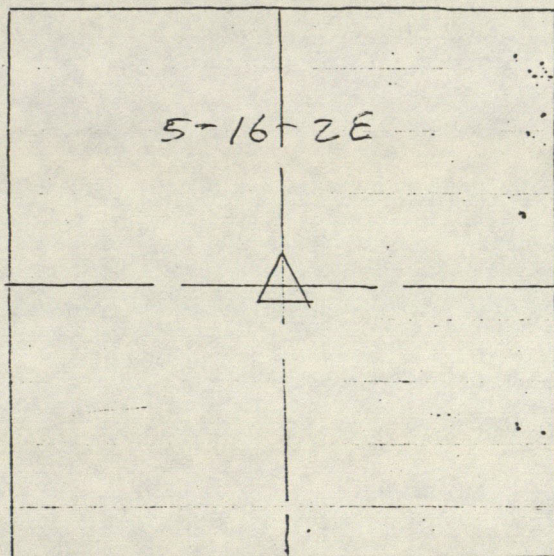

HENDRICKS COUNTY

DESCRIPTION OF MARKER SE Cor. SEC 5 TWP 16 RANGE 2E

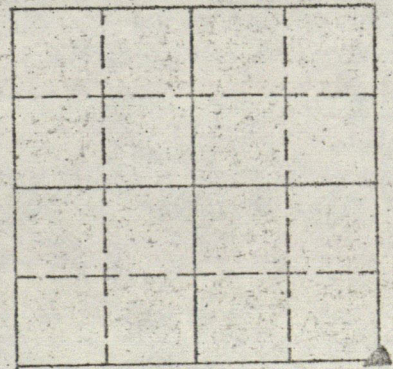
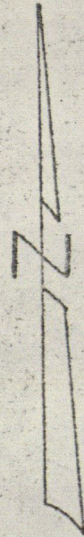
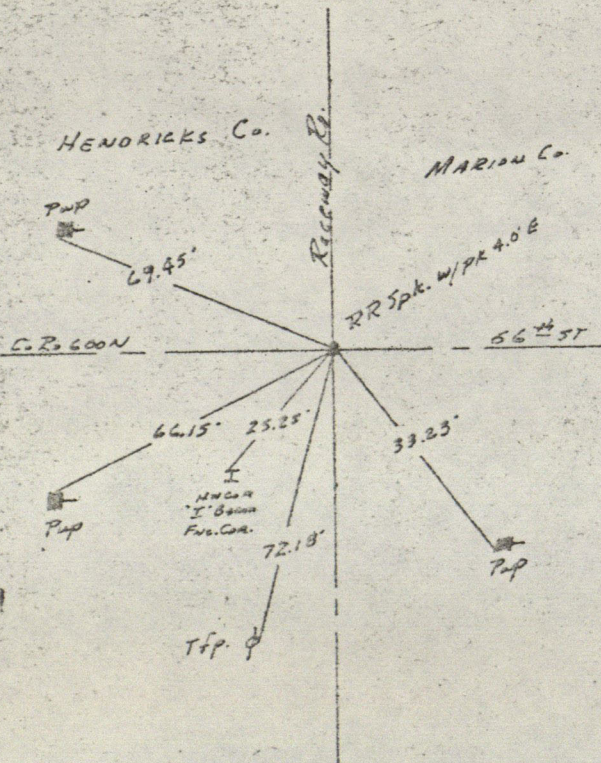


S.E. COR., SEC. 5-16-2E

HENDRICKS COUNTY

DESIGNATION OF MARKER S.E. Cor. SW 1/4 - SE 1/4

SEC 5 TWP 16 RANGE 2E

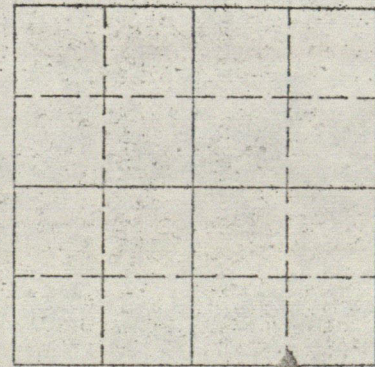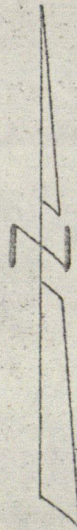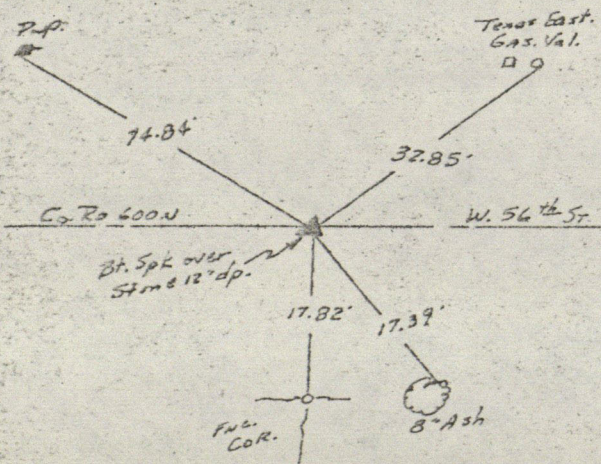

1

S.E. Cor. SW 1/4, SE 1/4, SEC. 5-16-2E

7-24-73
C.C.

HENDRICKS COUNTY

DESIGNATION OF MARKER _____ SEC. 5 T. 16 N. 2 E R.

Marker found: yes _____ no ☒

Type of Marker: IRON PIN SET

Description: _____



Depth and Marking: _____

References set: yes ☒ no _____

Sketch References below.




Date: 8-8-75 Set by: Dick Hayden

Comments:

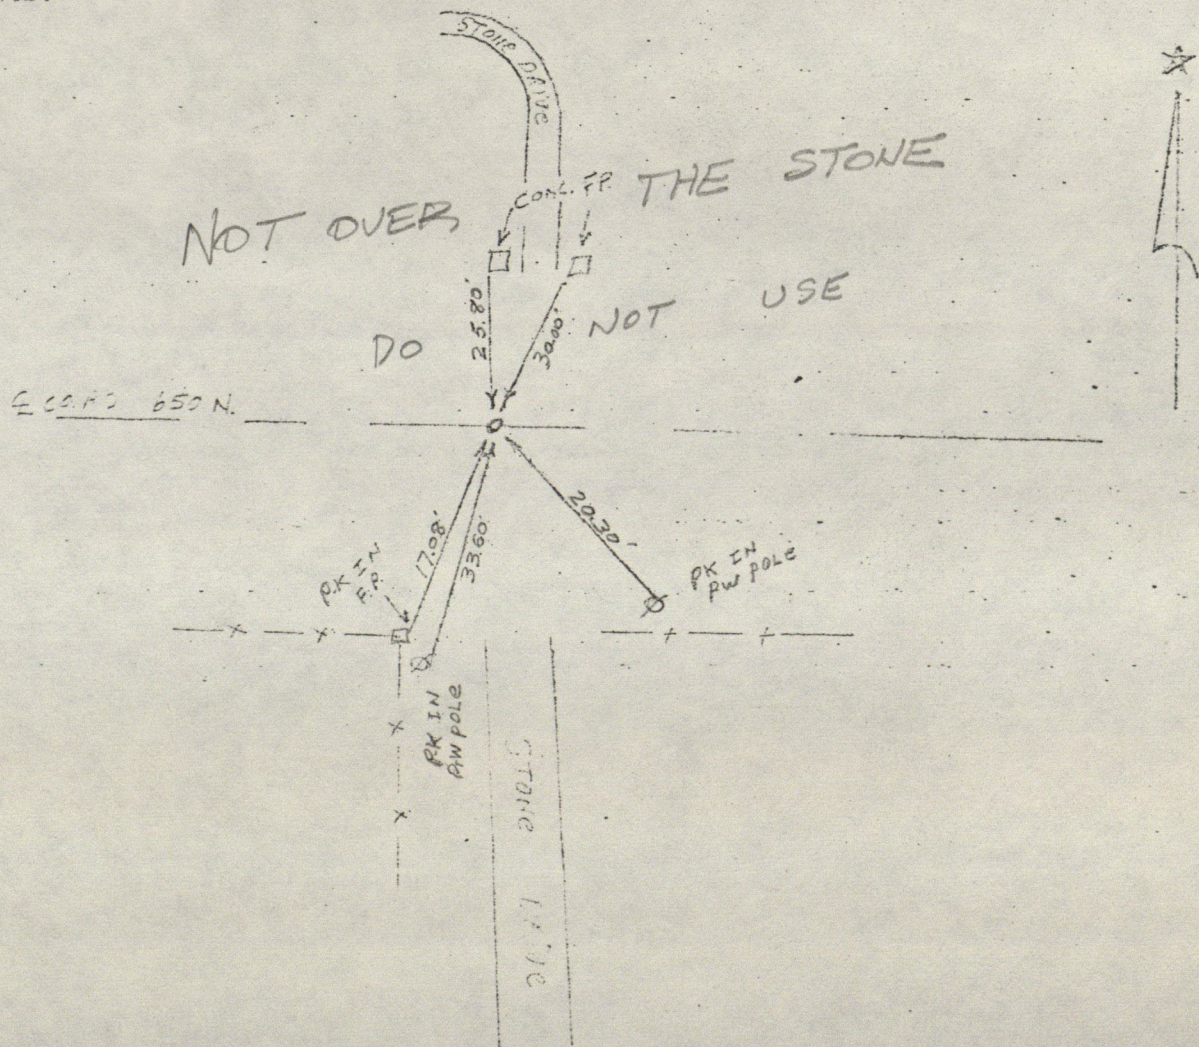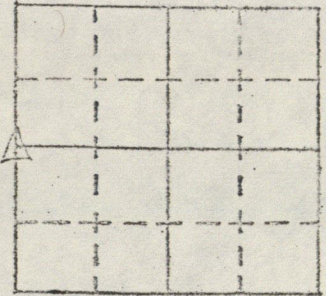

HENDRICKS COUNTY

DESCRIPTION OF MARKER S. 1/2 Mile Stone SEC. 5 TWP 16 RANGE 2E

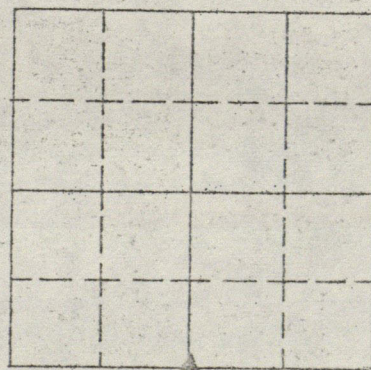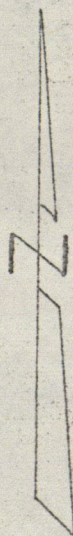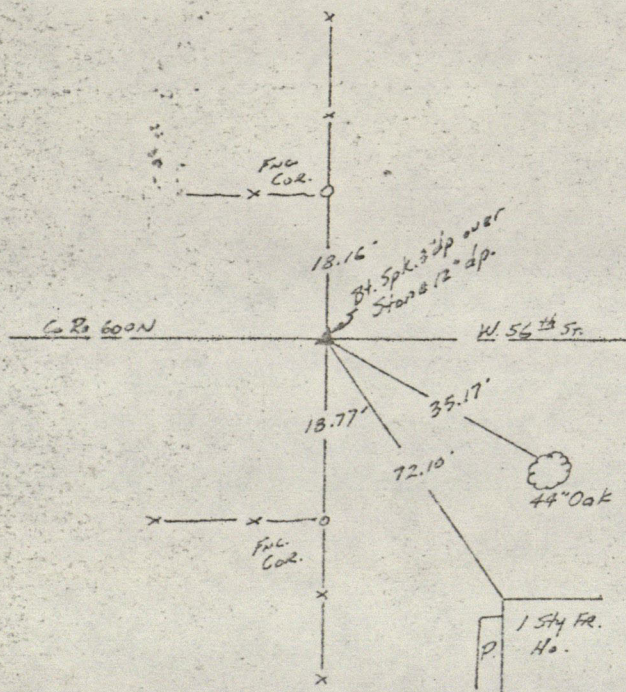




S. 1/2 Mile, SEC. 5-16-2E

7-26-73
CB

HENDRICKS COUNTY

DESCRIPTION OF MARKER Center

SEC 5 TWP 16 RANGE 2E

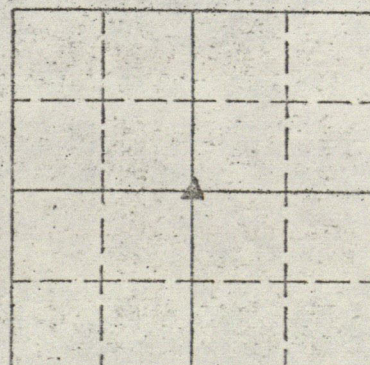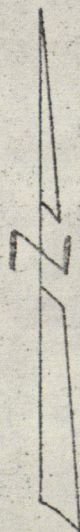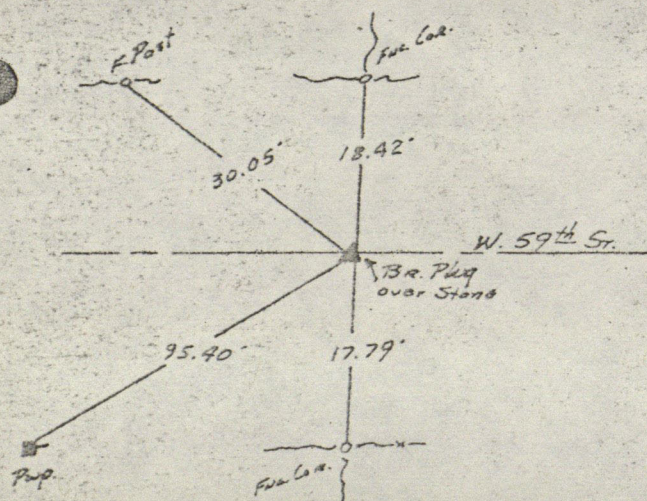

Center, SEC. 5-16-2E

13.70
1.55

CENTER S. OF NW 1/4 SEC. 5-16-2E

STONE FOUND

STONE WAS FOUND 2' E. OF

ROAD SURFACE AND MEAS. 16" X 8" X 8".

STONE WAS FOOTBALL SHAPED AND

ALSO ~~LIE~~ IN THE E. OF C.R. 650 N.

IN LINE WITH FENCES RUNNING BOTH

NORTHWARD & SOUTHWARD. R.R. SPR. BORED

LAYING DOWN ON E. SIDE OF STONE. P.K. NAIL

SET OVER TOP OF STONE. NOTE: PURPOSE OF B-YING R.R. SPR.

IS SO THE STONE CAN BE

PICKED UP BY METAL DETECTOR.


FOUND BY:

L.DY J. SHANBACH

TEOD J. HATTING

JANUARY 30, 1980


JULY 25

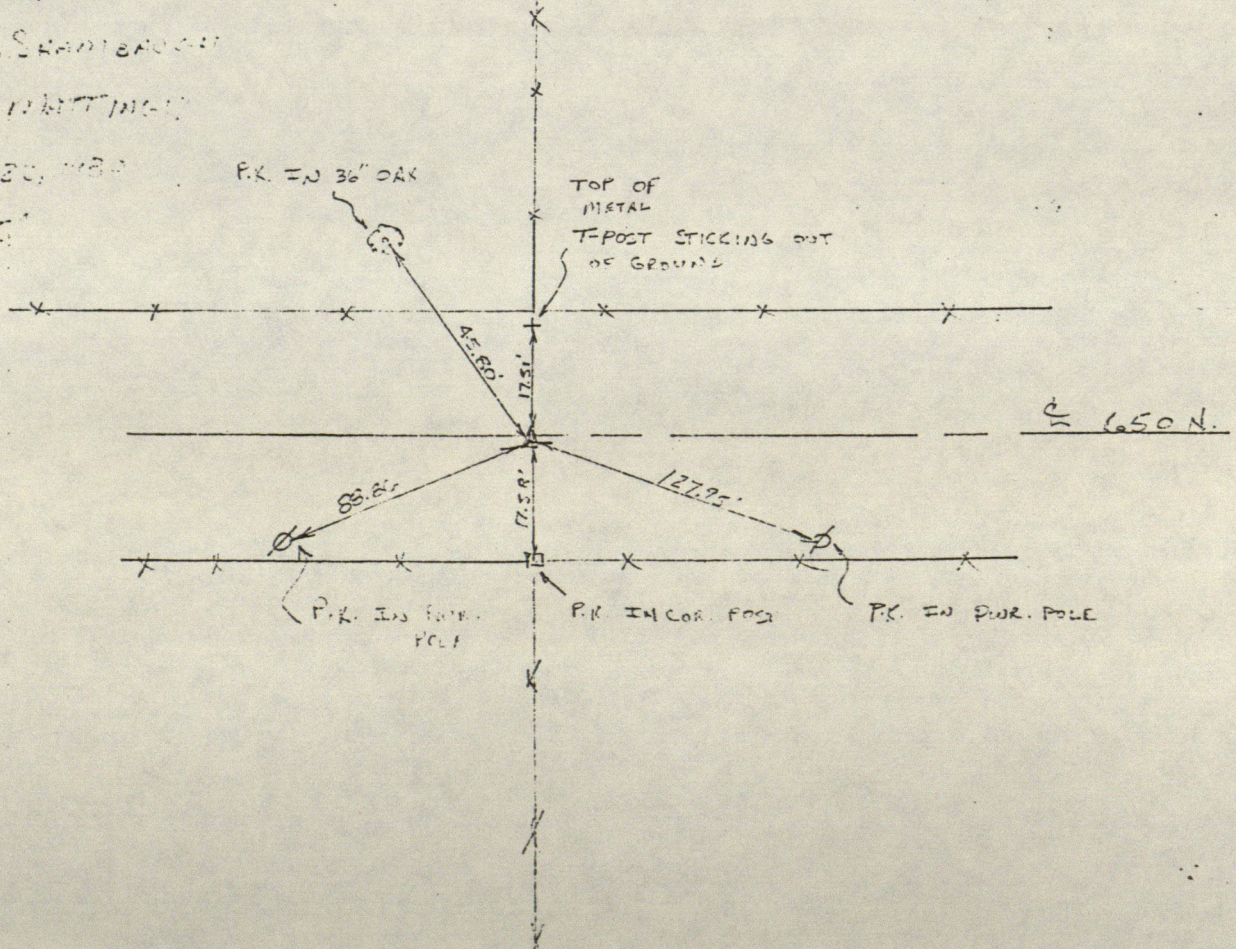

CENTER N. OF N.W. 1/4 SEC. 5-16N-2E

STONE FOUND

6' BELOW ROAD CORNER AND
1.5' S. OF E. OF 700 N. L.S.
IN LINE WITH FENCE RUNNING
SOUTHWARD. WE DIDN'T UNCOVER
STONE ALL THE WAY, WHAT WE
DID UNCOVER MEAS. 16" X 6" X 6"
STONE WAS FOOTBALL SHAPED WITH
POINT ON TOP. R.R. SPR. SET
OVER POINT OF STONE.

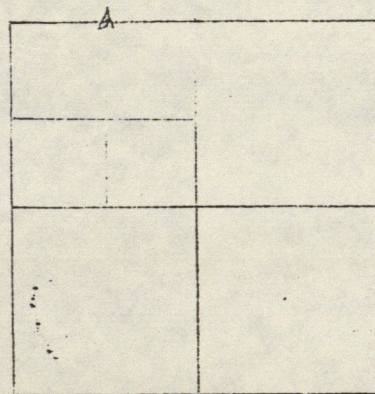


FOUND BY:

RANDY J. SHAMBAUGH

TODD J. MATTINGLY

JANUARY 18, 1930

CLOUDY 35°

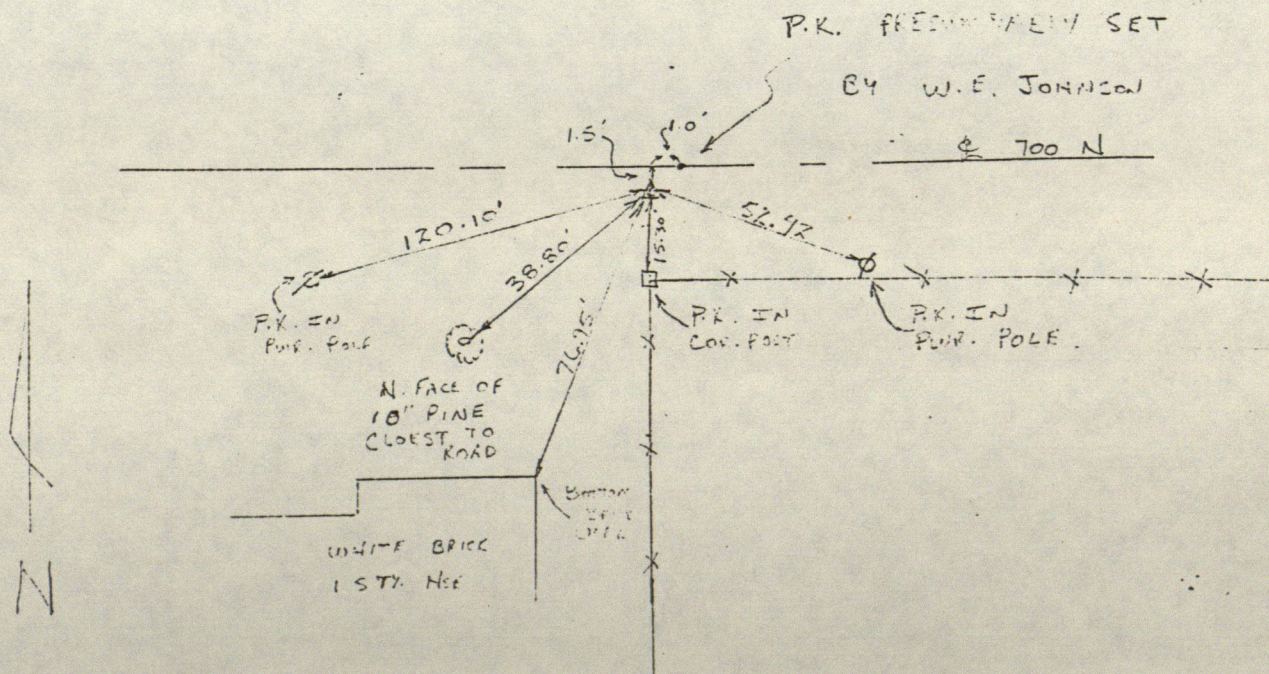


Railroad spike found

Large search area no stone found

R.R. spike appears to be where stone

should be. will set Hendricks Co.



marker after road is paved

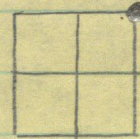

Sec 5-1/4 N-2 E

Tri-Pod Survey

10-1-92

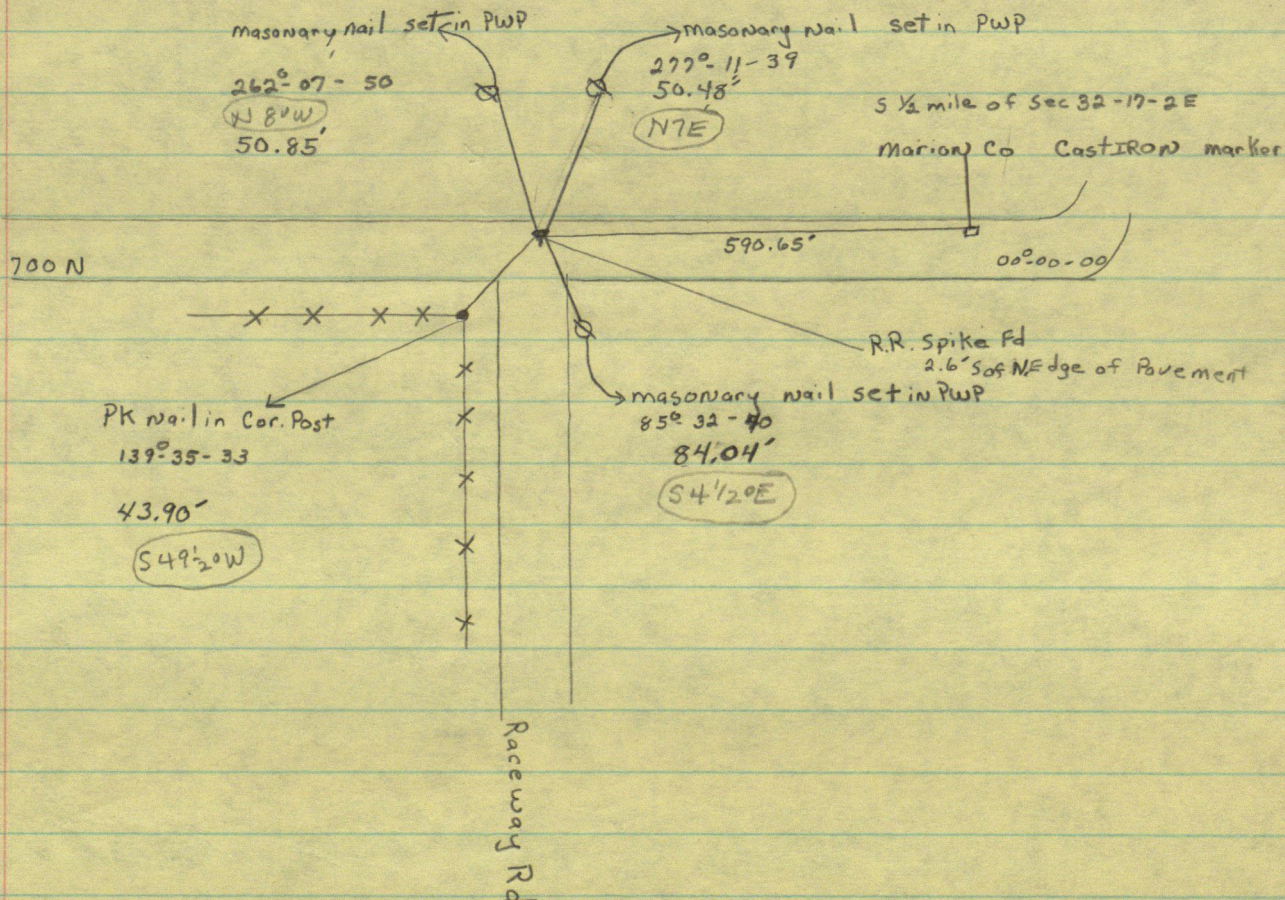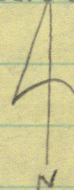


RECORD OF CORNER

LOCATION OF MONUMENT: SECTION 5, T. 16 N., R. 2 E.

Found: ☒ Set: ☐ Depth: ☐ See below

Description: ☐ See below

Bearings to reference objects are magnetic unless a contrary mode is shown.

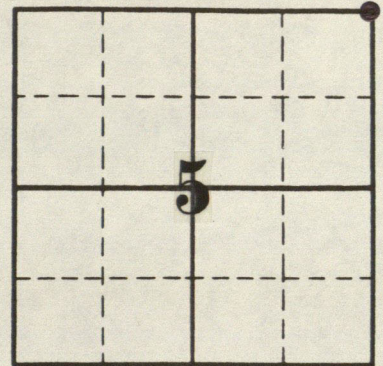

Masonry nail in power pole

Only a railroad spike was found in a large hole dug for a stone. The spike appears to be at a plausible location and will be replaced by a county standard rebar and disk after the road is paved.

COUNTY ROAD 700 NORTH

590.65' to S½ Mi. Stone 32-17-2E

2.6'

N8°W 50.85'

N7°E 50.48'

S49½°W 43.90'

PK nail in
Wood cor. post

RACEWAY ROAD

S4½°E 84.04'

Masonry nail in power pole



Stanley M. Shartle
Stanley M. Shartle, P.E. & L.S.

Date: October 19, 1992



STANLEY M. SHARTLE

LOCATION OF MONUMENT: SECTION 6, T. 16 N., R. 2 E.

Found: ☒ Set: ☐ Depth: 2 inches

Description: notch in top of stone 6x12x20.5"

Bearings to reference objects are magnetic unless a contrary mode is shown.

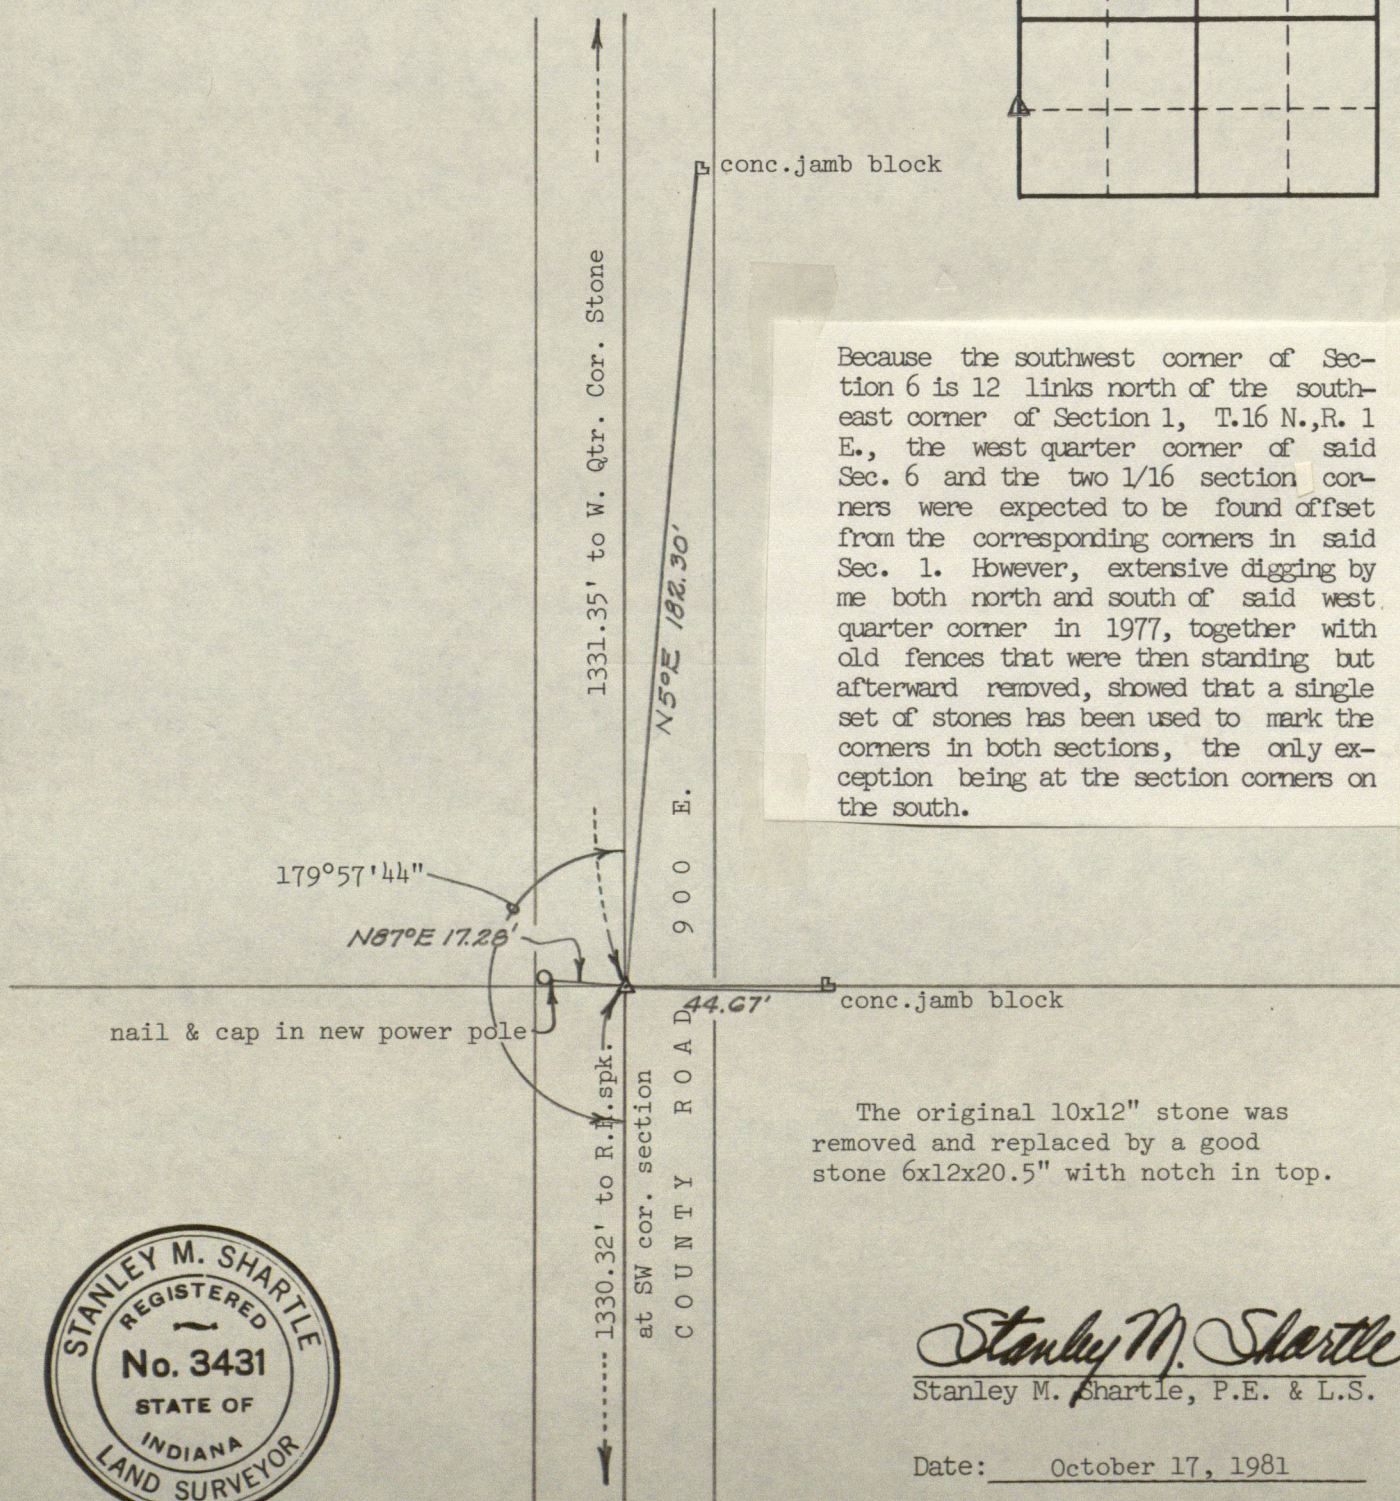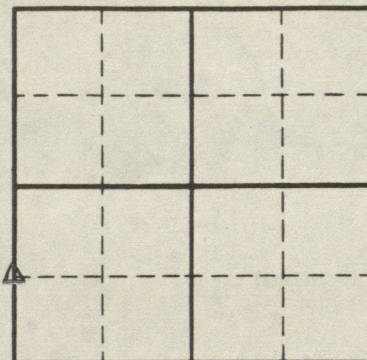

Because the southwest corner of Section 6 is 12 links north of the southeast corner of Section 1, T.16 N., R. 1 E., the west quarter corner of said Sec. 6 and the two 1/16 section corners were expected to be found offset from the corresponding corners in said Sec. 1. However, extensive digging by me both north and south of said west quarter corner in 1977, together with old fences that were then standing but afterward removed, showed that a single set of stones has been used to mark the corners in both sections, the only exception being at the section corners on the south.

The original 10x12" stone was removed and replaced by a good stone 6x12x20.5" with notch in top.






Stanley M. Shartle
Stanley M. Shartle, P.E. & L.S.

Date: October 17, 1981

HENDRICKS COUNTY

DESIGNATION OF MARKER W 1/2 mile SEC 6 TWP 16 RANGE 2E

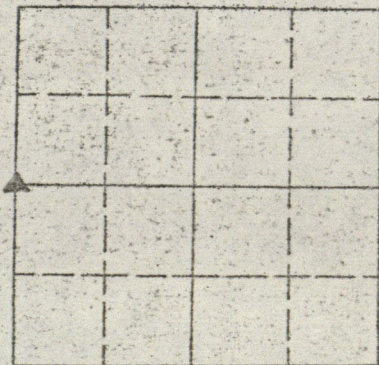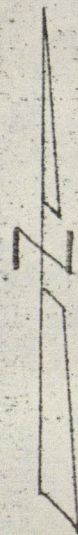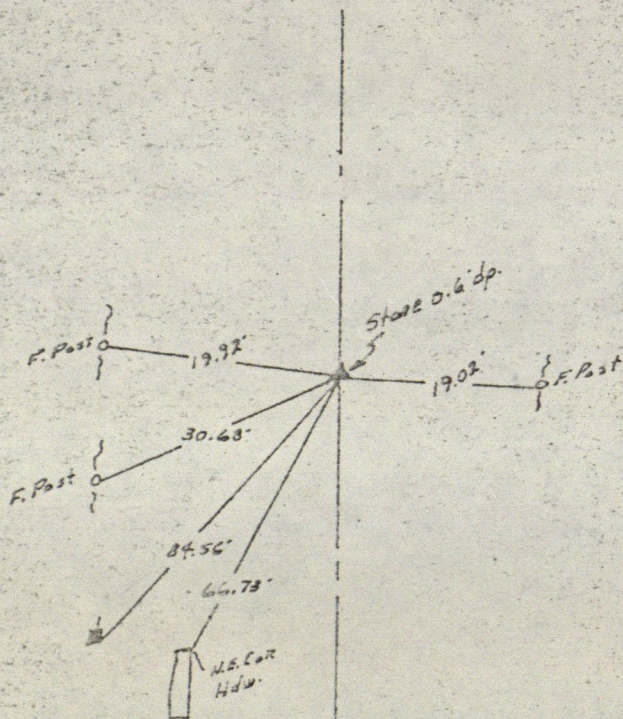

W 1/2 Mile, SEC. 6-16-2E


STANLEY M. SHARTLE

LOCATION OF MONUMENT: SECTION 6, T.16 N., R.2 E.

Found: ☒ Set: ☐ Depth: 8 inches

Description: slight D.H. in stone


Bearings to reference objects are magnetic unless a contrary mode is shown.

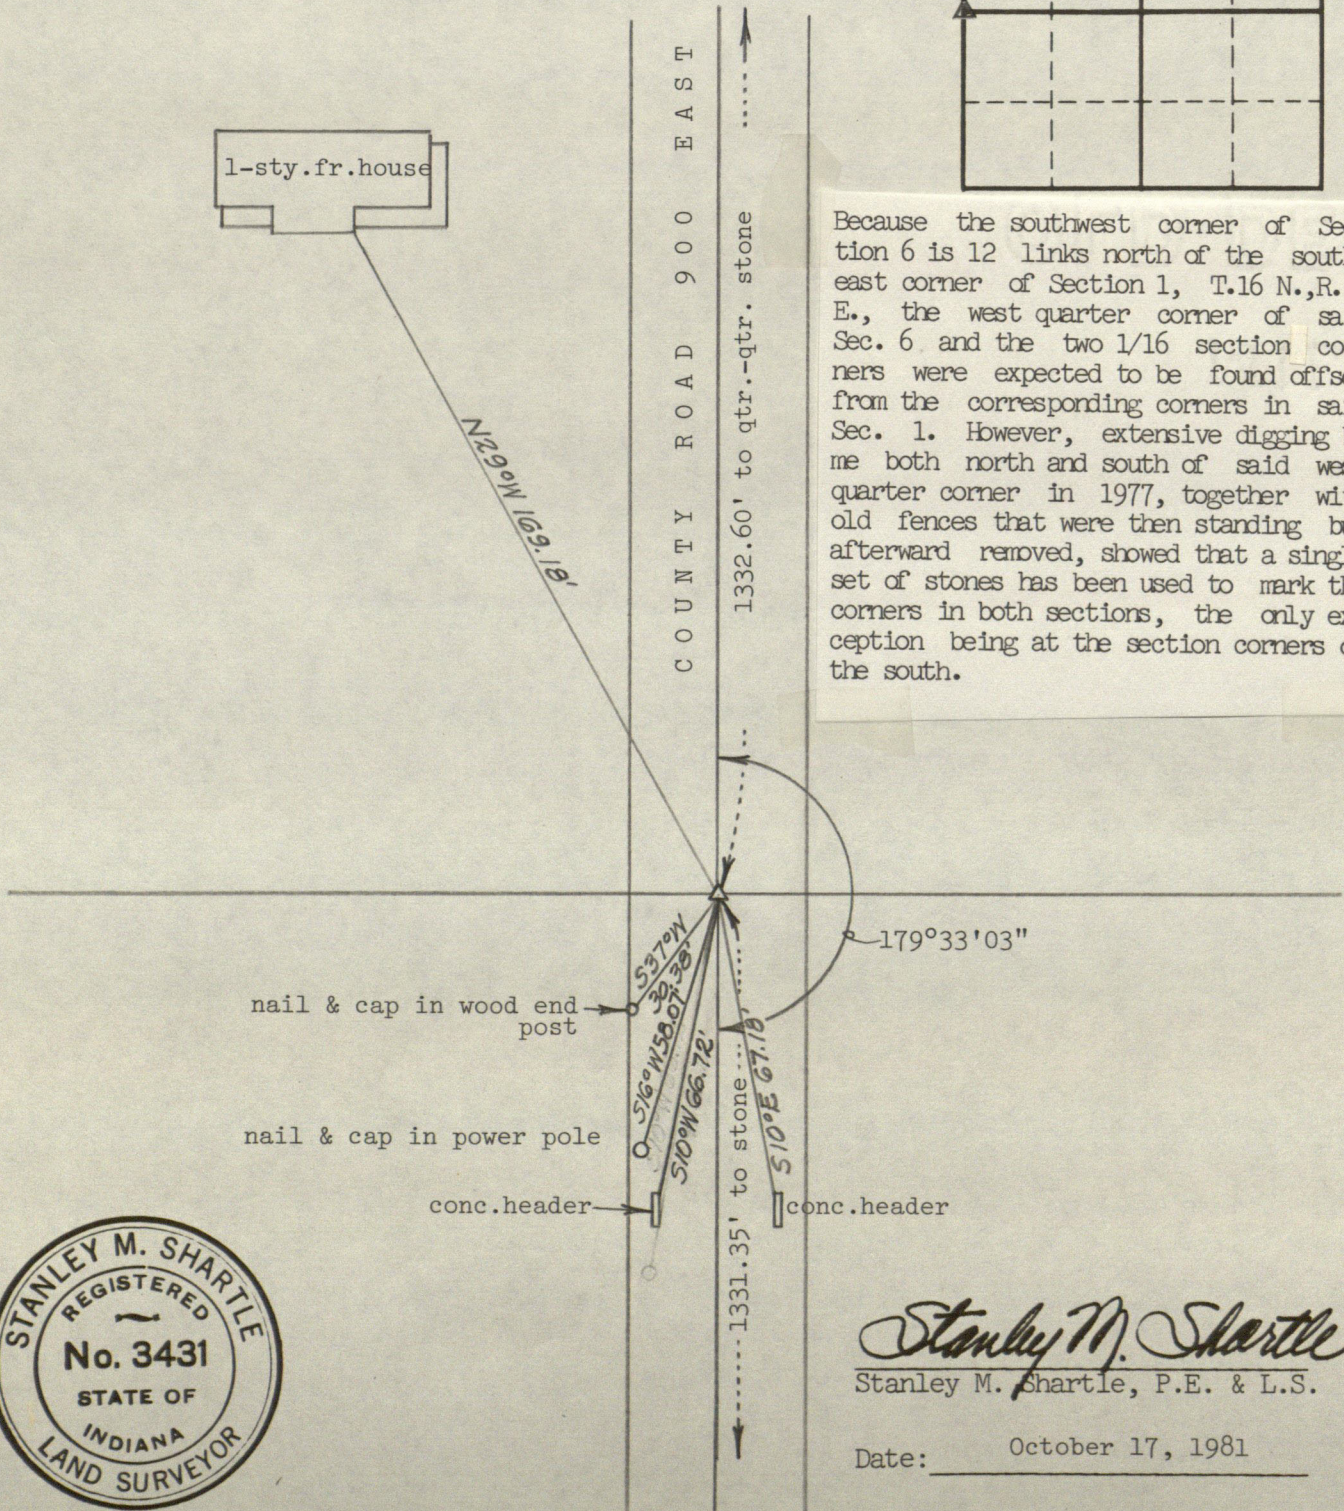

Because the southwest corner of Section 6 is 12 links north of the southeast corner of Section 1, T.16 N., R. 1 E., the west quarter corner of said Sec. 6 and the two 1/16 section corners were expected to be found offset from the corresponding corners in said Sec. 1. However, extensive digging by me both north and south of said west quarter corner in 1977, together with old fences that were then standing but afterward removed, showed that a single set of stones has been used to mark the corners in both sections, the only exception being at the section corners on the south.

Stanley M. Shartle
Stanley M. Shartle, P.E. & L.S.

Date: October 17, 1981

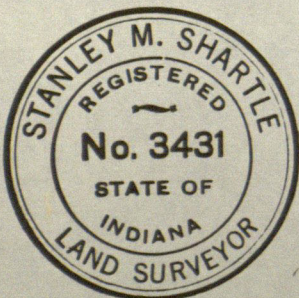

STANLEY M. SHARTLE

LOCATION OF MONUMENT: SECTION 6, T. 16 N., R. 2 E.



Found: ☒ Set: Depth: 16 inches

Description: stone with drilled hole

Bearings to reference objects are magnetic unless a contrary mode is shown.

nail & cap in power pole
Apparent center line of road

Metal was detected 17.7' W. and 1.6' N. of the sec. corner, but no digging was done because of buried cable. Record offset = 18 links.

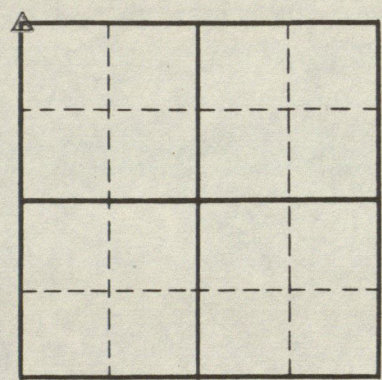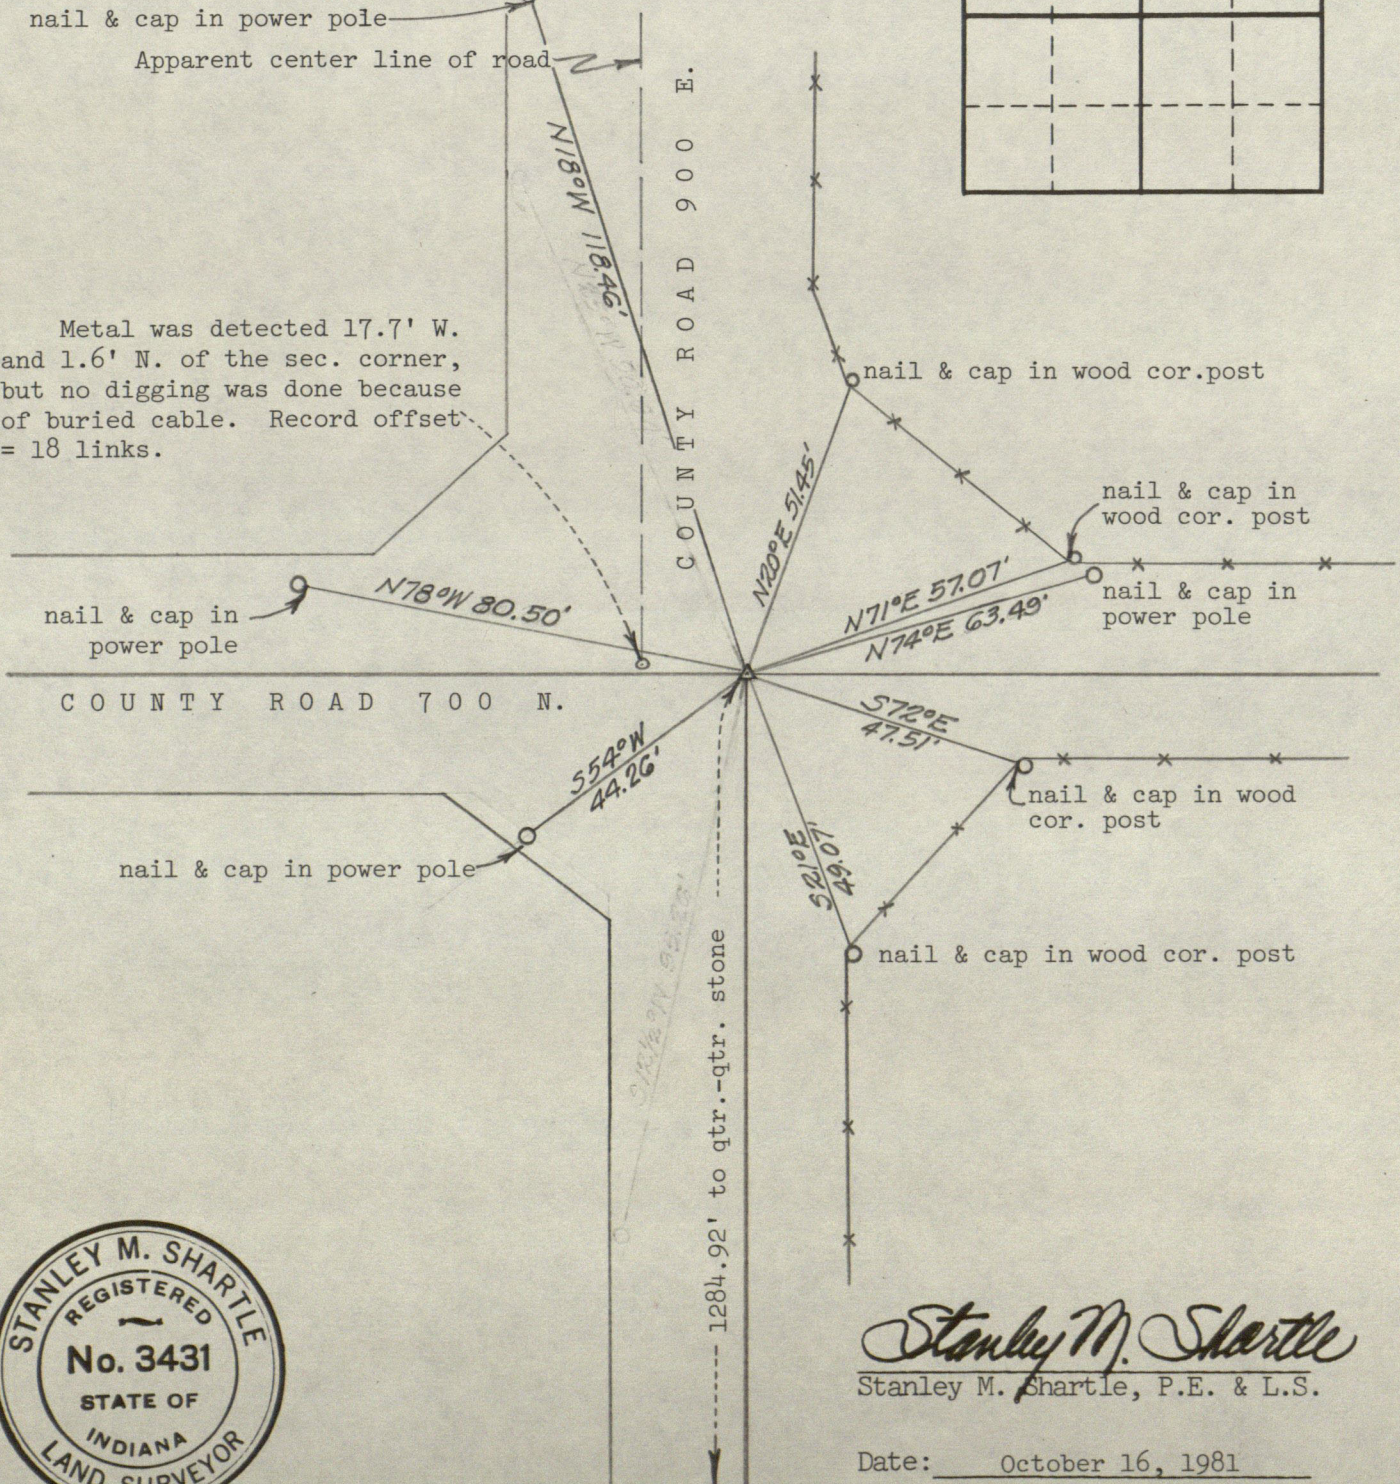

Stanley M. Shartle
Stanley M. Shartle, P.E. & L.S.

Date: October 16, 1981



STANLEY M. SHARTLE

LOCATION OF MONUMENT: SECTION 6, T.16 N., R.2 E.

Found: ☒ Set: Depth: 4 inches

Description: faint + on stone

Bearings to reference objects are magnetic unless a contrary mode is shown.

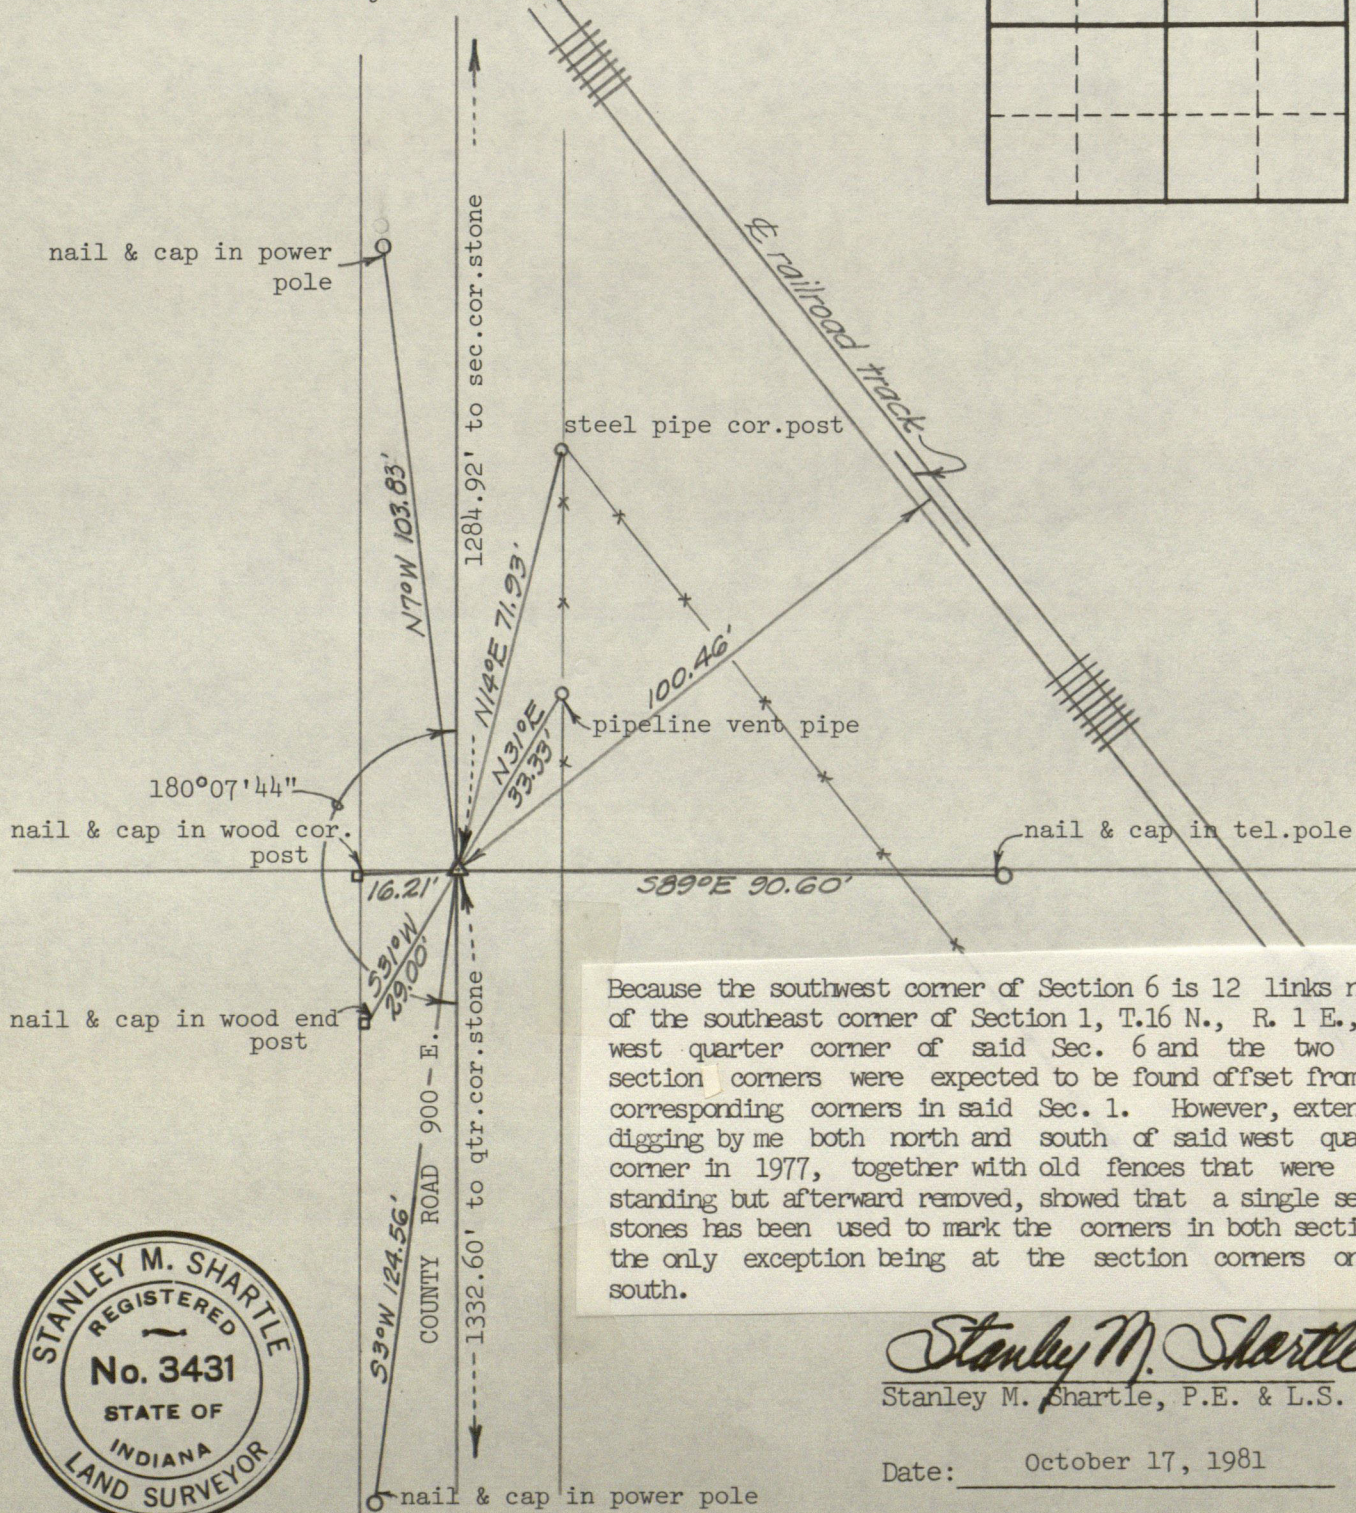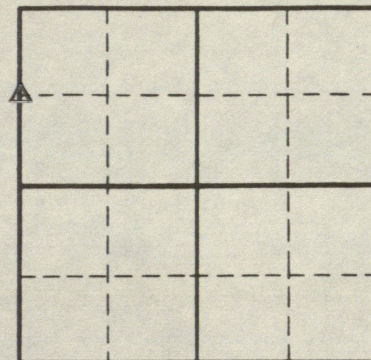

Because the southwest corner of Section 6 is 12 links north of the southeast corner of Section 1, T.16 N., R. 1 E., the west quarter corner of said Sec. 6 and the two 1/16 section corners were expected to be found offset from the corresponding corners in said Sec. 1. However, extensive digging by me both north and south of said west quarter corner in 1977, together with old fences that were then standing but afterward removed, showed that a single set of stones has been used to mark the corners in both sections, the only exception being at the section corners on the south.



Stanley M. Shartle
Stanley M. Shartle, P.E. & L.S.

Date: October 17, 1981

SEC, 6-T. 16 N.-R. 2 E.

ROUND STONE FD.

1 DEEP

G. JONES F.K. NAME FOUND

ALL STONE F.D. FOUND




TIES ARE GONE EXCEPT ONE.

P.K. REPLACED WITH A 1/4 S.F.K.

NEW TIES MADE

11/29/77

S. MAXWELL & M.A. SHAMBAUGH

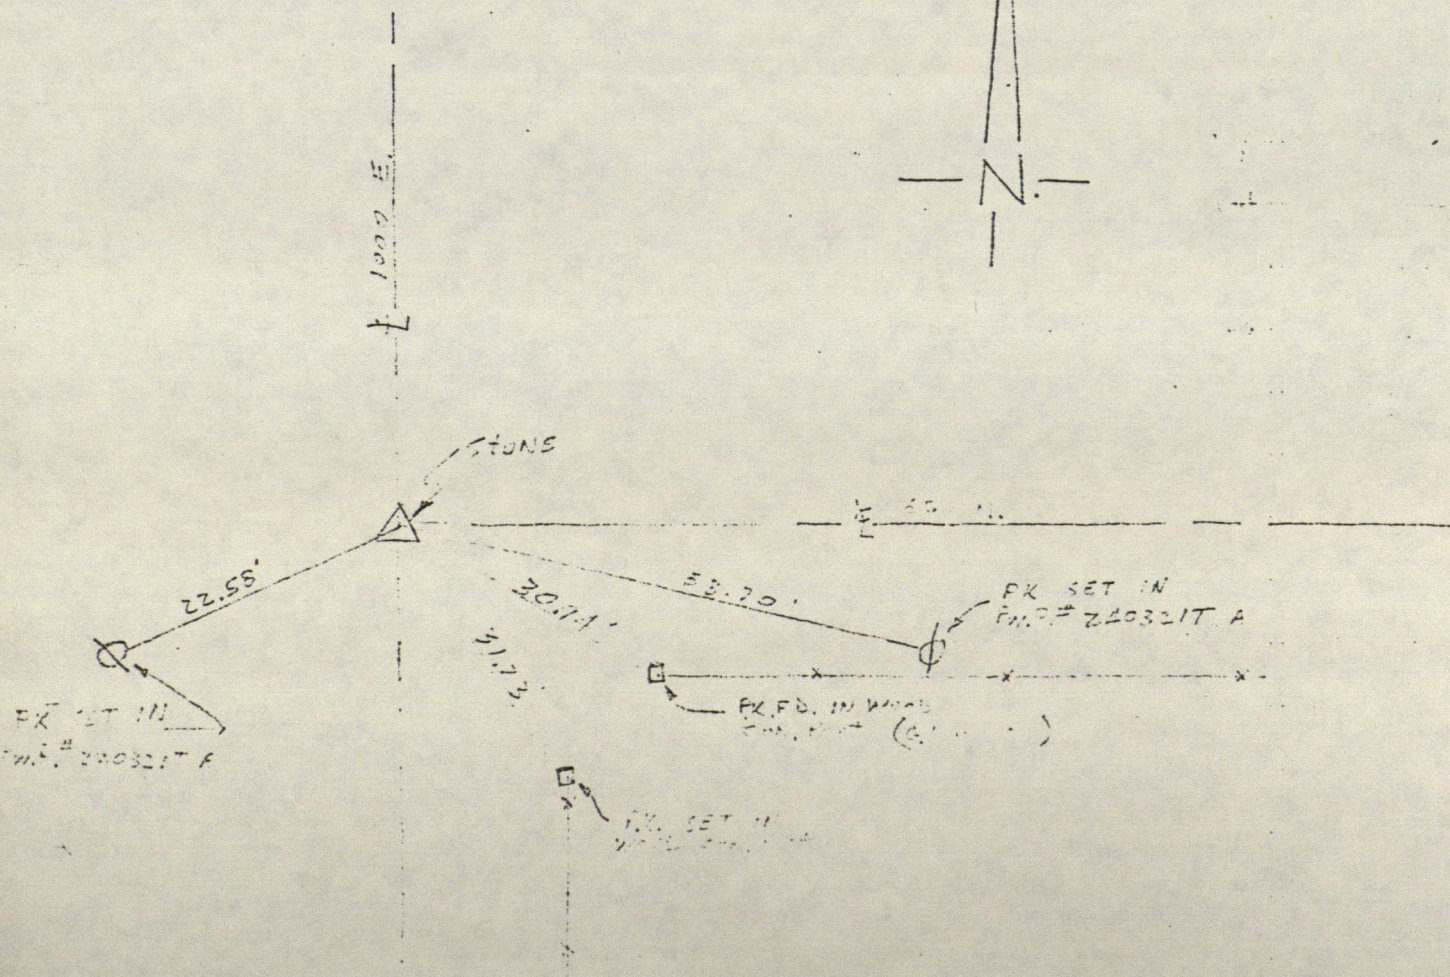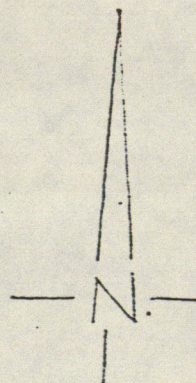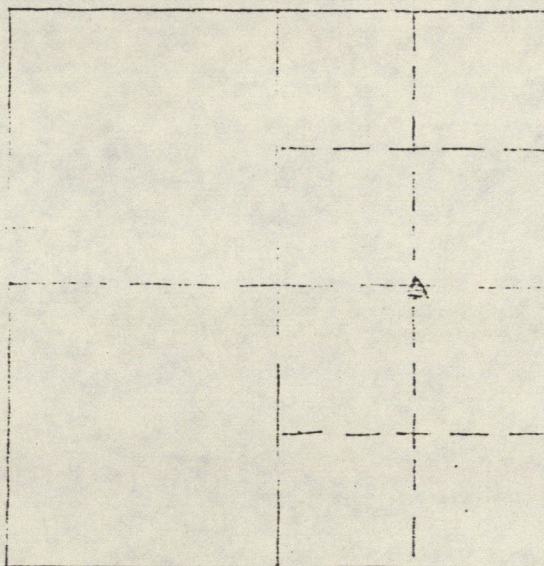

N.E. COR. N.W. 1/4, N.E. 1/4

SEC. 6-16N-2E.

Host: *Arctostaphylos*


At LHAS 1107 27 2 1917

PROBABLY LIGER. FORM 2.5'

BELOW ROAD SURFACE. USED

TALLEST POINT ON ISLAND.

SET R.R. 4th OVER FRONT.

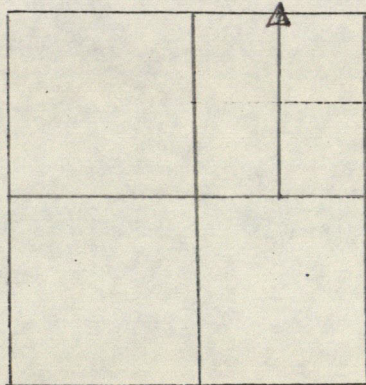


Found By:

RANDY J. SHAMBAUGH

TOOD J. MATTINGLY




JANUARY 16, 1950

Cloudy 37°

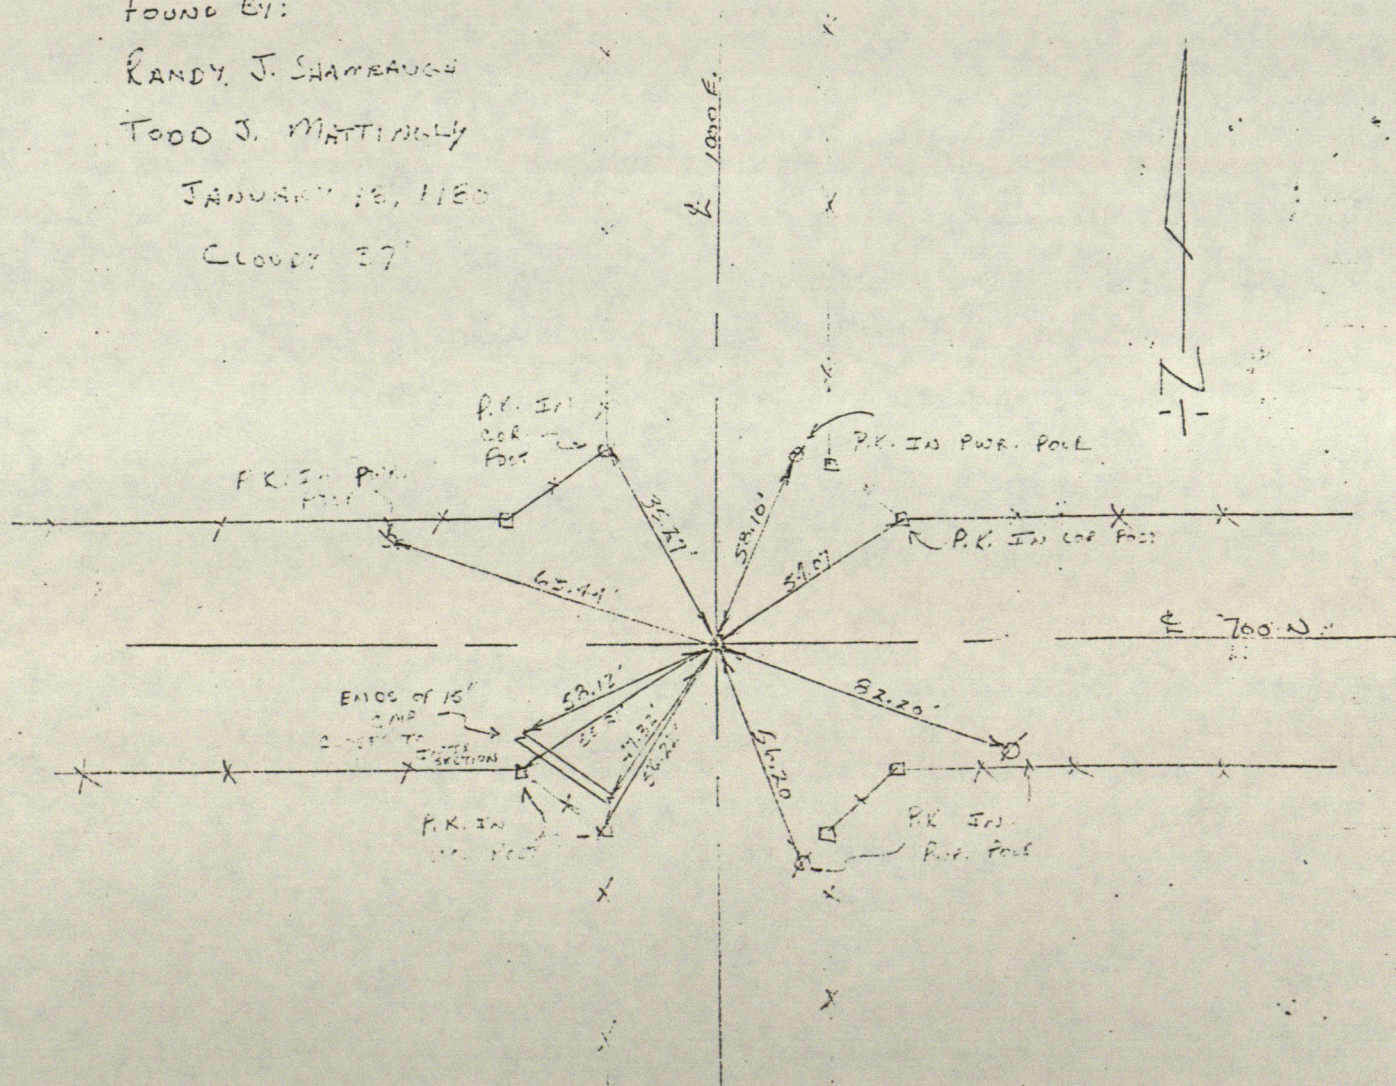

HENDRICKS COUNTY

DESIGNATION OF MARKER SE Cor. Sw 1/4 NE 1/4 SEC. 6 TWP 16 RANGE 2E

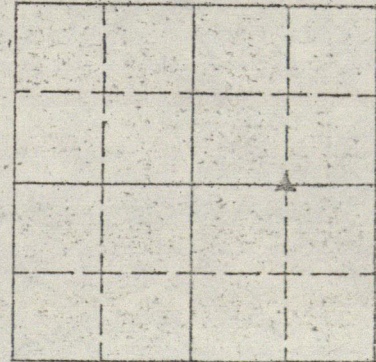
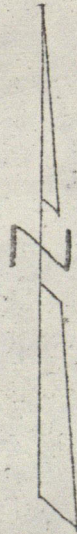
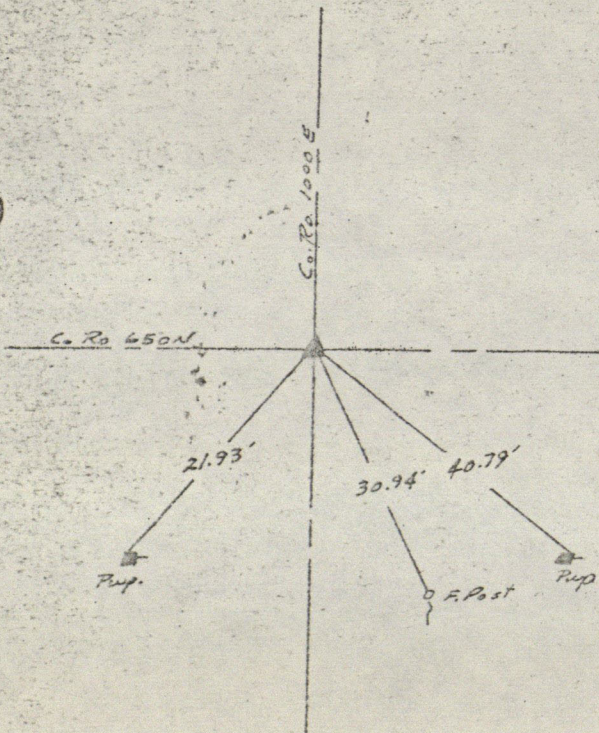


S.E. Cor. S.W 1/4, N.E 1/4, SEC. 6-16-2E

HENDRICKS COUNTY

DESIGNATION OF MARKER NW Cor Sw 1/4 NW 1/4 SEC 6 TWP 16 RANGE 2E

(COR. to E. 1/2 Sec. 6)

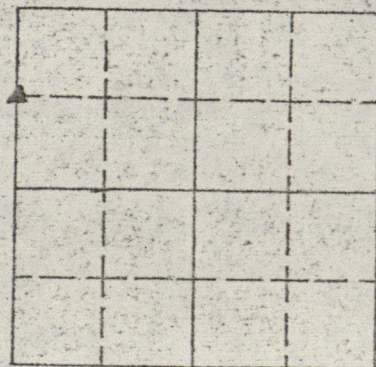
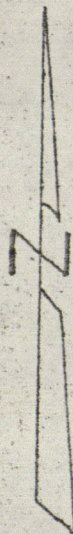
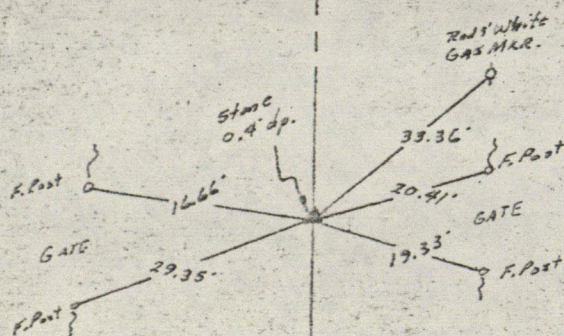


N.W. Cor. S.W. 1/4, N.W. 1/4, SEC 6-16-2E

11-8-67
D.D.W.

HENDRICKS COUNTY

DESIGNATION OF MARKER NE Cor. NW 1/4 NE 1/4 SEC 6 TWP 16 RANGE 2E

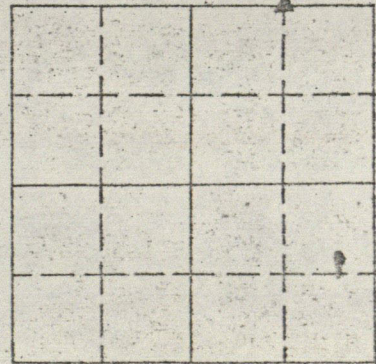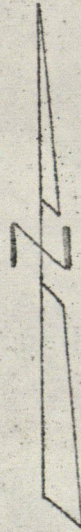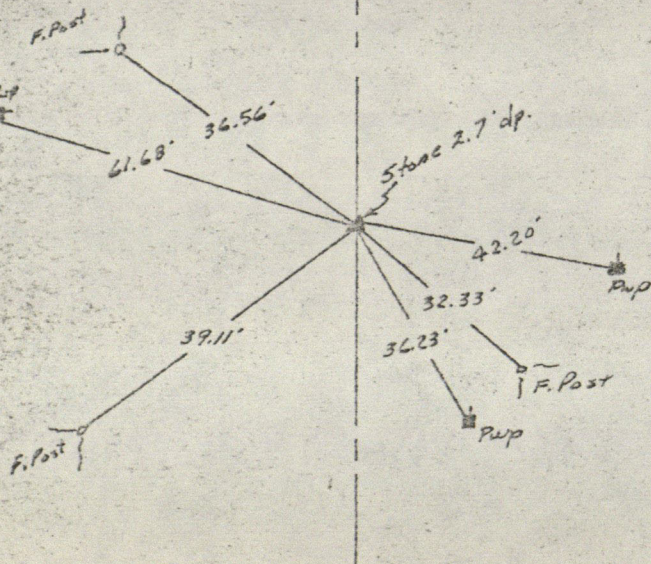




N.E. Cor. N.W. 1/4, NE 1/4, SEC. 6-16-2E

11-15-67
DDW

HENDRICKS COUNTY

DESIGNATION OF MARKER NW Cor

SEC 6 TWP 16 RANGE 2E

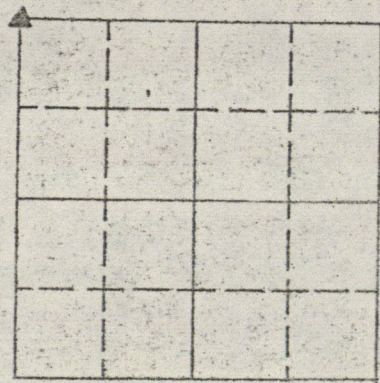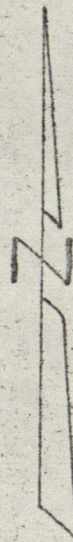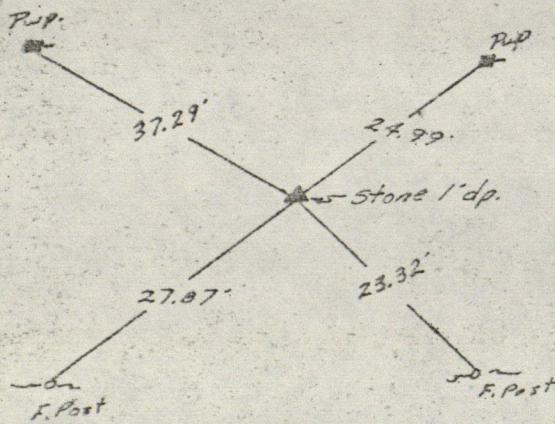

N.W. COR., SEC. 6-16-2E

11-15-67
DDW

SEC. 6-16N-2E N.E. CORNER

STONE FOUND

STONE WAS FOUND 8" BELOW

ROAD SURFACE AND MEASURED

10' X 7' X 6'. ROUND SHAPE WITH

HIGH POINT ON TOP. WE ALSO


FOUND A $\frac{1}{2}$ " DIA. RE-BAR DRIVEN

IN BESIDE STONE & BENT OVER

SIDE OF STONE. REPLACED RE-BAR WITH R.R. SPK. OVER

HIGH POINT ON STONE. STONE WAS ALSO 1.5' N. OF

CENTERLINE OF C.R. 700 N.

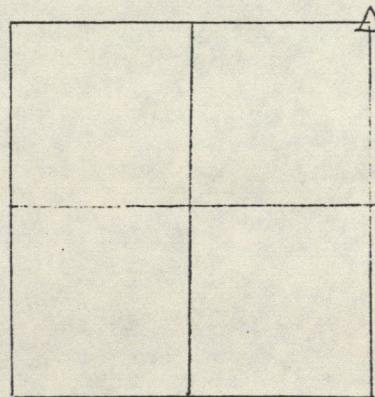

N

FOUND BY:

RANDY J. SAMBACH

TED J. MATTINGLY


JANUARY 21, 1980

CORNER 28'

NOTE: THESE

ARE THE ONLY
TIES WE COULD TAKE

R/W FENCE

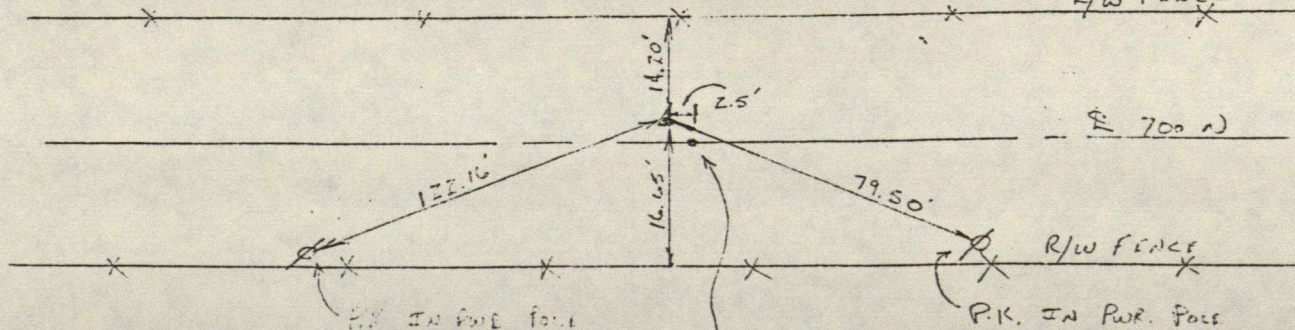

P.K. PERMANENTLY SET

BY WILLARD JOHNSON



RECORD OF CORNER

LOCATION OF MONUMENT: SECTION 6, T. 16 N., R. 2 E.

Found: ☒ Set: Depth: Pipe buried; disk flush
Standard Hendricks County disc on rebar
set over S. M. Shartle's 1977 pipe - no stone

Description:

Bearings to reference objects are magnetic unless a contrary mode is shown.

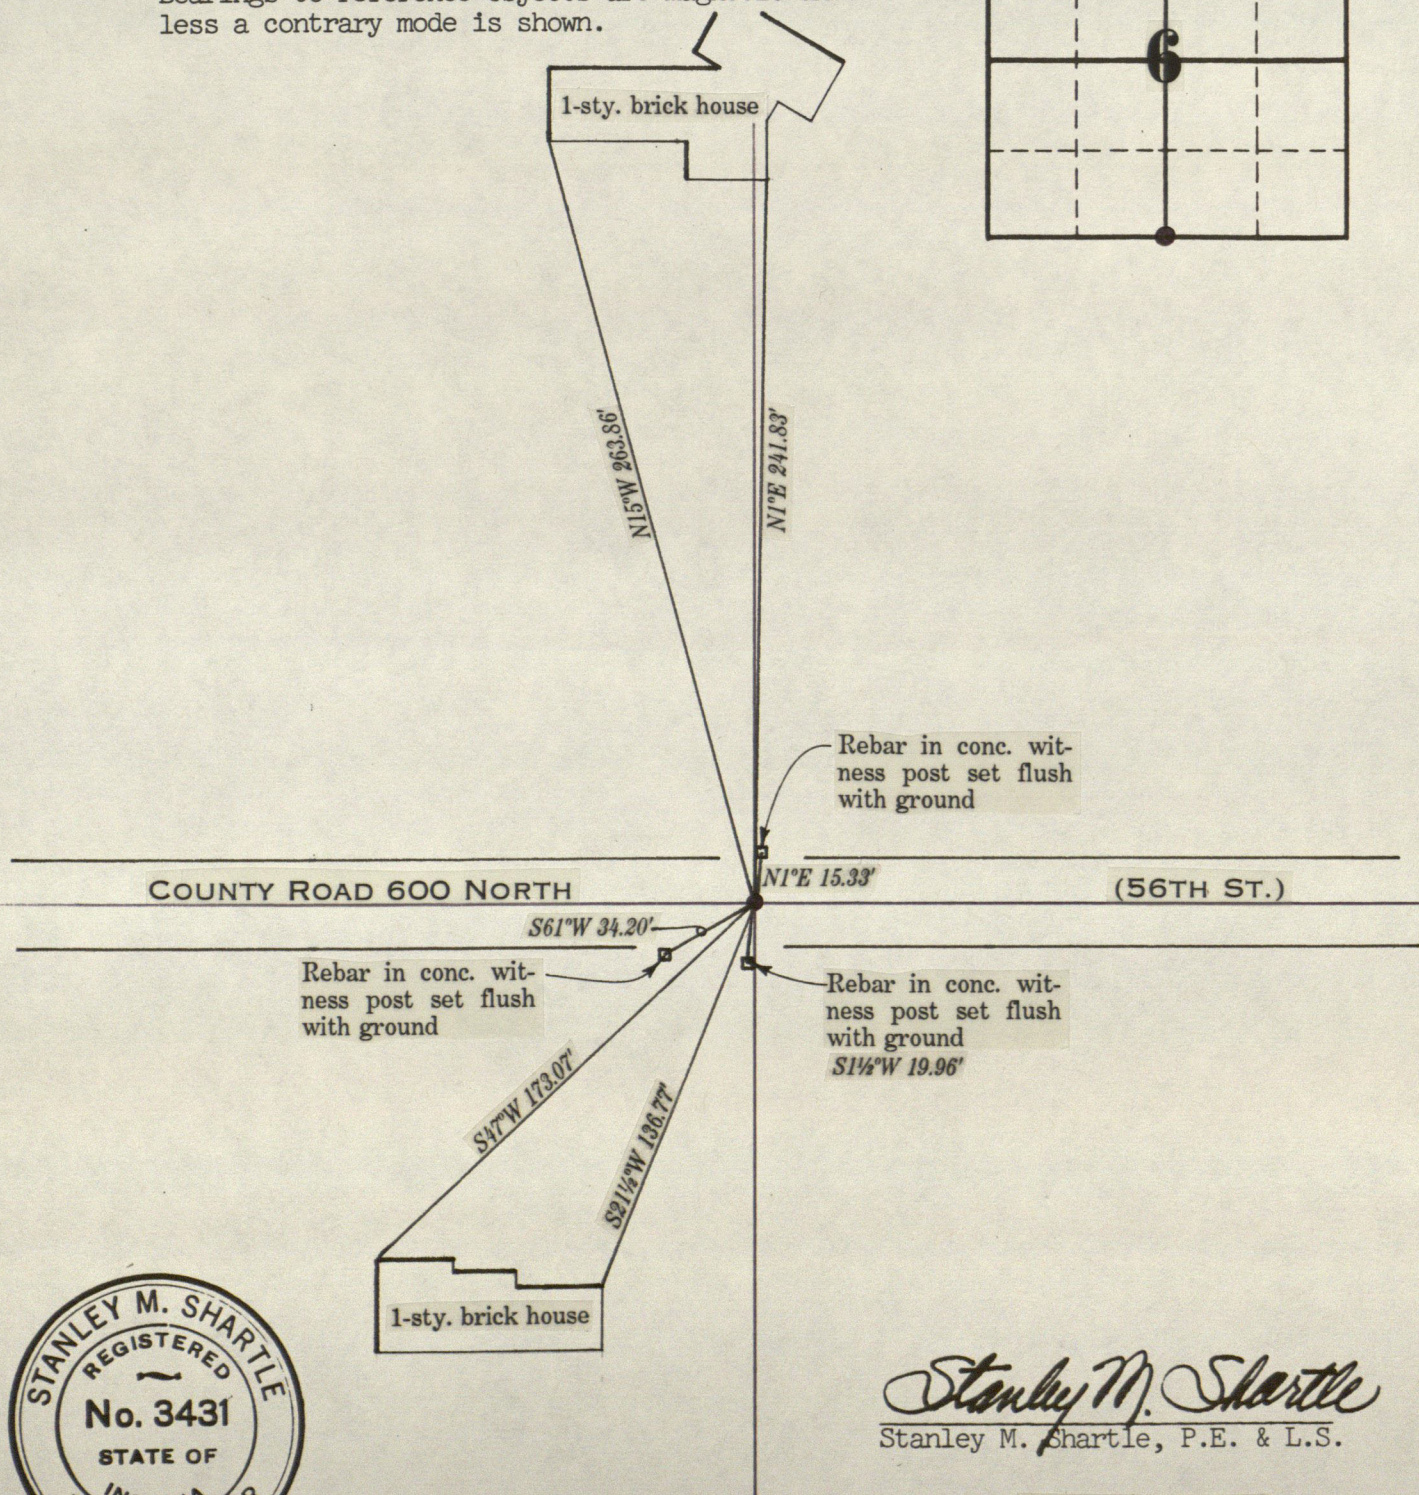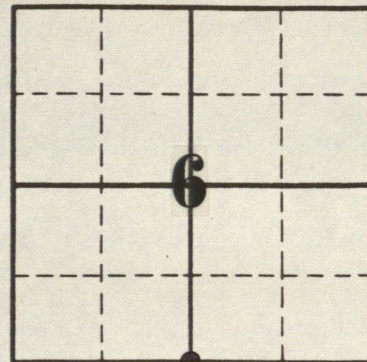

Stanley M. Shartle
Stanley M. Shartle, P.E. & L.S.



Date: November 9, 1992

TRI-Pod

DATE 10-28-92

Sec. 6-16-2E Hend. Co. TN.

1977 Shatttle Pipe FD.
Hend. Co. Disc. set over
Shatttle Pipe

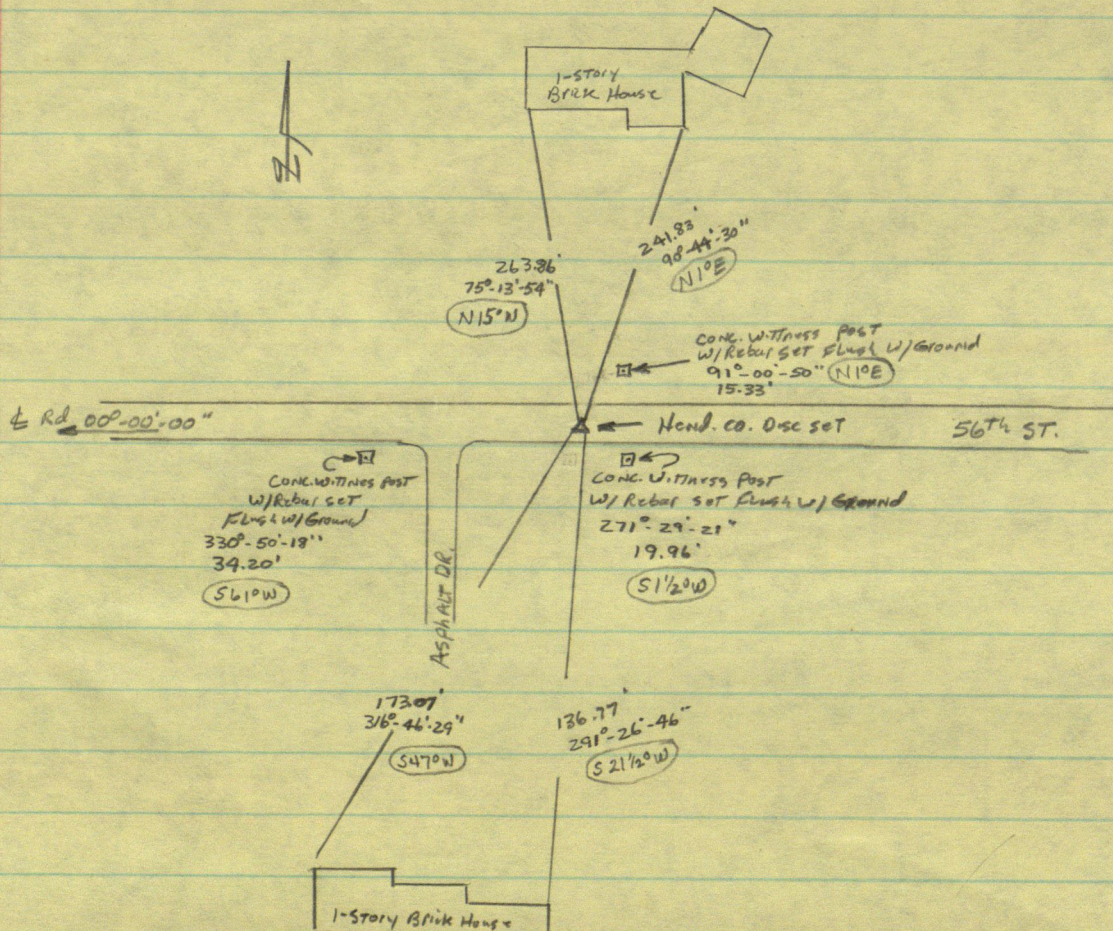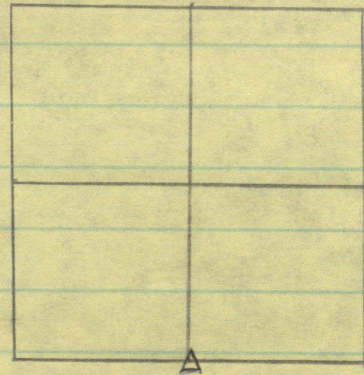

STANLEY M. SHARTLE
REGISTERED PROFESSIONAL ENGINEER
RURAL ROUTE 1, BOX 33
STILESVILLE, IND. 46180

LOCATION OF MONUMENT: SECTION 7, T. 16 N., R. 2 E.


Monument found: Yes No ✓

Description: Pipe set

Depth: 2 inches

References taken: July 8, 1977

Comments: Bearings are magnetic

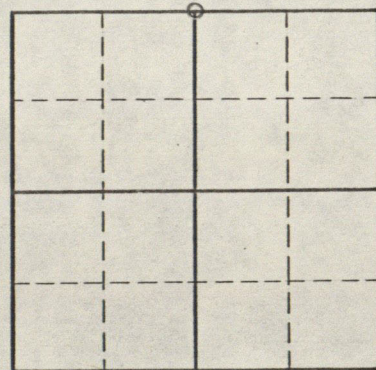

56th Street (Martin Hart Rd.)
Co.Rd. 600 N.

power pole

N82°E 115.62'

S47°W 173.14'

S19°W 160.24'

1-sty. brick

This corner was restored from
Garrison's survey notes of the
Martin Hart Road and physical
evidence on the ground.



Stanley M. Shartle

Stanley M. Shartle, P.E & L.S.

July 15, 1977

Date

RECORD OF CORNER



LOCATION OF MONUMENT: SECTION 7, T. 16 N., R. 2 E.

Found: Set: ☒ Depth: Flush

Description: Harrison Monument

Bearings to reference objects are magnetic unless a contrary mode is shown.

In his 1925 survey of the John W. Tharp Road, County Surveyor George R. Harvey did not find the section corner. He restored the missing corner by driving an iron pin based on the locations of the following corners: the South quarter corner of Section 6, the southwest corner of the East Half of the Southeast Quarter of Section 6, the southeast corner of the West Half of the Southwest Quarter of Section 5, and the South quarter corner of Section 5. His iron

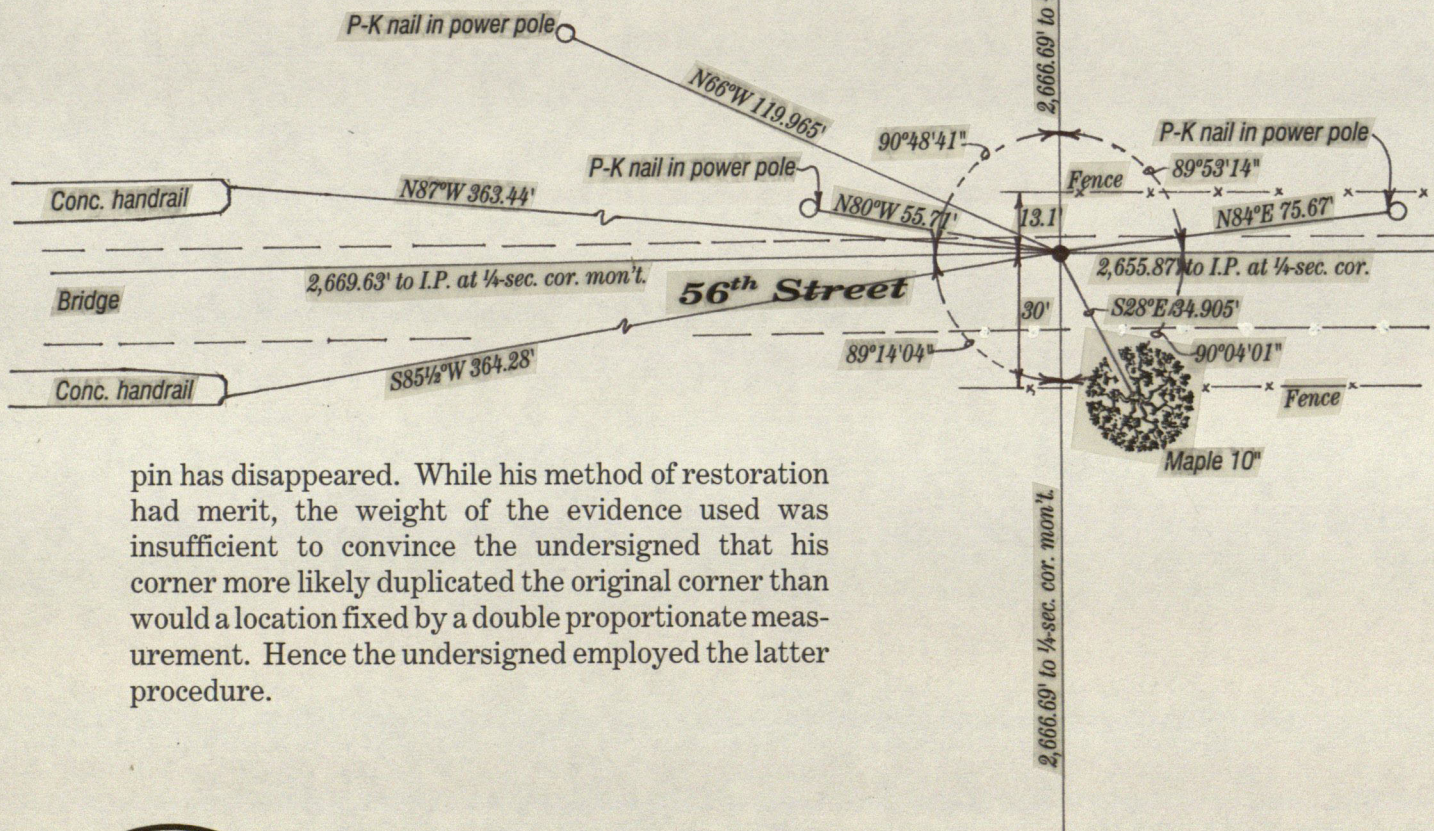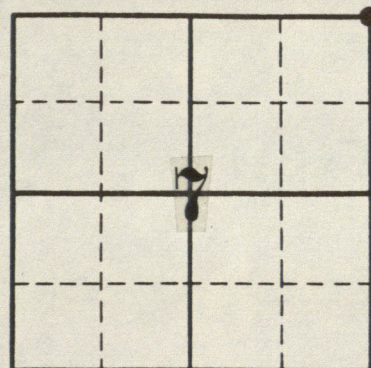

pin has disappeared. While his method of restoration had merit, the weight of the evidence used was insufficient to convince the undersigned that his corner more likely duplicated the original corner than would a location fixed by a double proportionate measurement. Hence the undersigned employed the latter procedure.



Stanley M. Shartle
Stanley M. Shartle, P.E. & L.S.

Date: October 5, 1999

RECORD OF CORNER


LOCATION OF MONUMENT: SECTION 7, T. 16 N., R. 2 E.

Found: Set: ☒ Depth: Flush

Description: Rebar in 5x5x30-inch concrete monument

Bearings to reference objects are magnetic unless a contrary mode is shown.

The stone set by County Surveyor John W. Trotter for this corner was searched for extensively with a backhoe to a depth of nearly four feet without success. After a long study of the local evidence, the corner was restored by a single proportionate measurement.

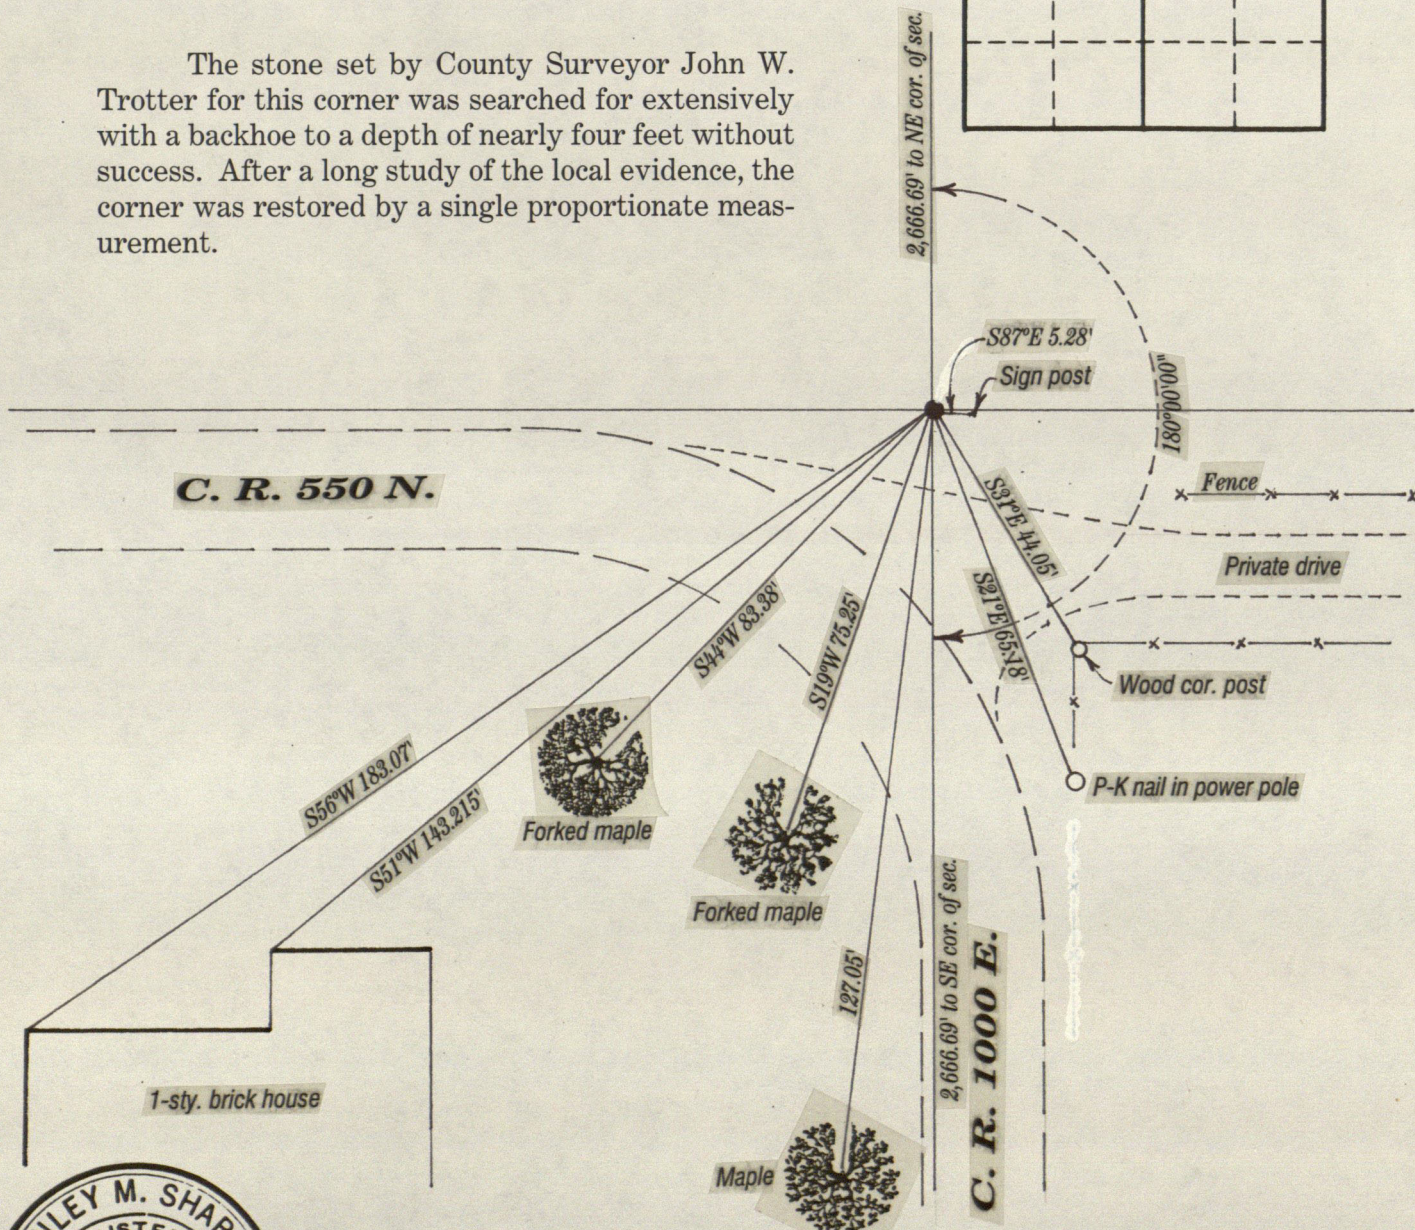

Stanley M. Shartle
Stanley M. Shartle, P.E. & L.S.

Date: October 5, 1999

STANLEY M. SHARTLE
REGISTERED PROFESSIONAL ENGINEER
RURAL ROUTE 1, BOX 33
STILESVILLE, IND. 46180

LOCATION OF MONUMENT: SECTION 7, T. 16 N., R. 2 E.



Monument found: Yes No ✓

Description: Pipe set

Depth: 3 inches

References taken: July 8, 1977

Comments: Bearings are magnetic

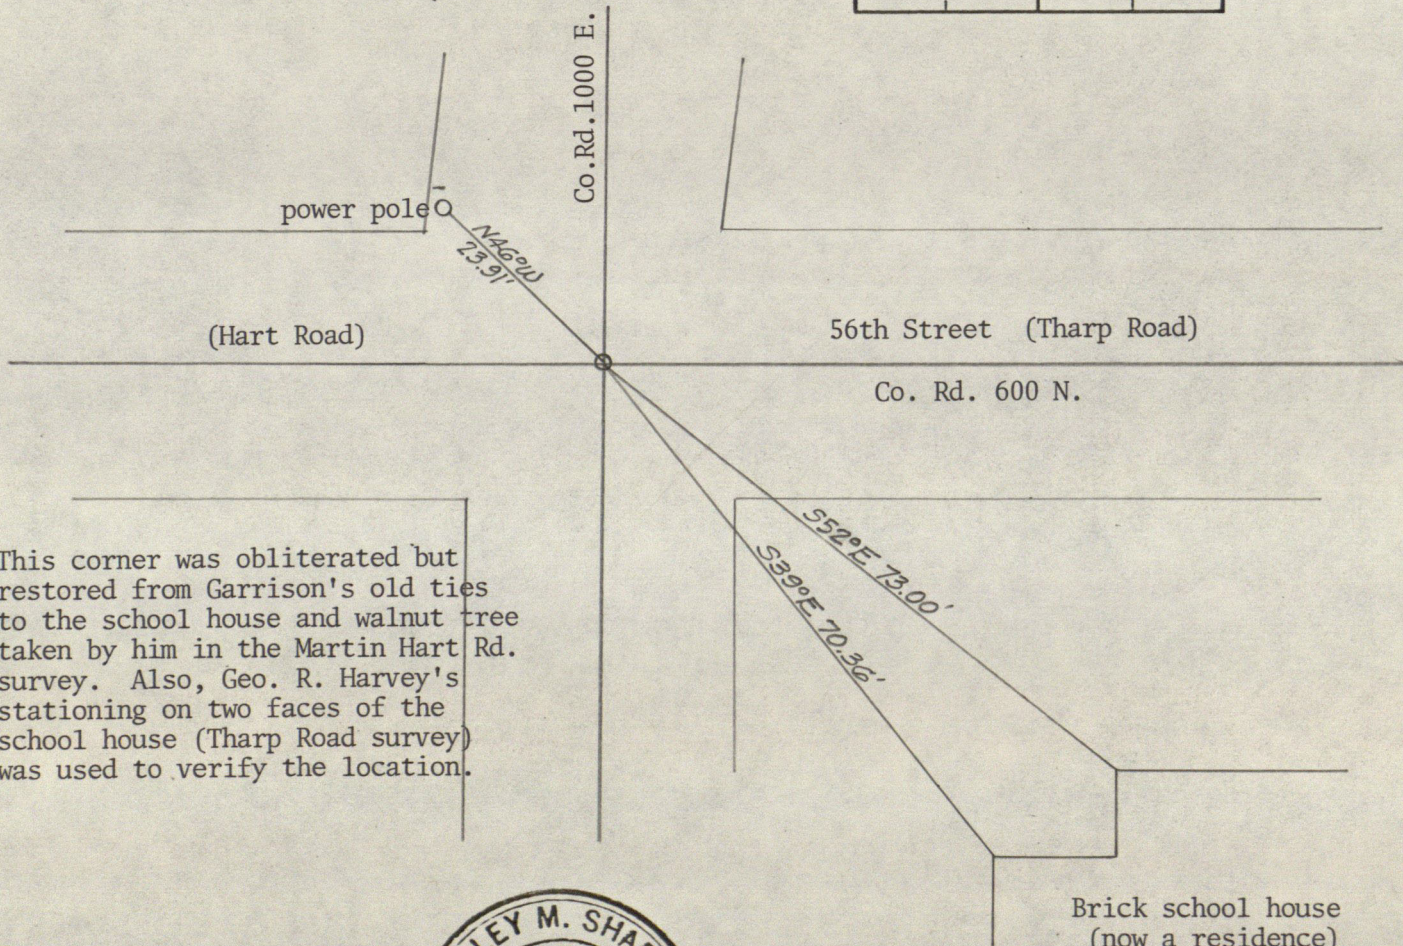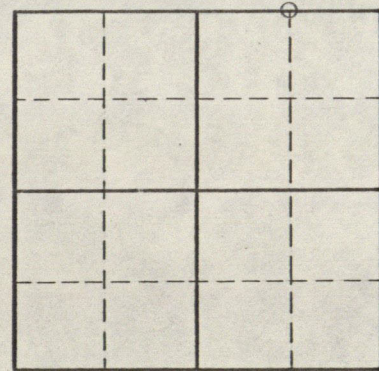

This corner was obliterated but restored from Garrison's old ties to the school house and walnut tree taken by him in the Martin Hart Rd. survey. Also, Geo. R. Harvey's stationing on two faces of the school house (Tharp Road survey) was used to verify the location.



Stanley M. Shartle

Stanley M. Shartle, P.E & L.S.

July 15, 1977

Date

STANLEY M. SHARTLE
REGISTERED PROFESSIONAL ENGINEER
RURAL ROUTE 1, BOX 33
STILESVILLE, IND. 46180

LOCATION OF MONUMENT: SECTION 7, T. 16 N., R. 2 E.



Monument found: Yes ☐ No ☒

Description: Railroad spike set

Depth: Flush with road surface

References taken: July 8, 1977

Comments: Bearings are magnetic

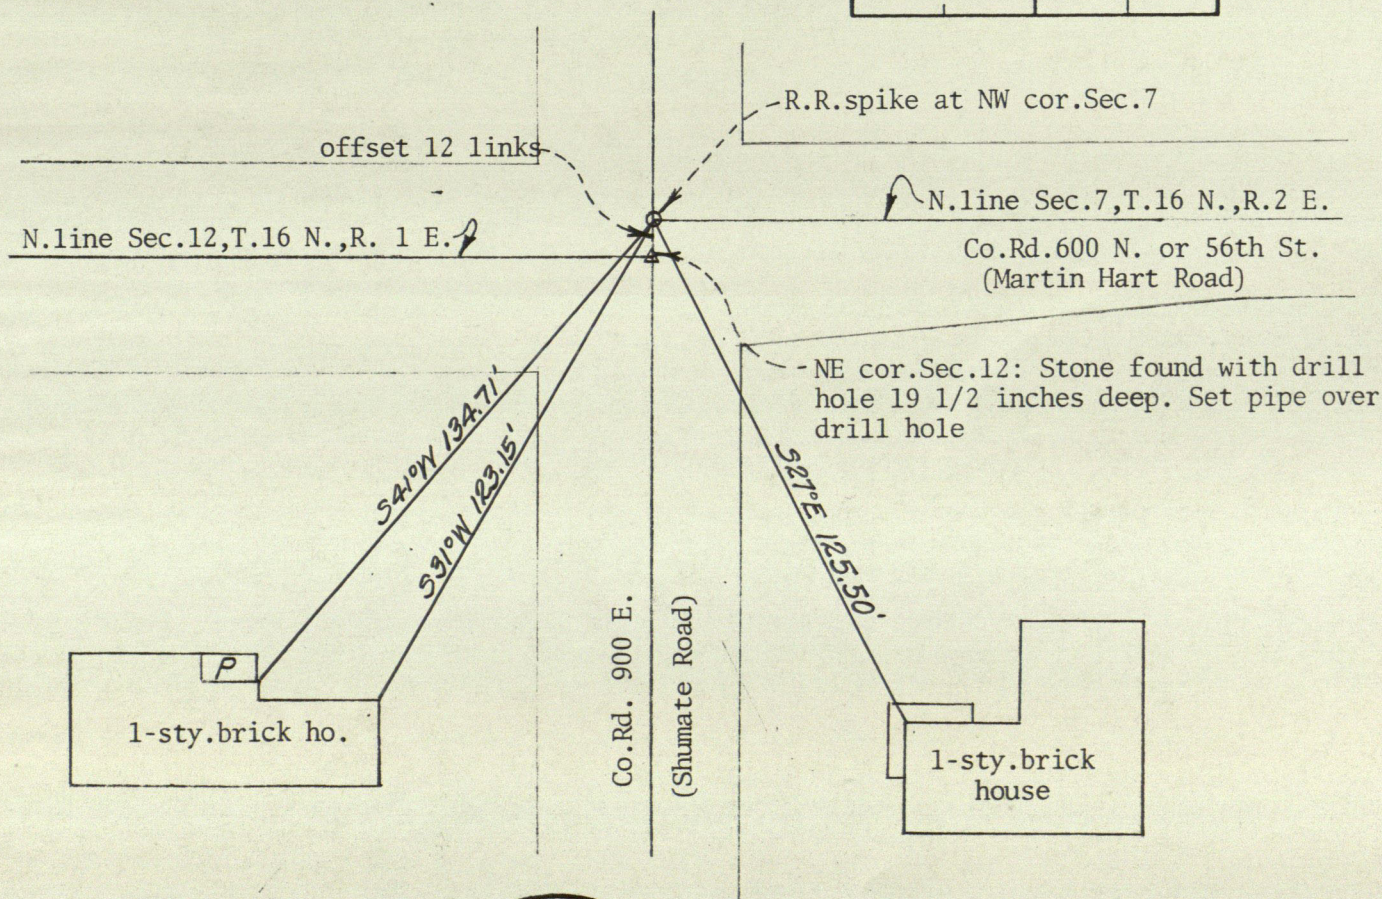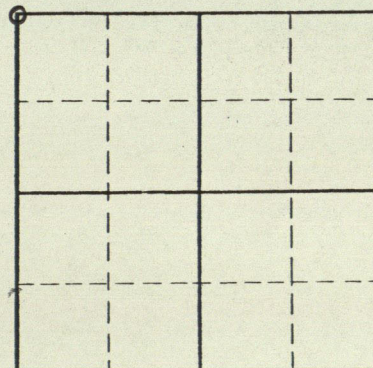

Stanley M. Shartle

Stanley M. Shartle, P.E & L.S.

July 15, 1977

Date

RECORD OF CORNER



LOCATION OF MONUMENT: SECTION 8, T. 16 N., R. 2 E.

Found: ☒ Set: ☐ Depth: ☐

Description: ☐ See below ☐

Bearings to reference objects are magnetic unless a contrary mode is shown.

Marion County standard 4" cast iron marker found. Nearby granite stone lying on the ground may be the old corner stone now replaced by the marker.

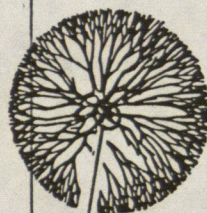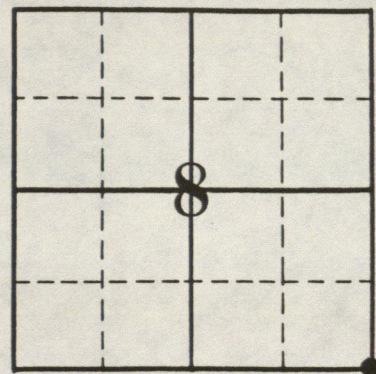

Oak 54"

Rebar in conc. witness post set flush with ground

N10°E 47.90'
N3°W 16.60'

Ancient fence (poor condition)

16.30'

16.60'

Rebar in conc. witness post set flush with ground

Rebar in conc. witness post set flush with ground

HENDRICKS COUNTY

MARION COUNTY

COUNTY LINE



Stanley M. Shartle
Stanley M. Shartle, P.E. & L.S.

Date: November 9, 1992

RECORD OF CORNER



LOCATION OF MONUMENT: SECTION 8, T. 16 N., R. 2 E.

Found: ☒ Set: ☐ Depth:

Description: See below

Bearings to reference objects are magnetic unless a contrary mode is shown.

Marion County standard 4" cast iron marker found. Nearby granite stone lying on the ground may be the old corner stone now replaced by the marker.

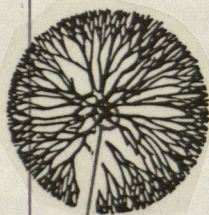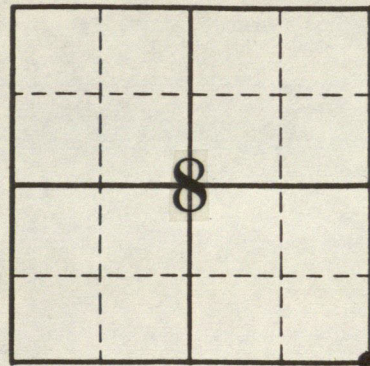

Oak 54"

Rebar in conc. witness post set flush with ground

N 3° W 16.60'

N 10° E 47.90'

Ancient fence (poor condition)

16.30'

16.60'

Rebar in conc. witness post set flush with ground

Rebar in conc. witness post set flush with ground

HENDRICKS COUNTY

MARION COUNTY

COUNTY LINE






Stanley M. Shartle
Stanley M. Shartle, P.E. & L.S.

Date: November 9, 1992

TRI-Pod



DATE 10-6-92

Sec. 8-16-2E Hend. Co. IN.

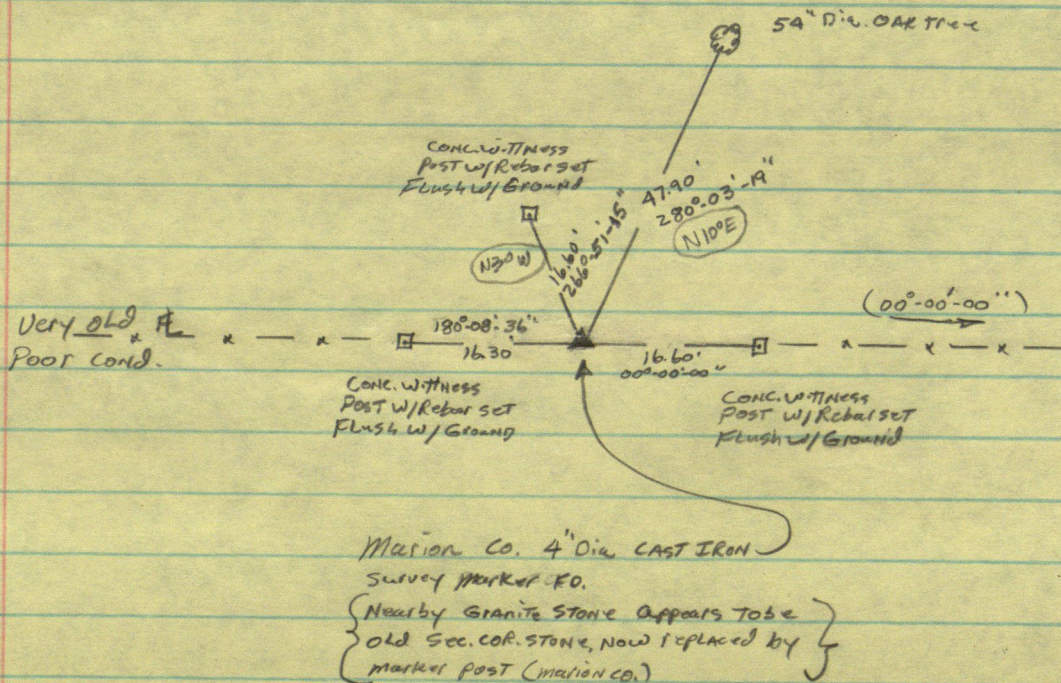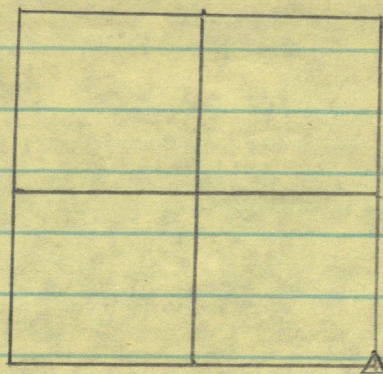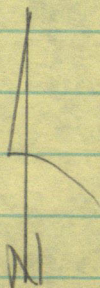

HENDRICKS COUNTY

DESIGNATION OF MARKER $W\frac{1}{2}$ mile SEC 8 TWP 16 RANGE 2E

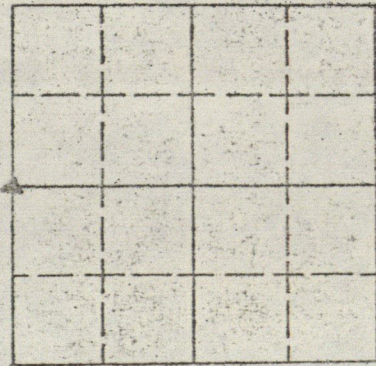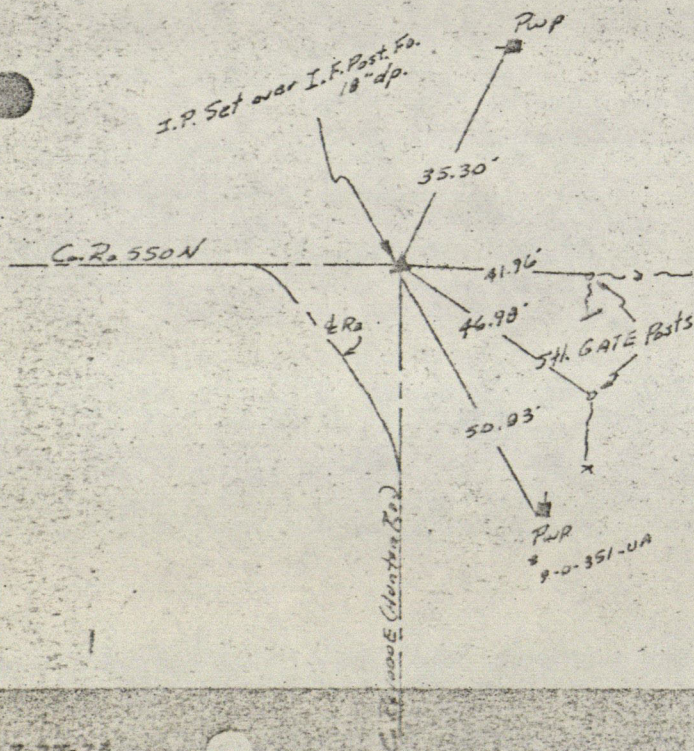

$W\frac{1}{2}$ Mile, SEC. 8-16-2E



RECORD OF CORNER

LOCATION OF MONUMENT: SECTION 8, T. 16 N., R. 2E

Found: Set: ☒ Depth: Flush

Description: Standard county disk mounted on a #6 rebar

Bearings to reference objects are magnetic unless a contrary mode is shown.

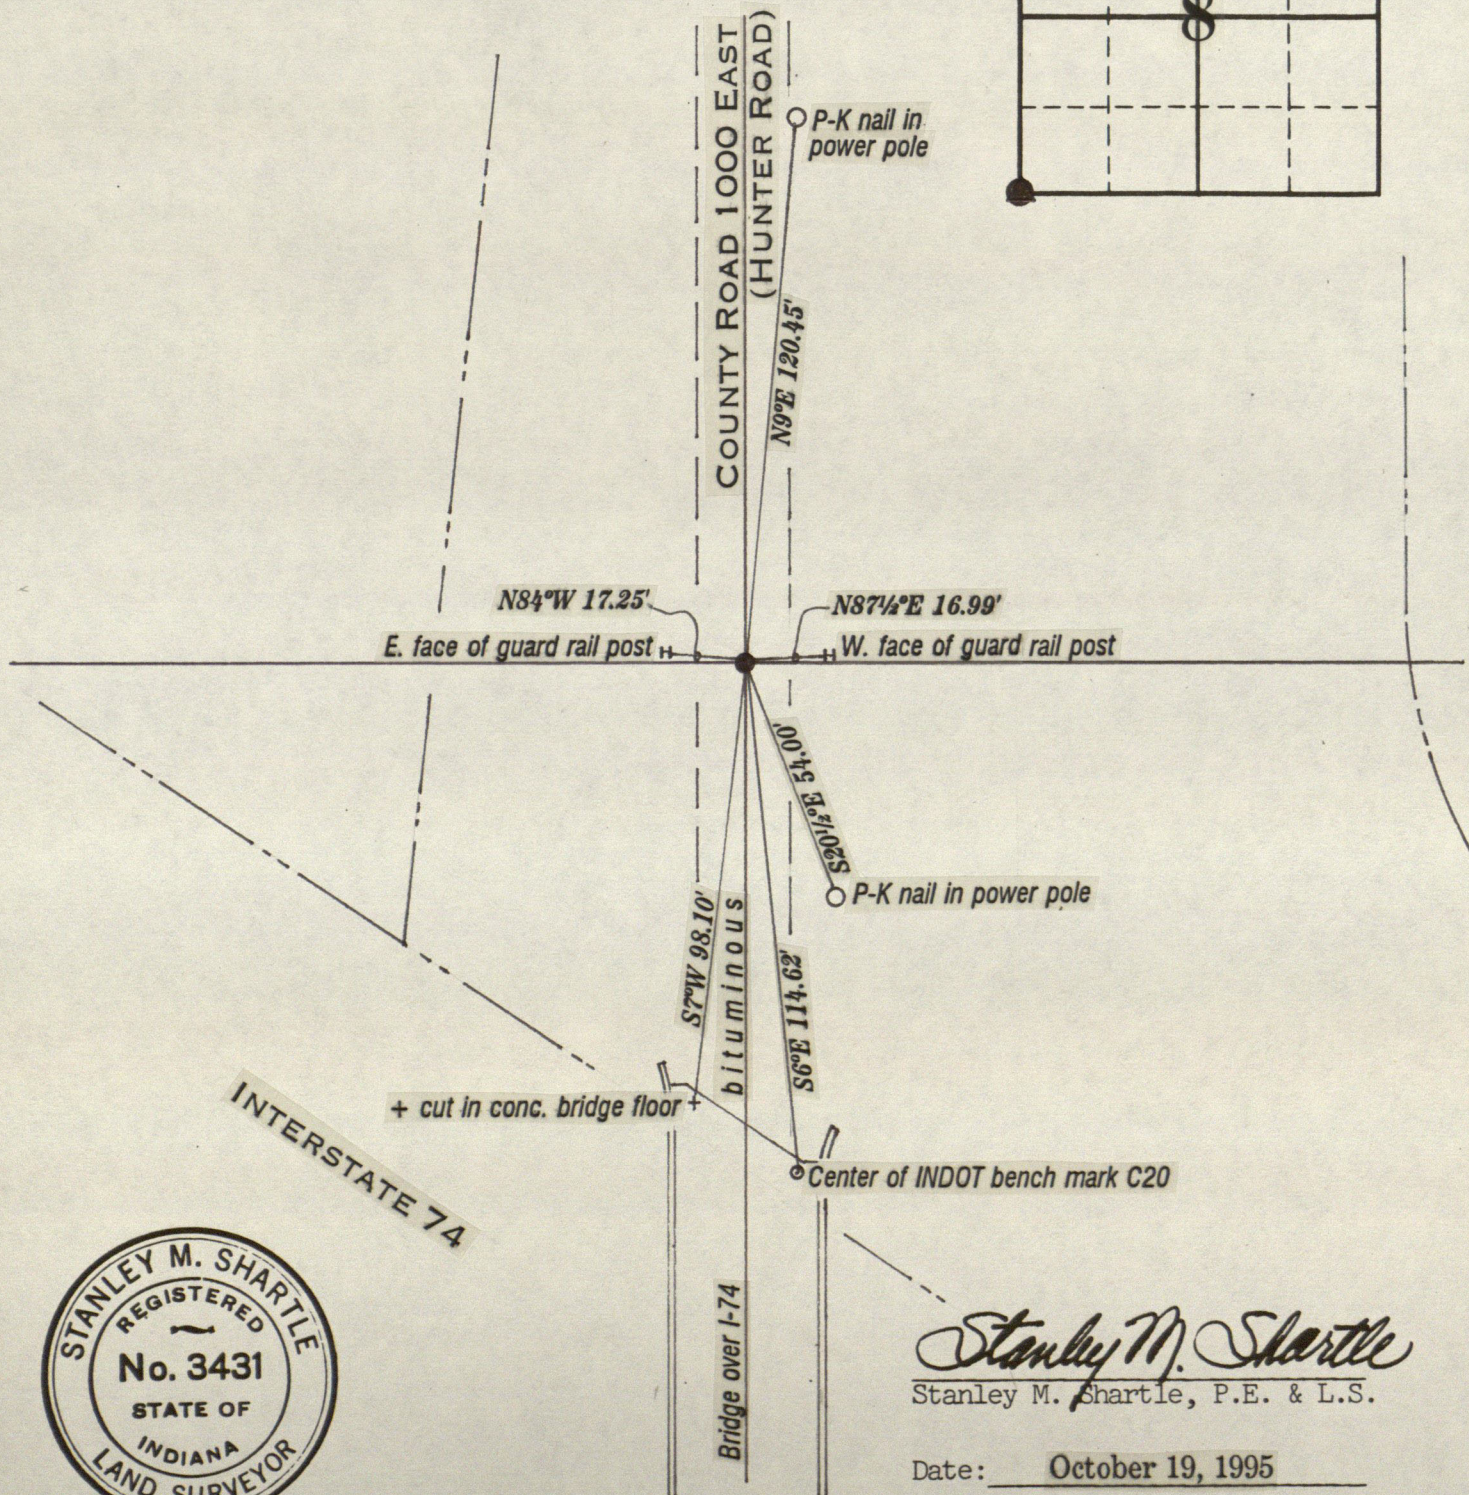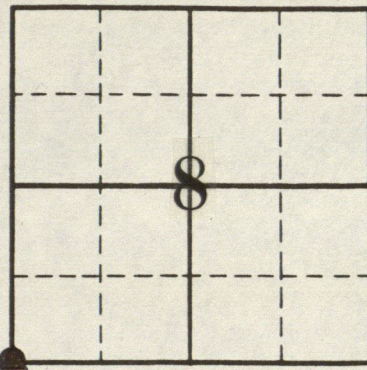

Stanley M. Shartle
Stanley M. Shartle, P.E. & L.S.

Date: October 19, 1995

RECORD OF CORNER


LOCATION OF MONUMENT: SECTION 8, T. 16 N., R. 2 E.

Found: ☒ Set: ☐ Depth: ☐ See below ☐

Description: ☐ See below ☐

Bearings to reference objects are magnetic unless a contrary mode is shown.

Gov. Surveyor John McDonald's random from the northwest corner of the section intersected 25 links north of the section's northeast corner. He intended to move his temporary quarter corner south $12\frac{1}{2}$ links to place it on the true line. Instead, he seems to have inadvertently set it north that amount. Co. Surveyor George R. Harvey, in surveying the John W. Tharp Road about 1925, failed to find a stone. He restored the corner and set an iron pin using a point in such close agreement with the road and fences as to constitute the best available evidence of the former place of the original monument. A good search in 1997 proved no stone exists despite Garren Jones's references of July 26, 1973. Instead, Harvey's iron pin (actually a $\frac{5}{8}$ x18-inch bolt) was found and used. This survey replaced it with a 24-inch rebar topped with a standard county disk set a road level.

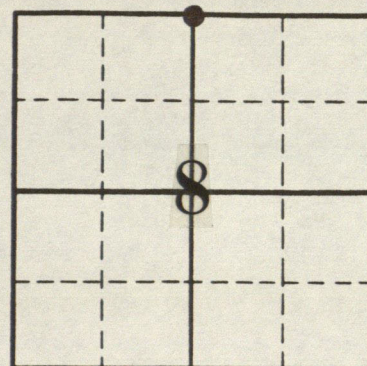

The Church of Jesus
Christ of Latter-Day
Saints

13th brick up

Bit. drive

N87°E 140.09'

N78°E 92.725'

Magnetic nail with washer
in power pole 1' up

Magnetic nail with washer
in power pole 2' up

N82½°W 121.55'

C. R. 600 N.


(56TH ST.)

S44°E 72.17'

Conc. foundation

Gravel drive

1-sty. frame
house

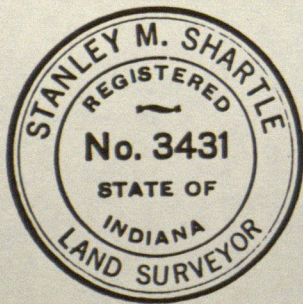


Stanley M. Shartle
Stanley M. Shartle, P.E. & L.S.

Date: November 3, 1997

HENDRICKS COUNTY

DESIGNATION OF MARKER E 1/2 mile SEC 8 TWP 16 RANGE 2E

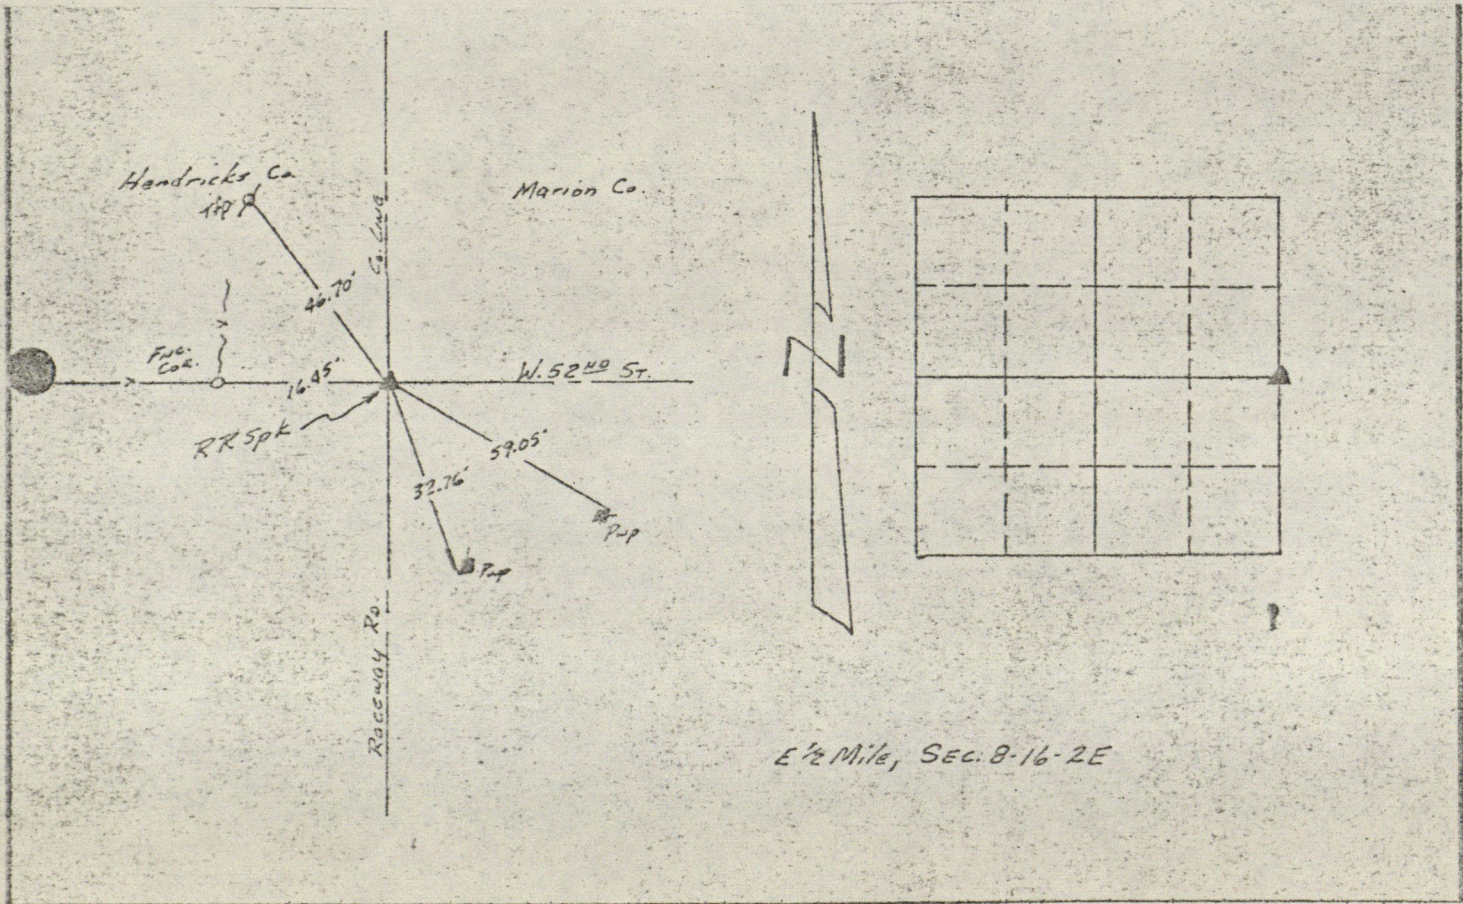

OFFICE OF THE MARION COUNTY SURVEYOR

SECTION RECORD CORNER

SECTION 9 TOWNSHIP 16 RANGE 2

DATE: 6-13-95

PARTY CHIEF: Greene

CREW: _____

TYPE OF MARKER: Harrison


METHOD OF ESTABLISHMENT: History

IN. S.P.C. E ZONE, NAD 83.

NAME: 16020904

N: 510475.2180(m)

E: 43421.9110(m)

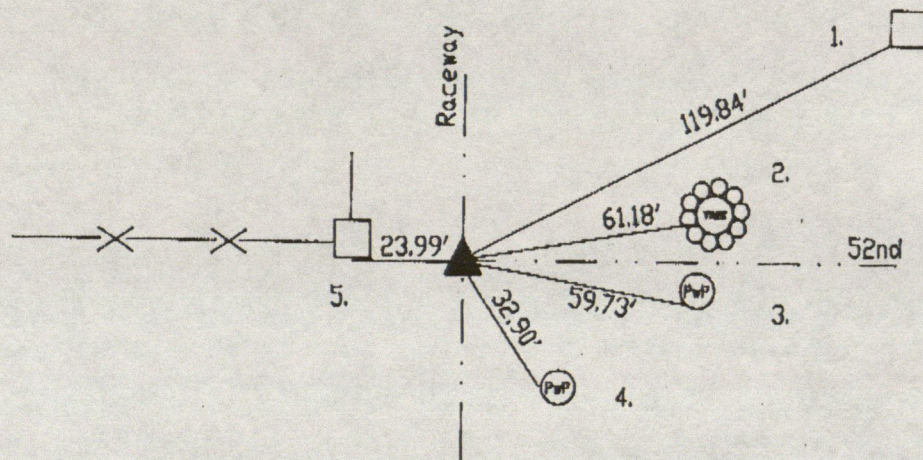

Set 1820 by Laughlin with witnesses: 10' sugar S 80 W 10 links, 12' ash N 67 E 26 links M C Atlas pg.3. Surveyed by Smith 1889 but no mention of stone set or witnesses. 8-23-56 Monroe called stone, 9-26-74 McLand called RR dn 2'. 8-25-81 Green called RR over stone. 9-10-86 Greene called same, 6-11-90 excavated RR fd surface w/ stone dn 14' w/ 'x'. Harrison set. Re-tied 6-13-95.



HC620904

REF.	DISTANCE	DESCRIPTION
1.	119.84'	SW frame house
2.	61.18'	PK W 20' maple 15'up
3.	59.73'	PK in bottle cap SW PWP#37-351W
4.	32.90'	PK W PWP#4-501 16'up
5.	23.99'	PK S wooden f.p. 12'up

OFFICE OF THE MARION COUNTY SURVEYOR
 SECTION RECORD CORNER
 SECTION 9 TOWNSHIP 16 RANGE 2
 DATE: 6-8-99
 PARTY CHIEF: Kiste
 CREW: _____
 TYPE OF MARKER: PK nail at surface
 METHOD OF ESTABLISHMENT: County: 2-8-93

IN. S.P.C. E ZONE, NAD 83

NAME: 16020901
 N: 511289.8650(m)
 E: 43415.8044(m)

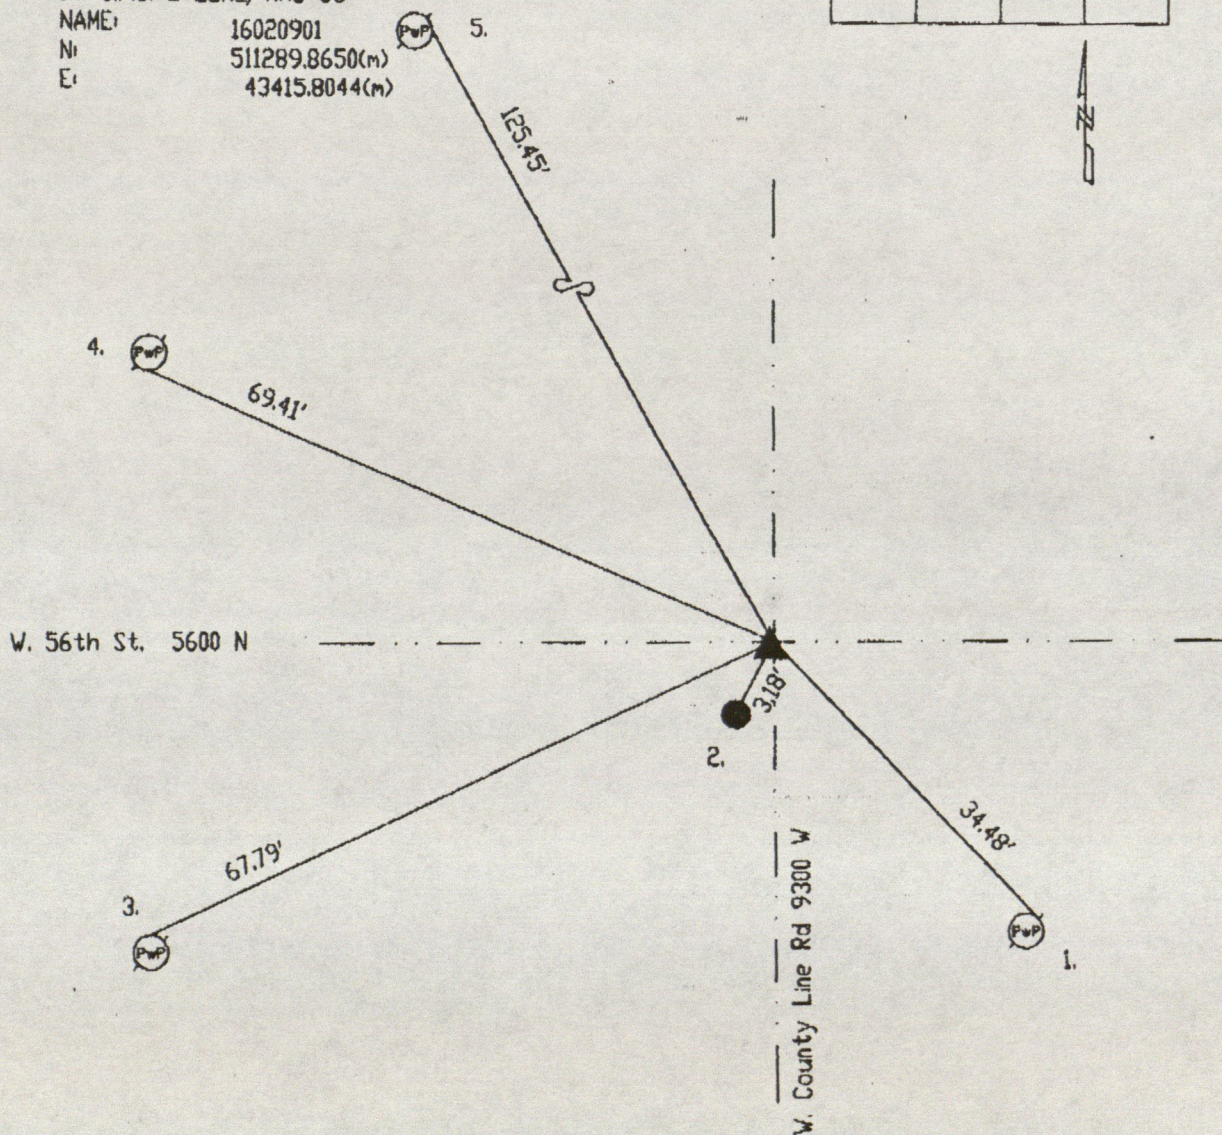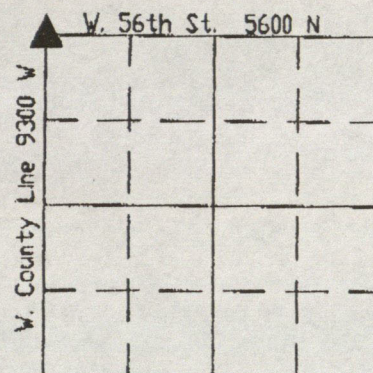

SC620901

REF.	DISTANCE	DESCRIPTION
1.	34.48'	PK nail NE PwP#18-321WB 6'up
2.	3.18'	PK nail in photo mark
3.	67.79'	PK nail N PwP#7-321VA 10'up
4.	69.41'	Found PK nail S PwP no# 8'up
5.	125.45'	Found #41 date nail E PwP#41-321VA 18'up


[illegible]

CORNER RECORD

OFFICE OF THE MARION COUNTY SURVEYOR

SECTION 5 TOWNSHIP 16 RANGE 2

REMARKS

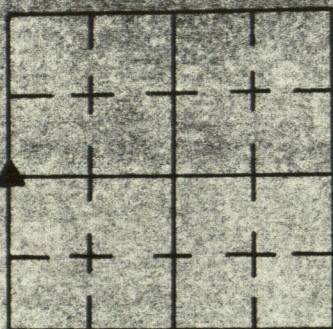

NAIL IN BOTTLE
CAP. S. SIDE
FENCE CORNER
POST-18" UP

16.46'

ROAD
MARION COUNTY LINE

6" UP FOUNDATION

1 STORY
FRAME HOME
5209

6" UP
FOUNDATION

POTTERS PIKE 2 LN ASPH. PAV.

NAIL IN BOTTLE
CAP. N.E. SIDE
RWP# 36-351 WA
16" UP


FOUND R.R. SPIKE
(2" DOWN)

PK NAIL
CAP. S. SIDE
RWP# 36-351 WA
12" UP

L. HOWE
J. MCCLAND
M. SPELMAN
K. HYLDEN
1-23-15

407

METHOD of ESTABLISHMENT: MIO STATES

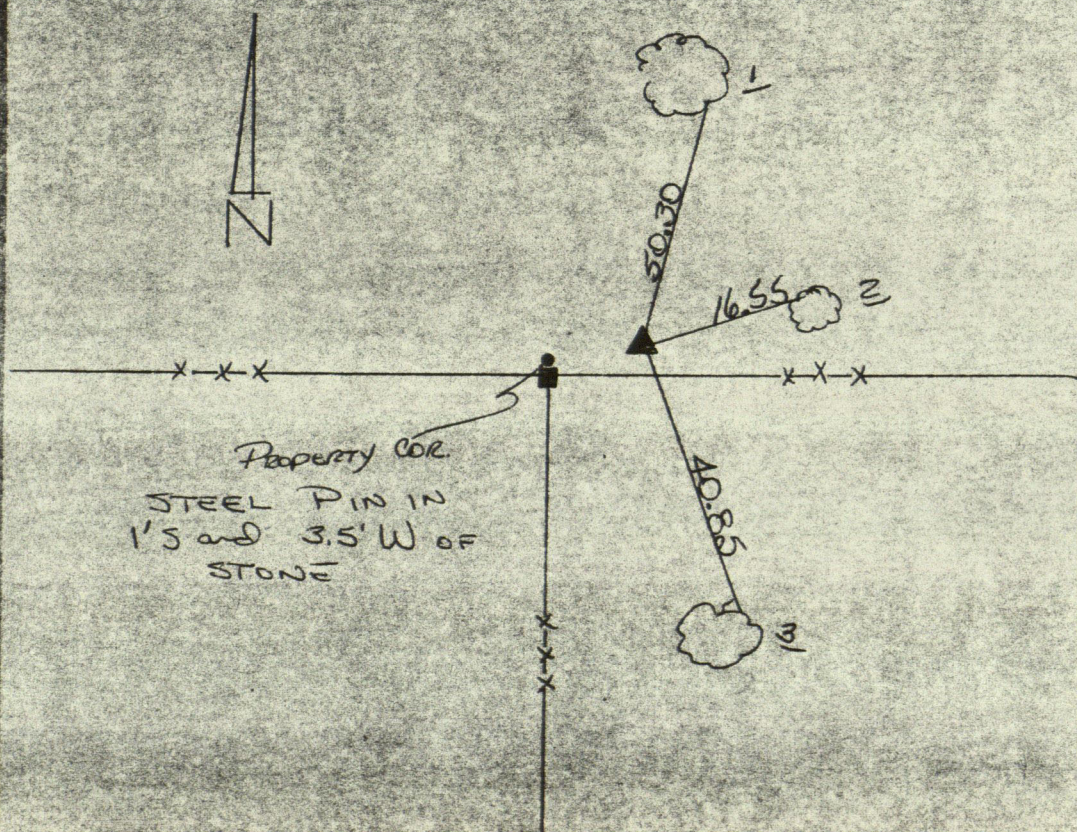[illegible]

SECTION CORNER RECORD MARION COUNTY, INDIANA

Sec. 16 T. 16 R. 2



DATE: 4/8/75

CREW: P.C. - Miller - McLand - Hylden

Inst - _____ Rod - _____

TYPE of MARKER Brass Plug in Conc. Cond of MARKER: Good

METHOD of ESTABLISHMENT: County Ties Per 10-19-59

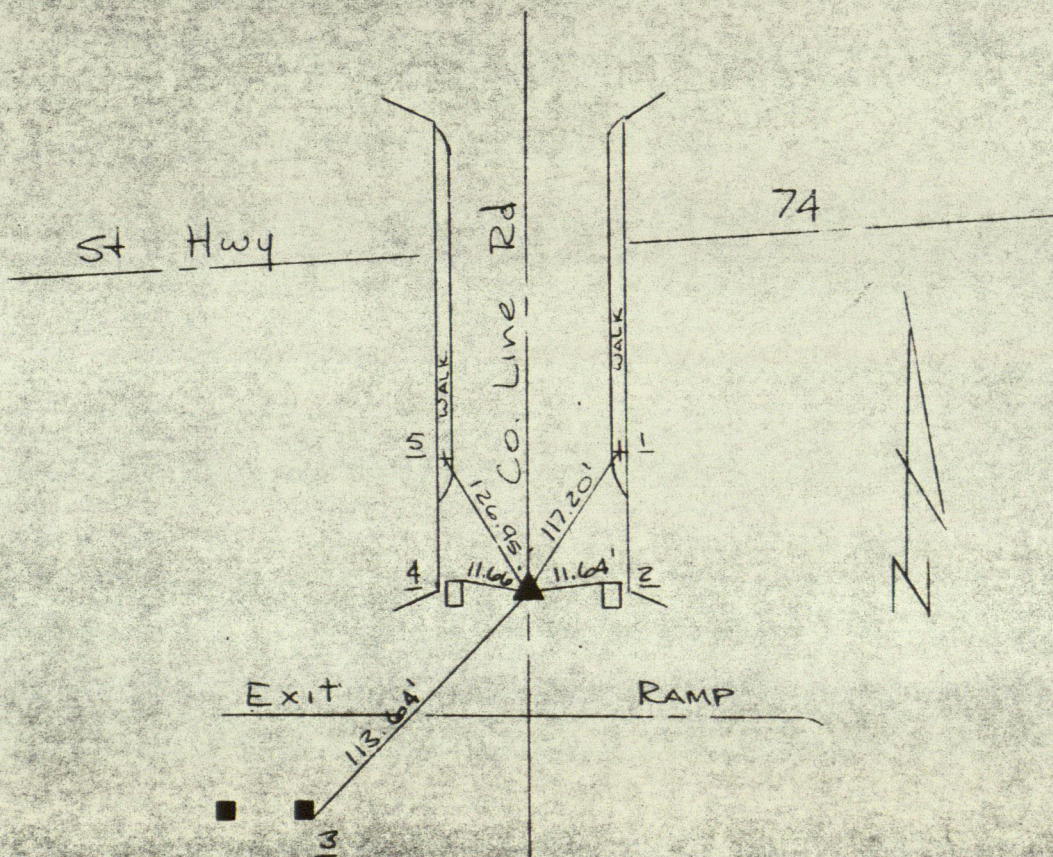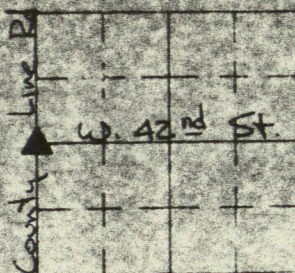

REFERENCE	DISTANCE	DESCRIPTION
1	117.20'	Cut 'x' in East Walk of Over-Pass
2	11.64'	NW Corner of Inlet to East
3	113.64'	RD Nail in SE Corner of E. Sign Post
4	11.66'	NE Corner of West Inlet
5	126.95'	Cut 'x' in West Walk of Over-Pass

RECORD OF CORNER



LOCATION OF MONUMENT: SECTION 17, T. 16 N., R. 2 E.

Found: ☒ Set: ☐ Depth: See below

Description: See below

Bearings to reference objects are magnetic unless a contrary mode is shown.

A 3x5-foot hole was excavated but only a 1/2" diameter pipe was found. The preponderance of the evidence examined at the site indicates that the pipe is more likely than not to be at the location of the corner as originally established. Set a No. 6 rebar with standard county disk at the road surface over the pipe.

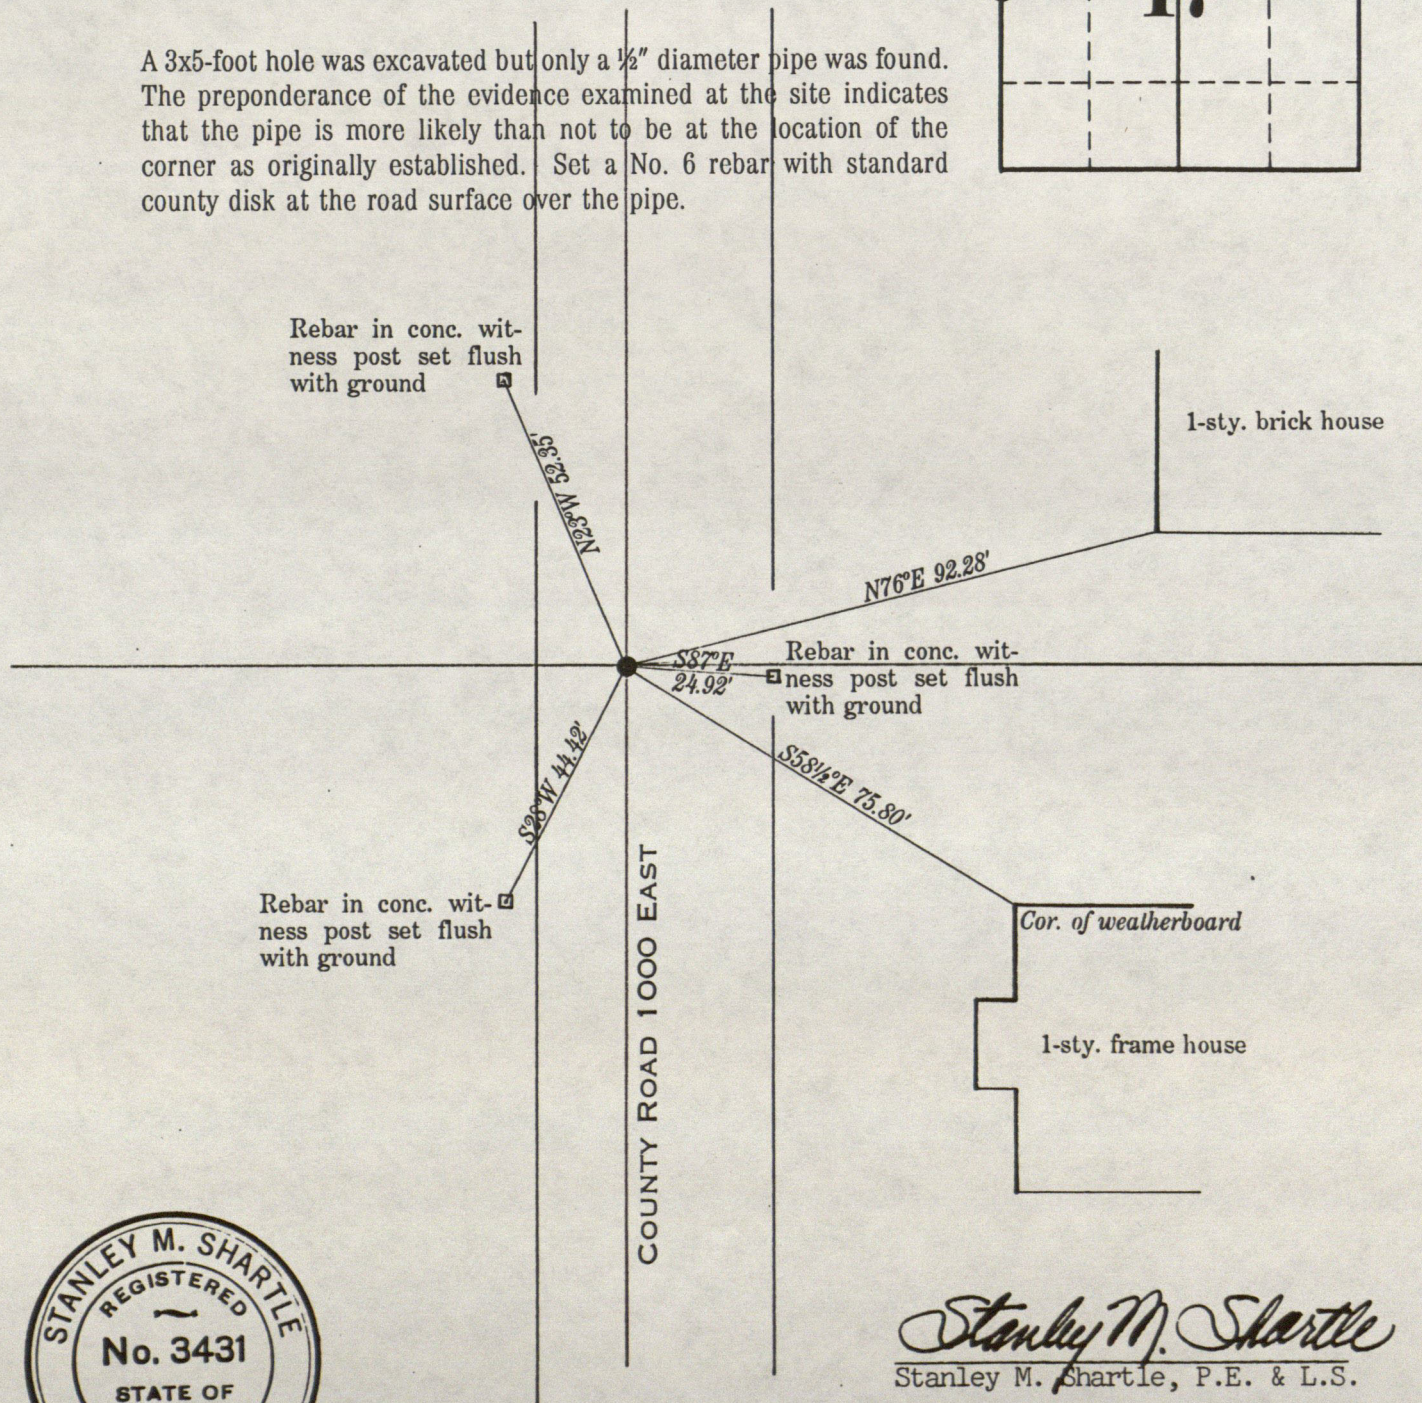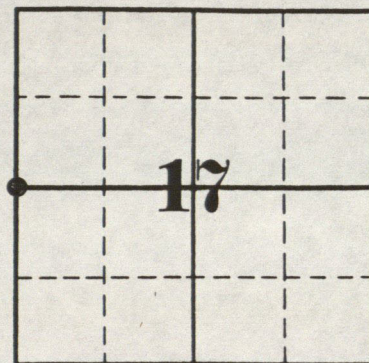

Stanley M. Shartle
Stanley M. Shartle, P.E. & L.S.

Date: December 3, 1992

RECORD OF CORNER



LOCATION OF MONUMENT: SECTION 17, T. 16 N., R. 2 E.

Found: ☒ Set: ☐ Depth: See below

Description: See below


Bearings to reference objects are magnetic unless a contrary mode is shown.

A 3x5-foot hole was excavated but only a 1/2" diameter pipe was found. The preponderance of the evidence examined at the site indicates that the pipe is more likely than not to be at the location of the corner as originally established. Set a No. 6 rebar with standard county disk at the road surface over the pipe.

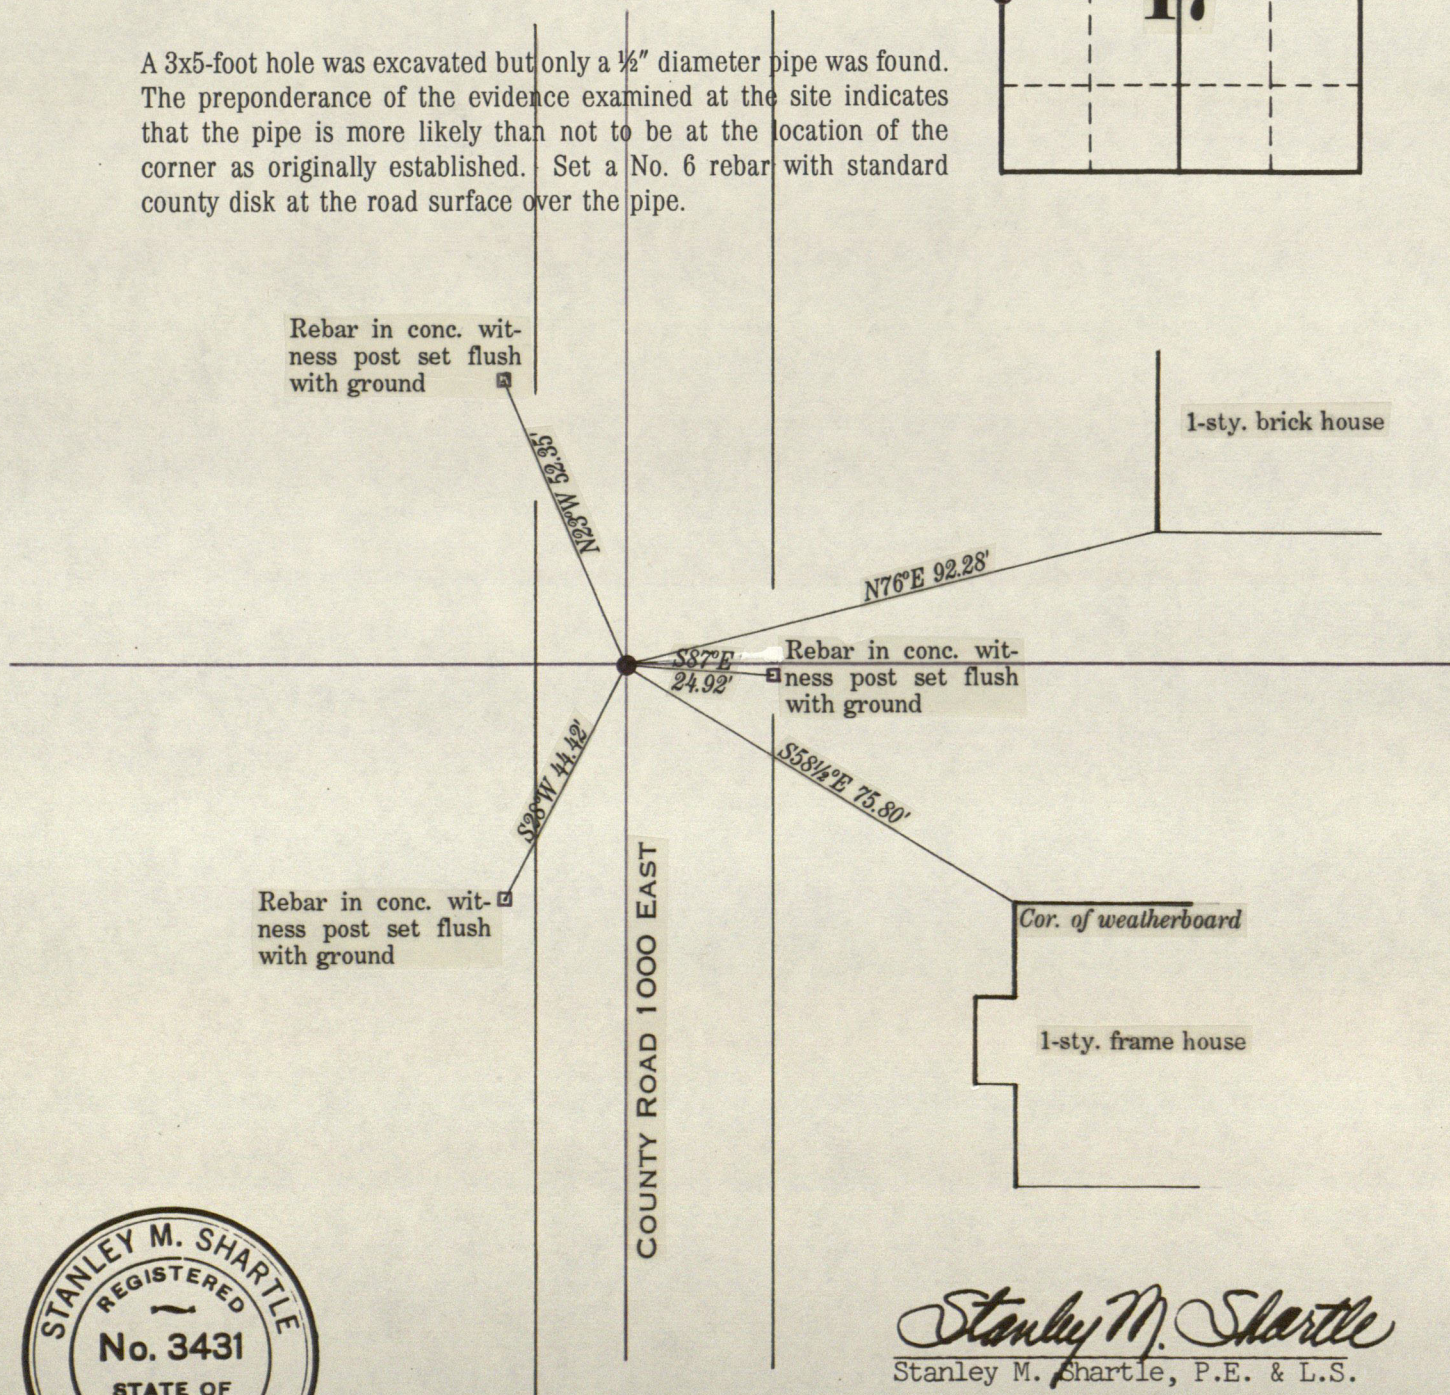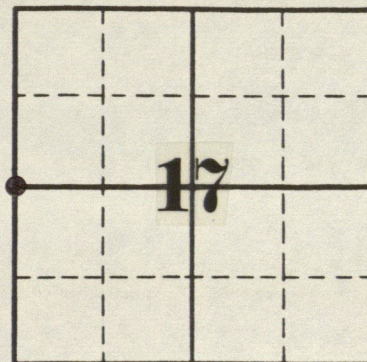


Stanley M. Shartle
Stanley M. Shartle, P.E. & L.S.

Date: December 3, 1992

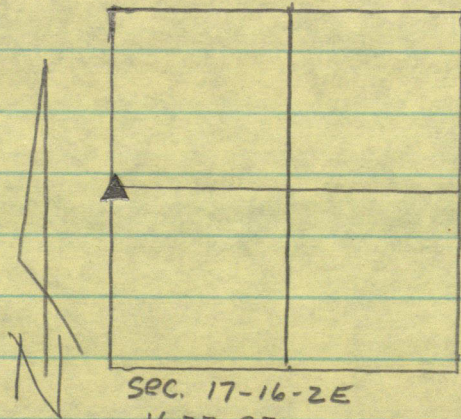


SEC. 17-16-2E
11-27-92
TRI-POD

NOTE: 1/2" Dia I.P. FD.
5' x 3' Hole dug NO STONY FD.
Set Hand. CO. DSK & rebar over
I.P. FD.

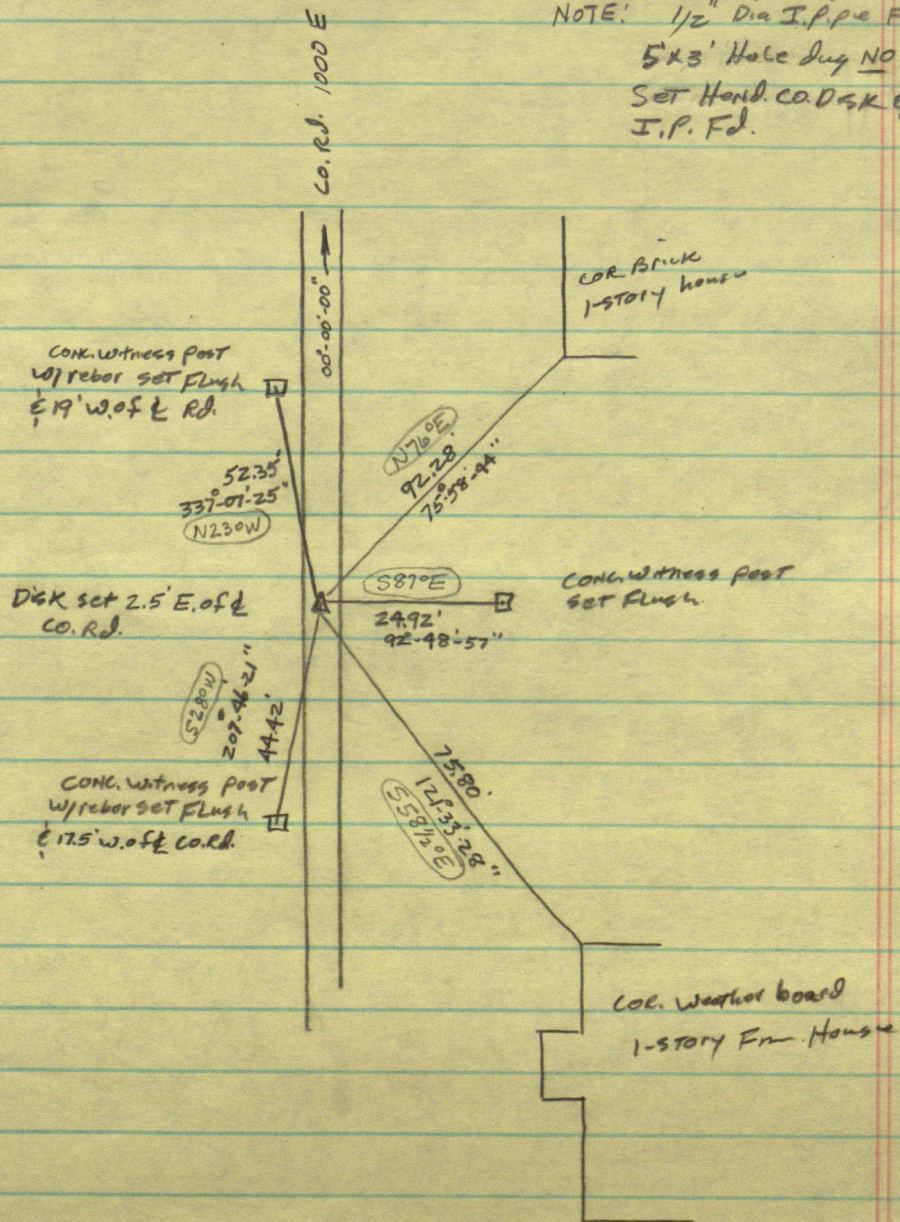

.....

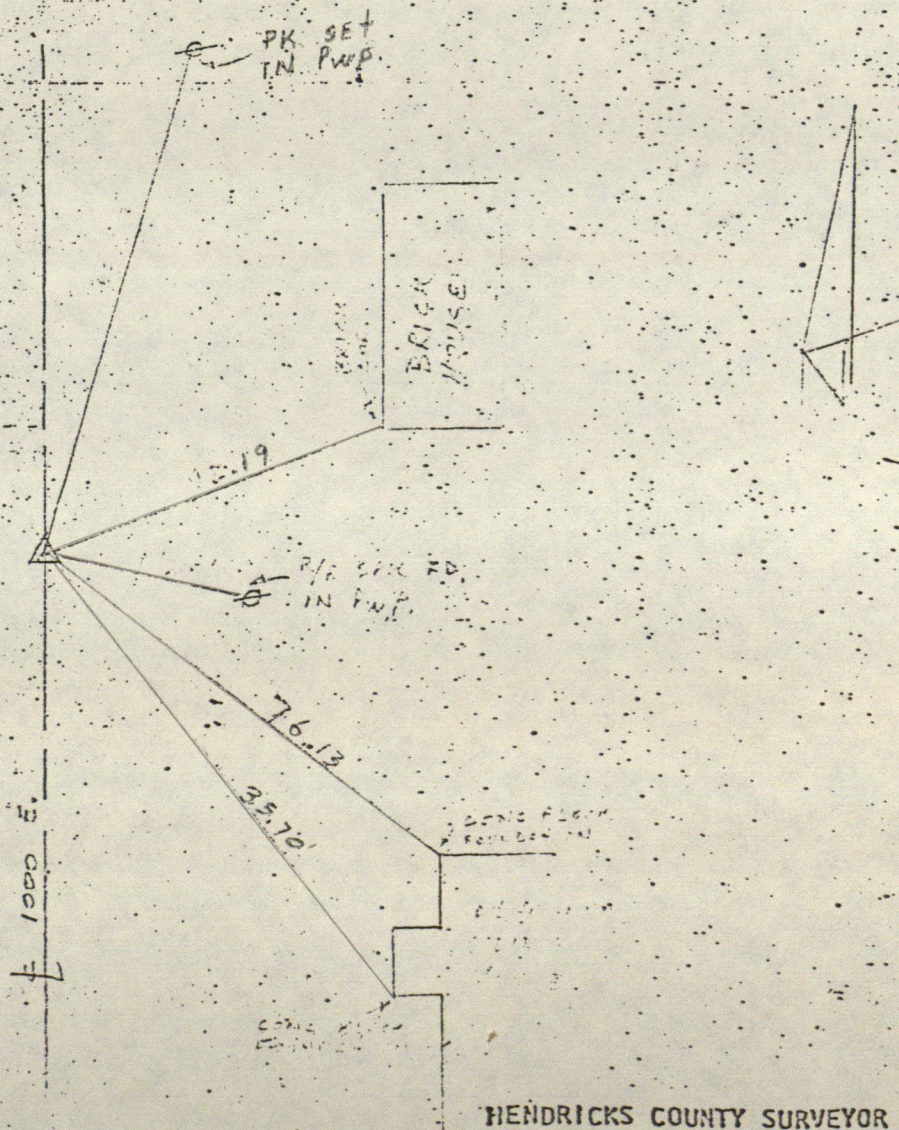

✓

Center


SEC 17 TWP 16 RANGE 2 E

~~Spike~~ Pin Fo.

.2" DEEP. TIES GOOD

EXCEPT P.P. HAS BEEN



REPLACED.

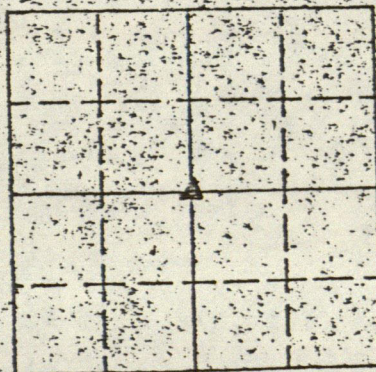

CENTER, SEC 17-16-2E

HENDRICKS COUNTY

DESIGNATION OF MARKER Center SEC 17 TWP 16 RANGE 2E

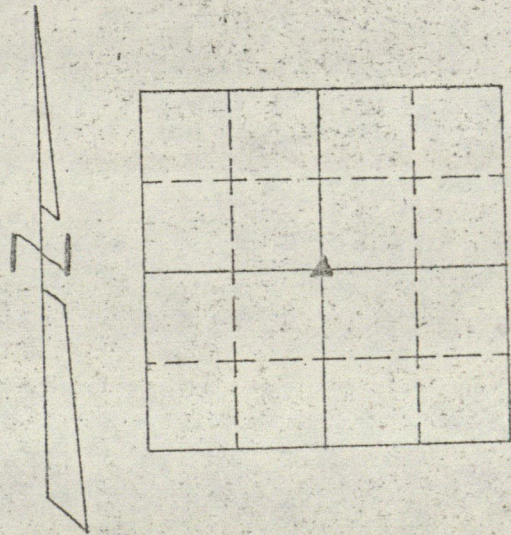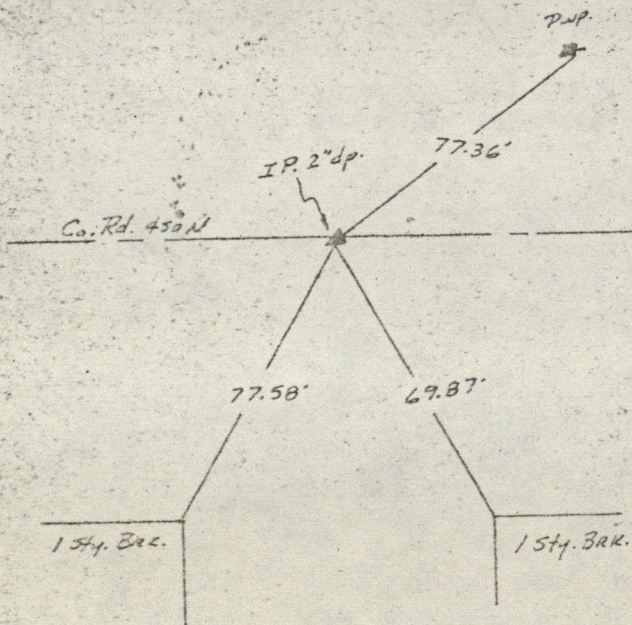

CENTER, SEC 17-16-2E

HENDRICKS COUNTY

DESIGNATION OF MARKER _____ Sec. 17 T. 16 N R 2E

Marker found: yes _____ no _____

Type of Marker: _____

Description: _____



Depth and Marking _____

References set: yes _____ no _____

Sketch References below.

Date: _____ Set by: _____

Comments:

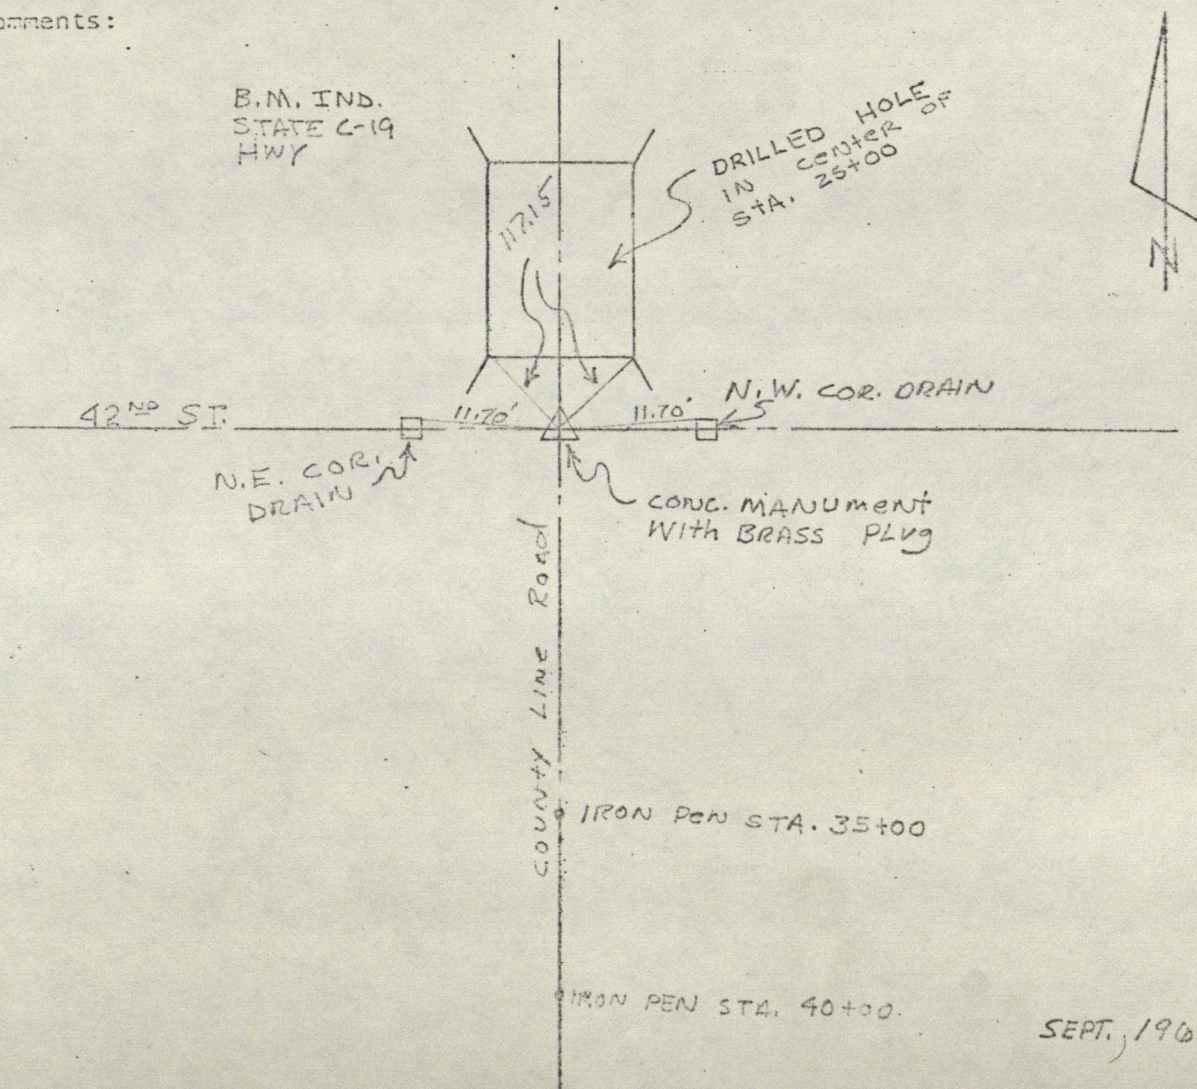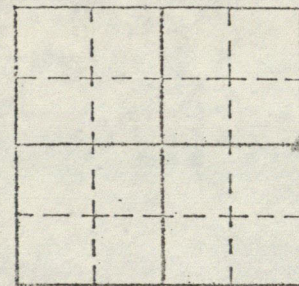

SEPT. 1961

Hendricks County Surveyor

HENDRICKS COUNTY

DESIGNATION OF MARKER N.W. COR. SEC. 17 T. 16 N. 2 E.

Marker found: yes X no

Type of Marker: R/L SPK.

Description:

Depth and Marking: SURFACE

References set: yes no X FOUND

Sketch References below.

Date: 7-20-81

Set by: S. MAXWELL & R. SHAMMUS


Comments:

A I PIPE WAS FD BENT OVER
4' DEEP. 23.5' S. & 4' E
OF THE N.W. COR.

BOTH ARE ON THE GRADE ON
THE BRIDGE OVER I 74 SO IT
WOULD BE
POSSIBLE TO
SEARCH FOR
A STONE
UNDERNEATH


CENT. OF IND.
STATE HIGHWAY
COMMISSION
BENCH MARK
HEND. C-20

ALL DIST'S PLUMB

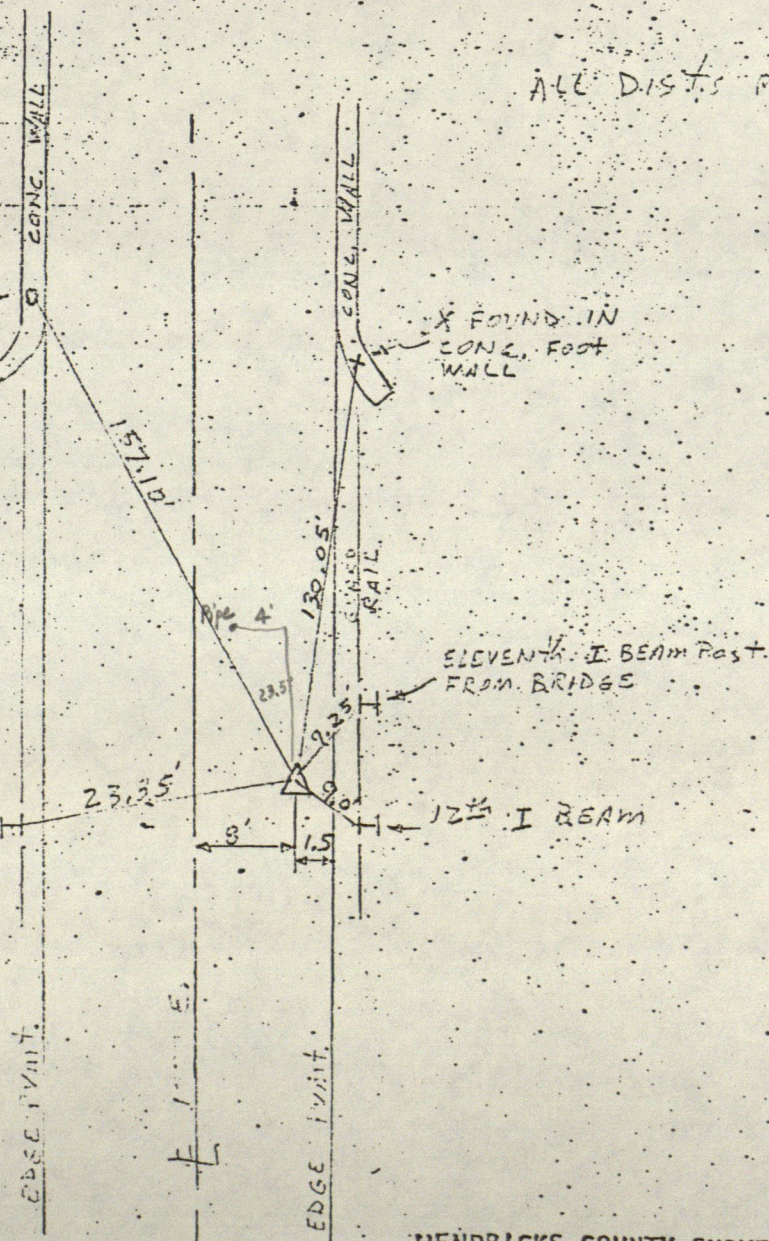

HENDRICKS COUNTY

DESIGNATION OF MARKER E 1/2 mile SEC 17 TWP 16 RANGE 2E

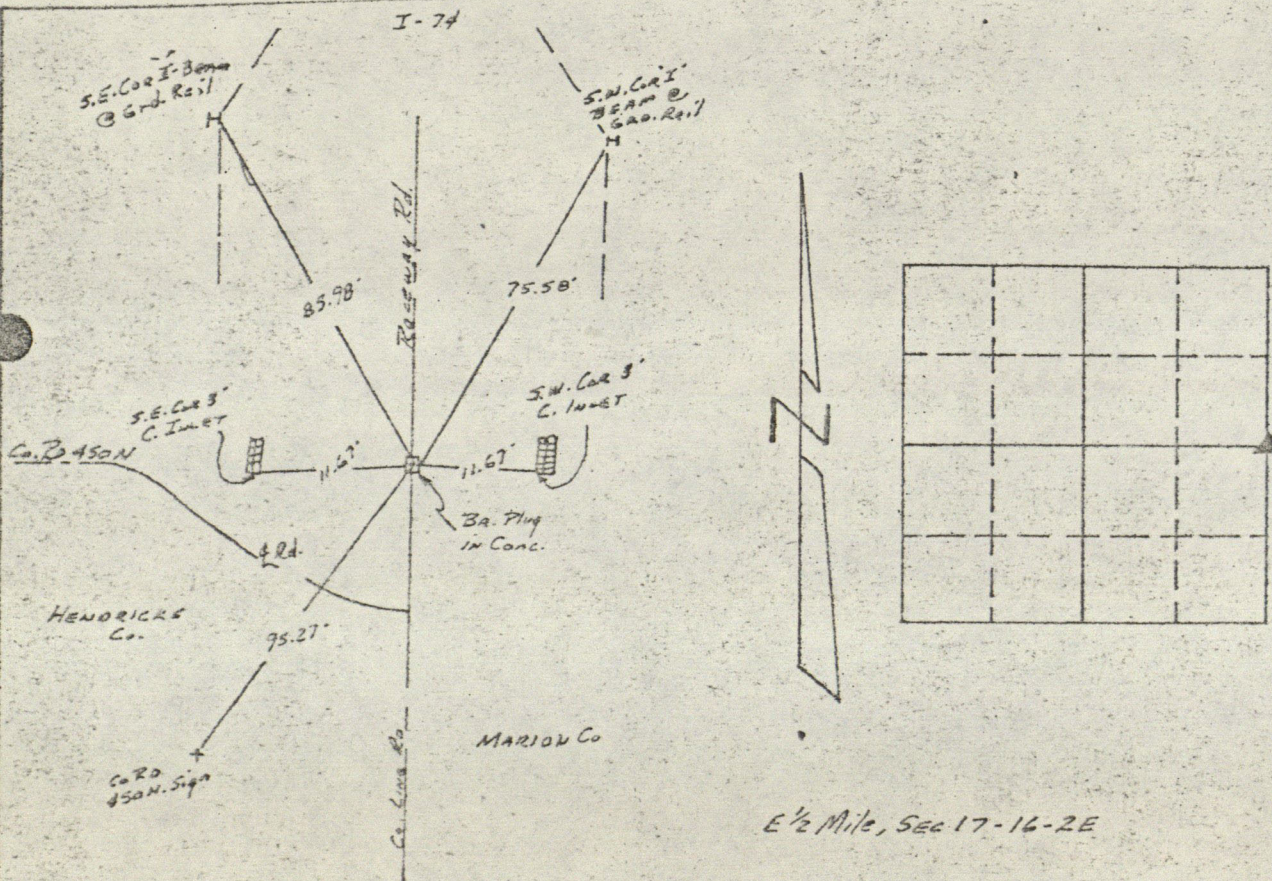

E 1/2 Mile, Sec 17-16-2E

7-27-73
CS



RECORD OF CORNER

LOCATION OF MONUMENT: SECTION 18, T. 16 N., R. 2 E.

Found: ☒ Set: _____ Depth: Stone 24 inches; railroad spike flush

Description: + on stone with railroad spike set at road level

Bearings to reference objects are magnetic unless a contrary mode is shown.

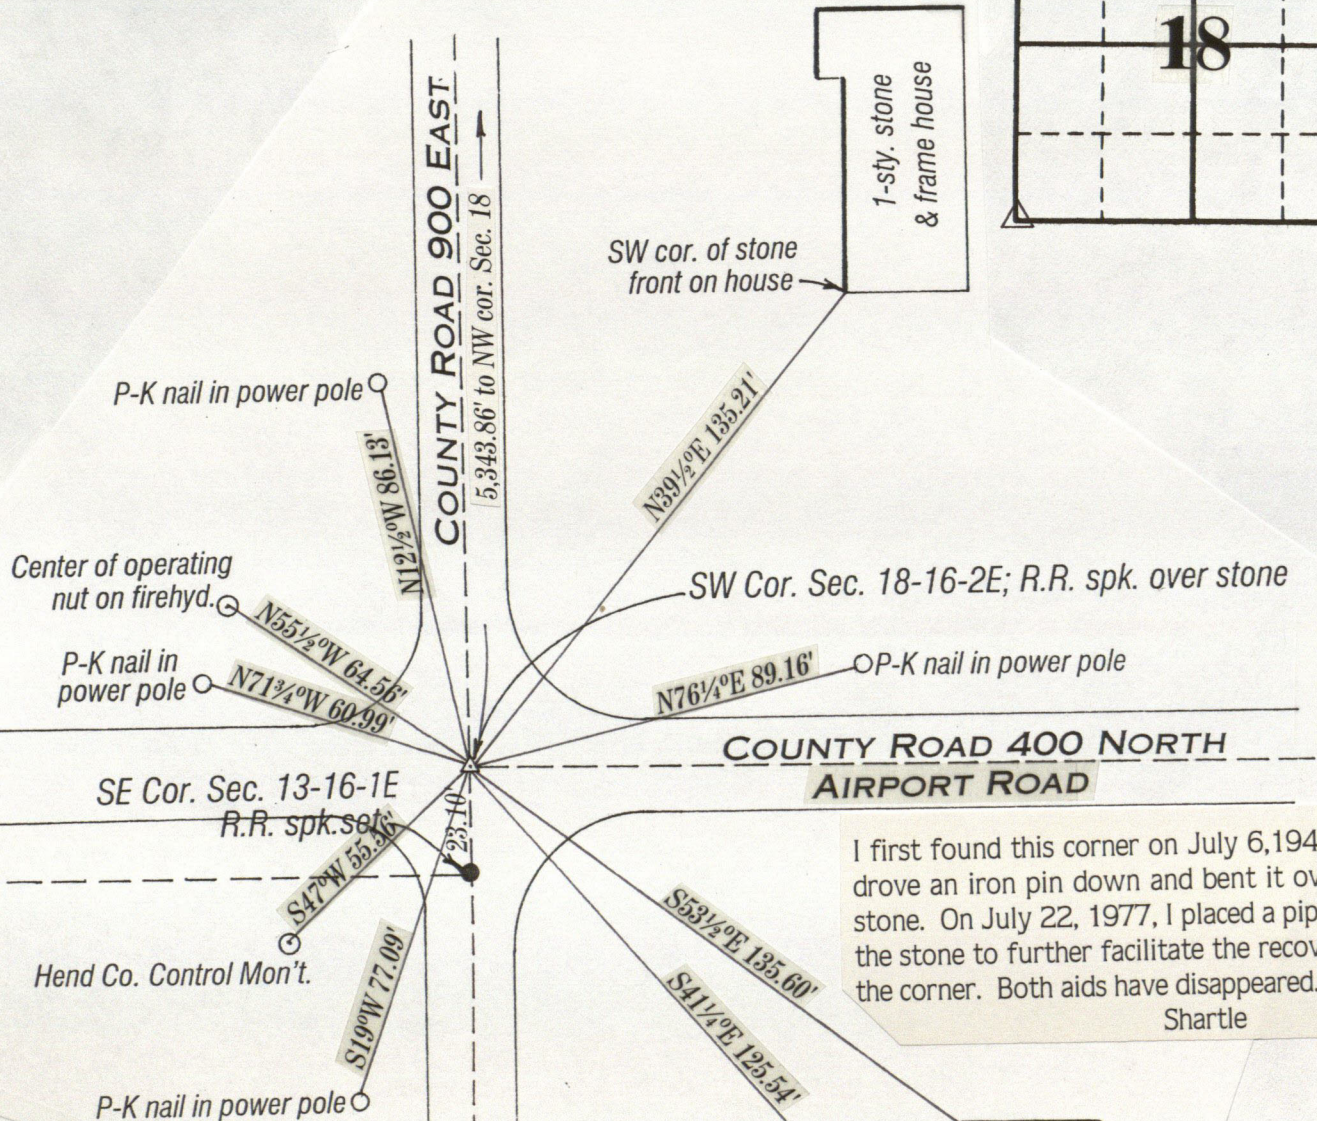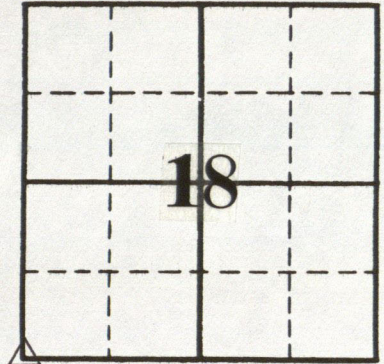

I first found this corner on July 6, 1945, and drove an iron pin down and bent it over the stone. On July 22, 1977, I placed a pipe over the stone to further facilitate the recovery of the corner. Both aids have disappeared.

Shartle



Stanley M. Shartle

Stanley M. Shartle, P.E. & L.S.


Date: NOV. 29 2004

SW Cor. 18-16-2E

24" deep + cut

50°

29.9

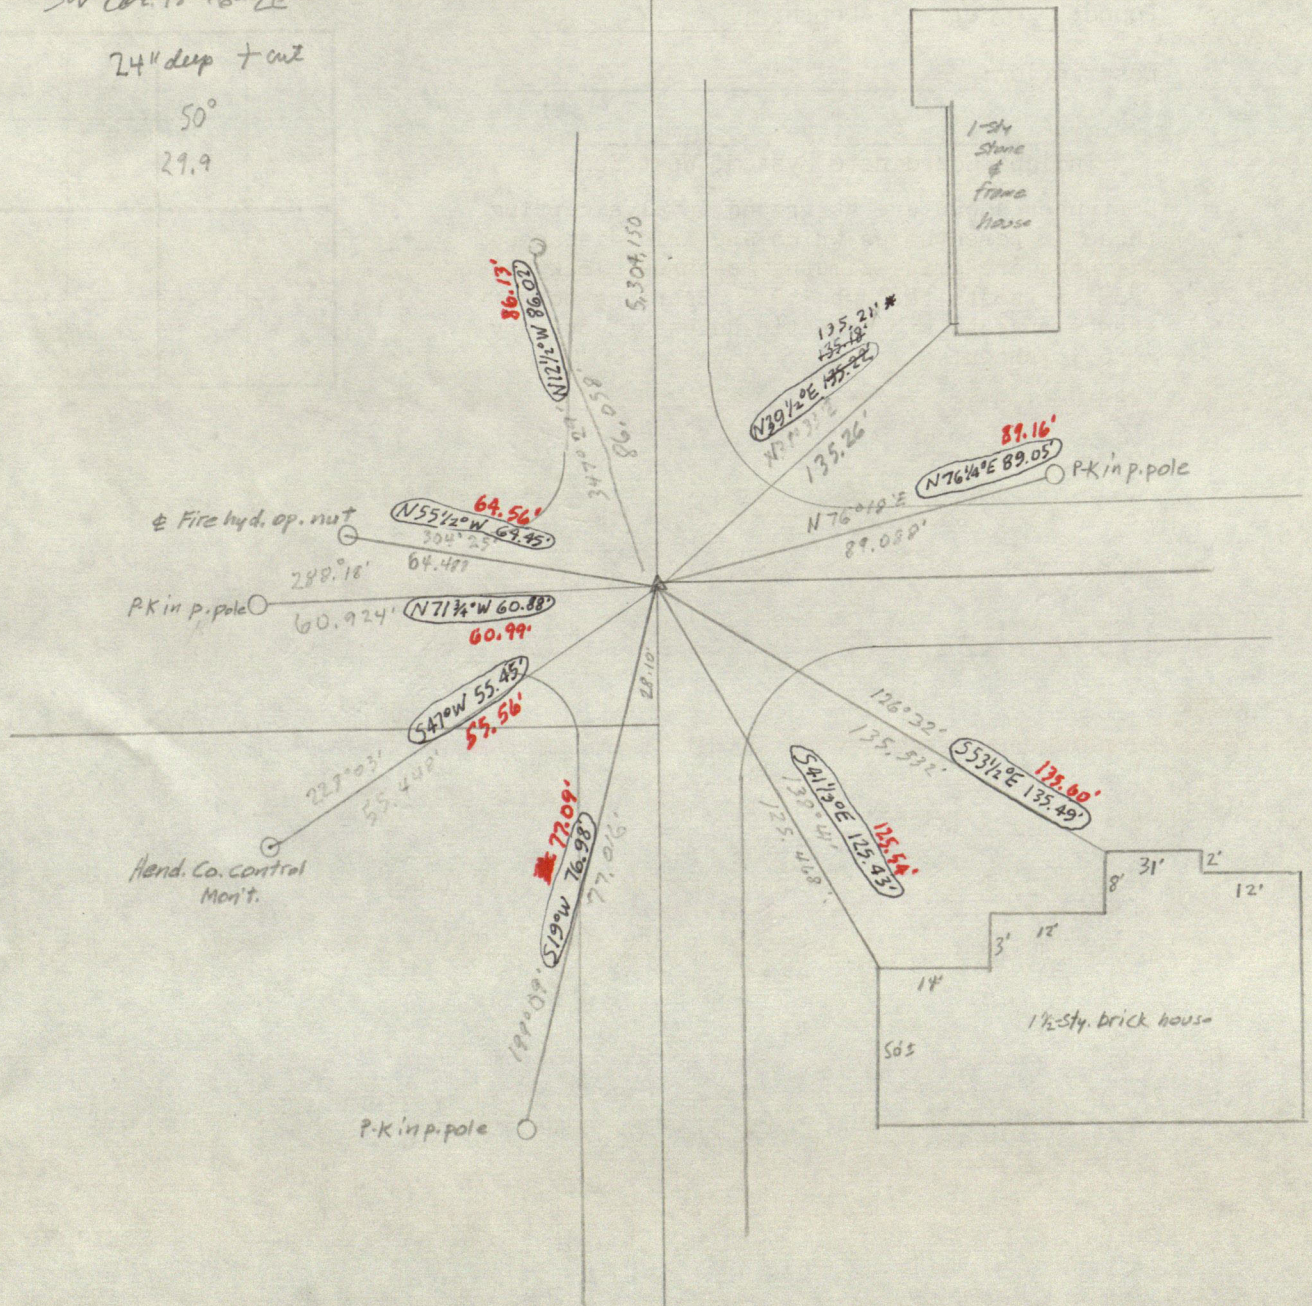

* 135.26 found
= 0.016 for temp.
- 0.03 x slope
135.214

Red - corrected for instrument error

STANLEY M. SHARTLE
REGISTERED PROFESSIONAL ENGINEER
RURAL ROUTE 1, BOX 33
STILESVILLE, IND. 46180

LOCATION OF MONUMENT: SECTION 18, T. 16 N., R. 2 E.


Monument found: Yes ☒ No ☐

Description: Stone with I.P. bent over it
and pipe set above I.P.


Depth: Stone 21 inches; pipe 2 inches

References taken: July 22, 1977


Comments: Bearings are magnetic

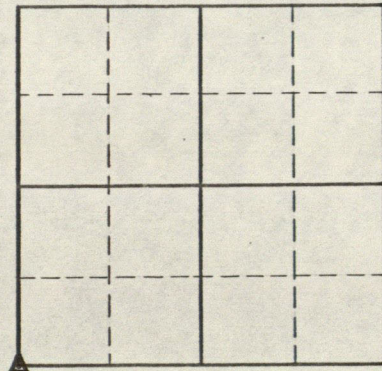

SW cor. of stone
front on house

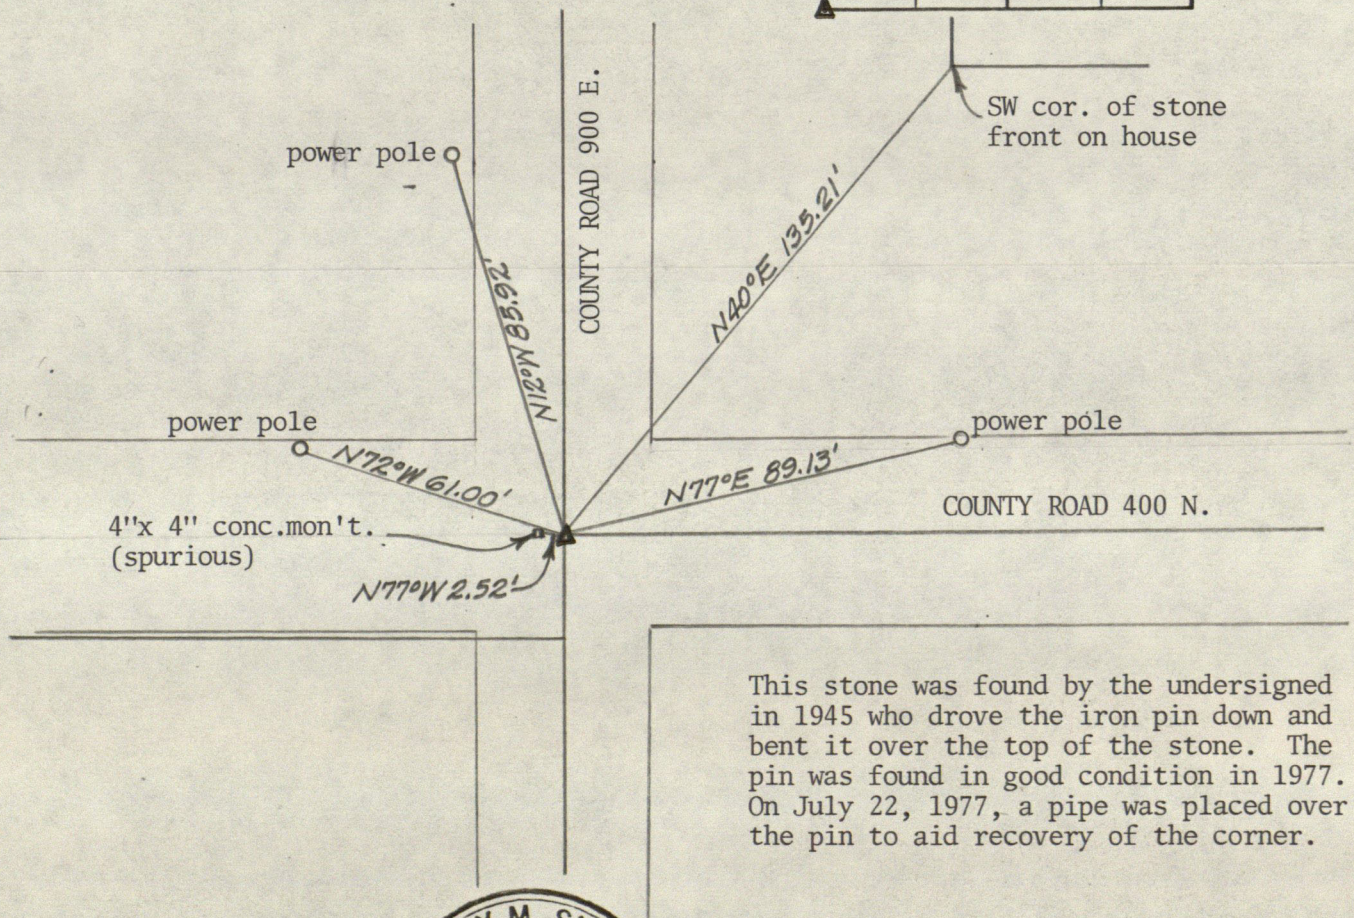

This stone was found by the undersigned in 1945 who drove the iron pin down and bent it over the top of the stone. The pin was found in good condition in 1977. On July 22, 1977, a pipe was placed over the pin to aid recovery of the corner.

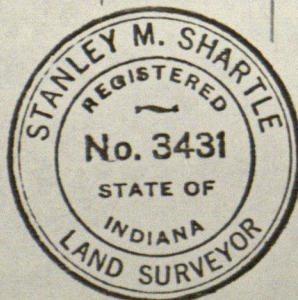

Stanley M. Shartle

Stanley M. Shartle, P.E & L.S.



August 2, 1977

Date

HENDRICKS COUNTY

DESIGNATION OF MARKER S 1/2 mile

SEC 19 TWP 16 RANGE 2E

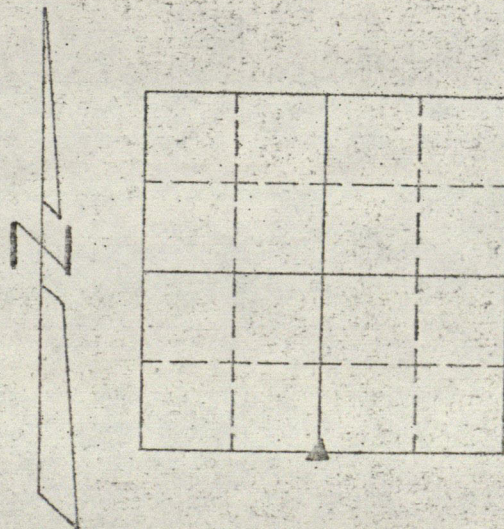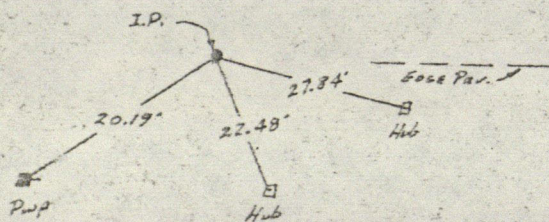

S 1/2 Mile, SEC. 19-16-2E


STANLEY M. SHARTLE

LOCATION OF MONUMENT: SECTION 19, T. 16 N., R. 2 E.

Found: ☒ Set: Depth: 16 inches

Description: granite stone 5x18x20 inches
railroad spike set above

Bearings to reference objects are magnetic unless a contrary mode is shown.



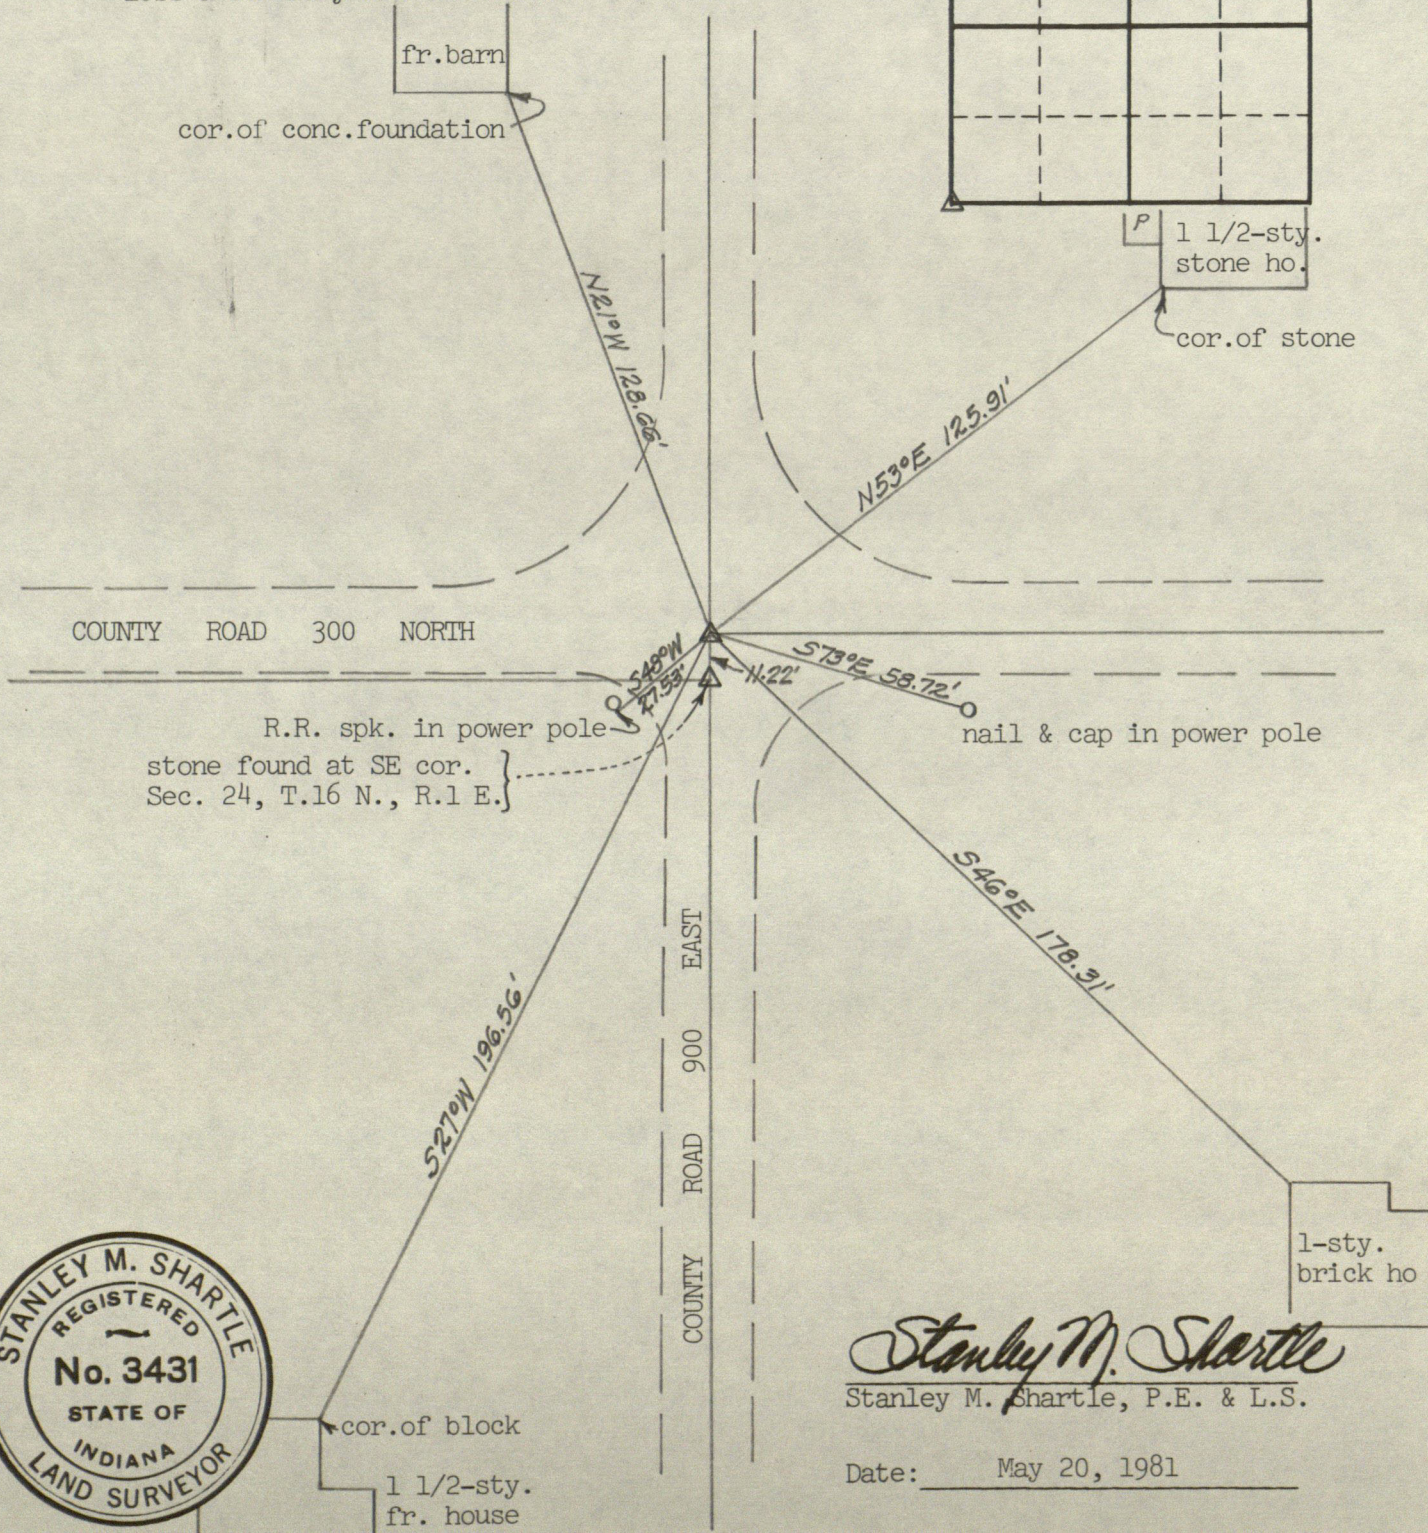


Stanley M. Shartle
Stanley M. Shartle, P.E. & L.S.

Date: May 20, 1981

HENDRICKS COUNTY

DESIGNATION OF MARKER 7184 SEC 19 TWP 16 RANGE 2E

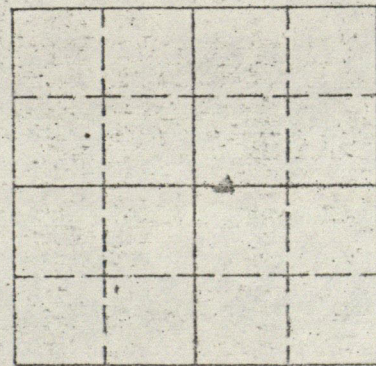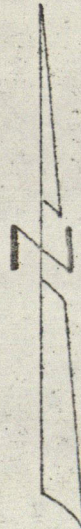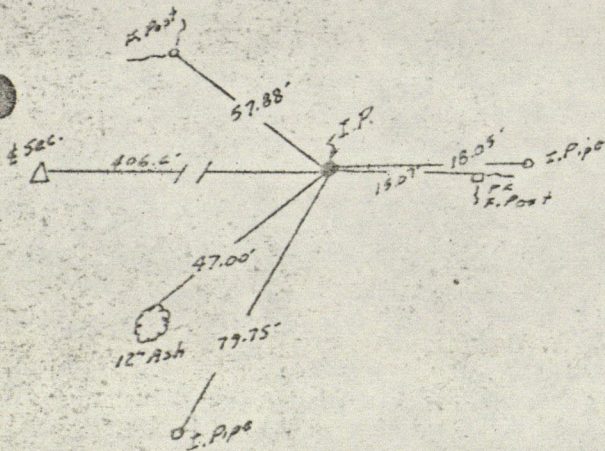

PT. ON S. L. N.E. 1/4, SEC. 19-16-2E

4-20-71
C.B.

DESIGNATION OF MARKER

Sec. 19 T.16 N R 2 E

Marker found: yes ☒ no ☐

Type of Marker: PK over Hub

Description: _____

Depth and Marking: _____



References set: yes ☒ no ☐

Sketch References below.

Date: 11/28/22

Set by: Dick Hayden & Dennis Hayden

Comments:

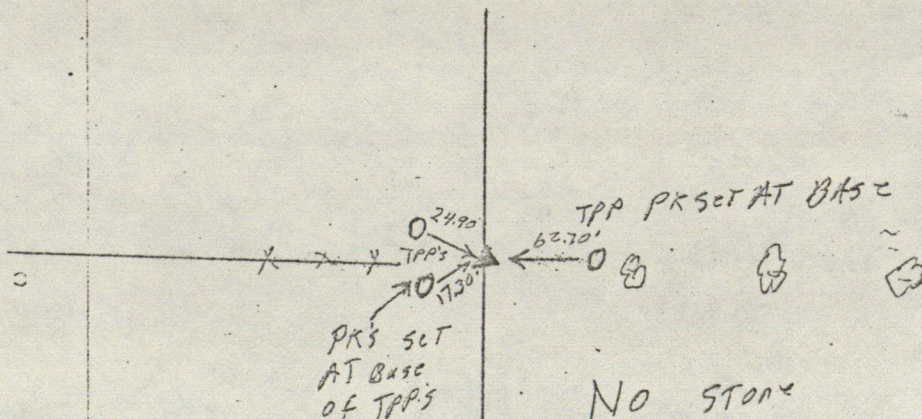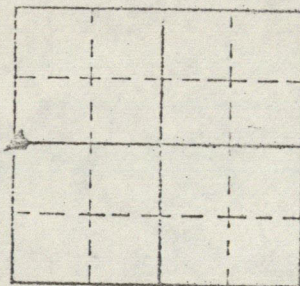

NO STONE

Found




OLD PK over Hub Found

New IP SET WITH RR Bolt SET

NA

HENDRICKS COUNTY

DESIGNATION OF MARKER W¹/₂ mile SEC 19 TWP 16 RANGE 2E

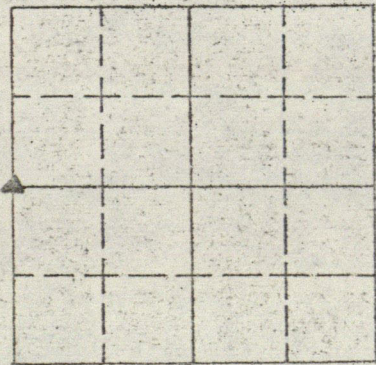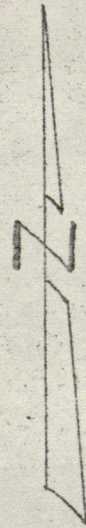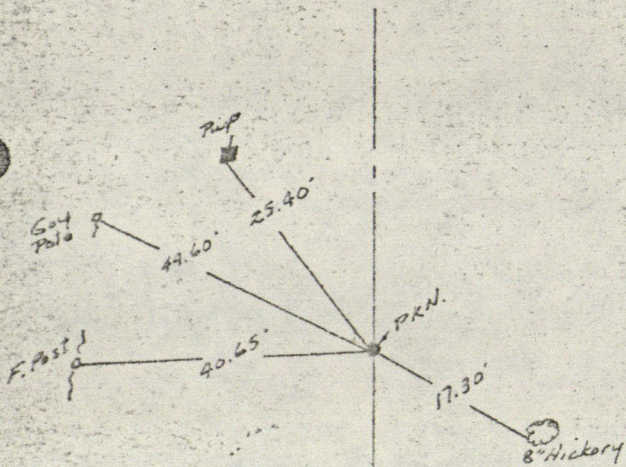

W¹/₂ Mile, SEC. 19-16-2E

HENDRICKS COUNTY

DESIGNATION OF MARKER NE Corner SEC 19 TWP 16 RANGE 2E

For Cor
Post

30.07'

Co. Ro. 400N

Stone

House

72.55'



36.78'

Rup.

74.54'

Co. Ro. 1000E

Apple
Tree

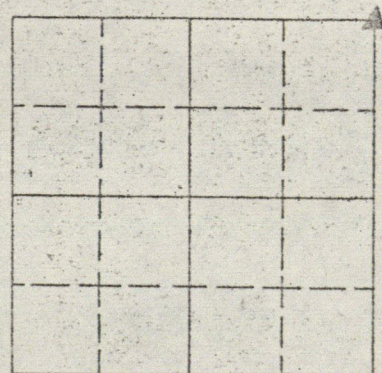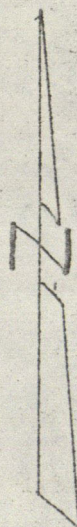




N.E. Cor., SEC. 19-16-2E

4-25-69
Fairs
4-21-71
CB

HENDRICKS COUNTY

DESIGNATION OF MARKER NW Cor




SEC 19 TWP 16 RANGE 2E

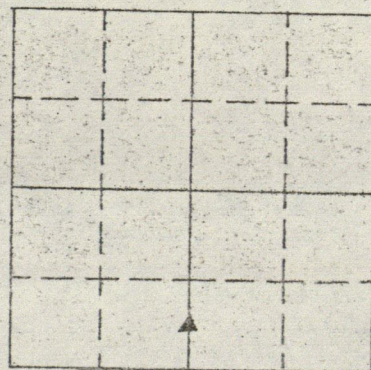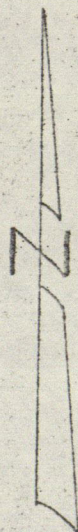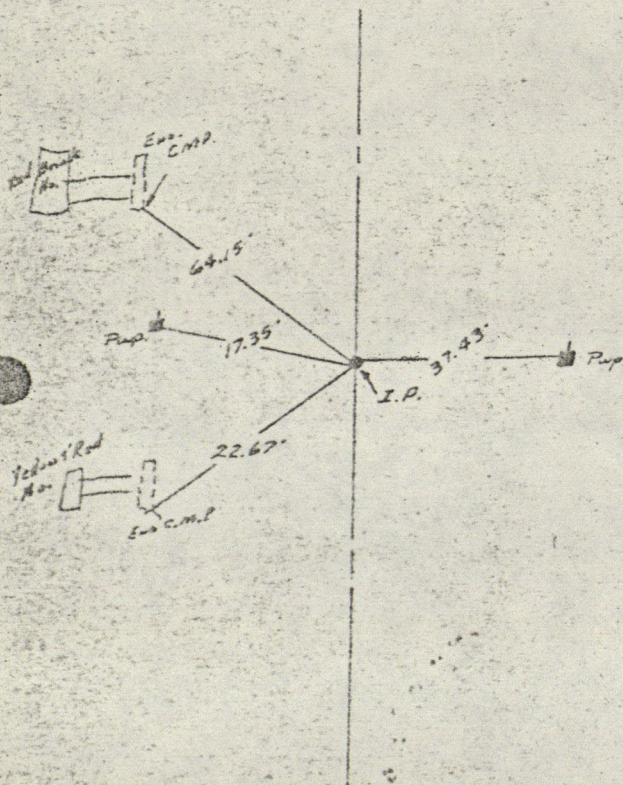

N.W. COR. LAKEWOOD TERRACE
Pt. on W.L. S.E. 1/4, SEC. 19-16-2E

HENDRICKS COUNTY




DESIGNATION OF MARKER NE Cor. SE¹/₄ SW⁴ SEC 19 TWP 16 RANGE 2E

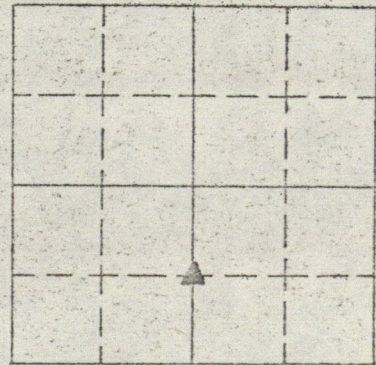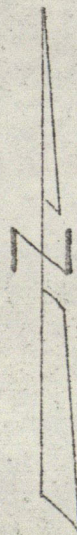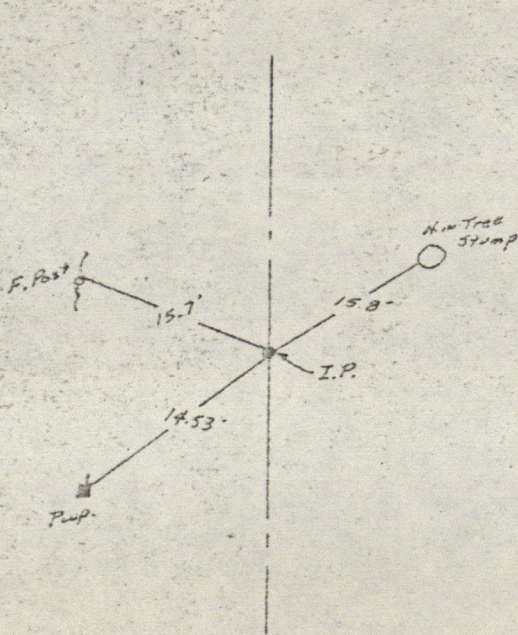

N.E. Cor, S.E¹/₄, S.W¹/₄, SEC. 19-16-2E

HENDRICKS COUNTY


DESIGNATION OF MARKER Center SEC 19 TWP 16 RANGE 2E

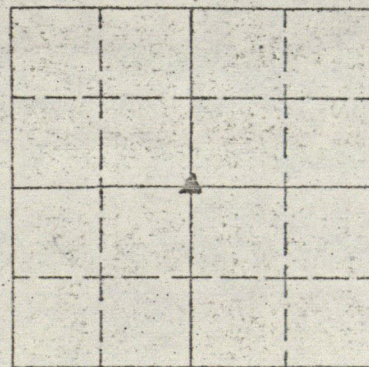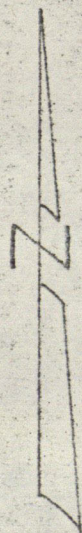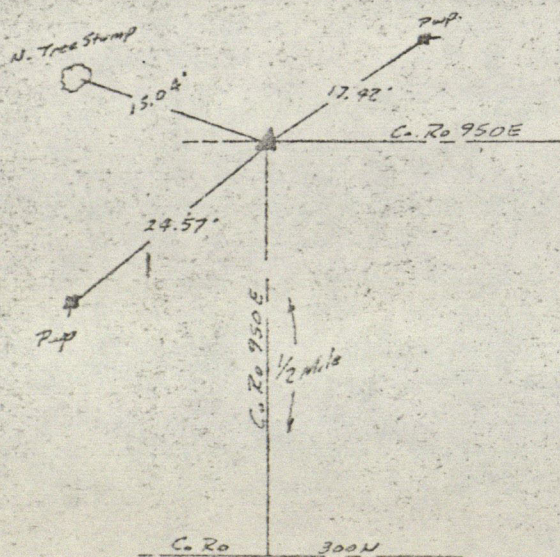

CENTER, SEC. 19-16-2E

HENDRICKS COUNTY

DESIGNATION OF MARKER N 1/2 mile SEC 19 TWP 16 RANGE 2E



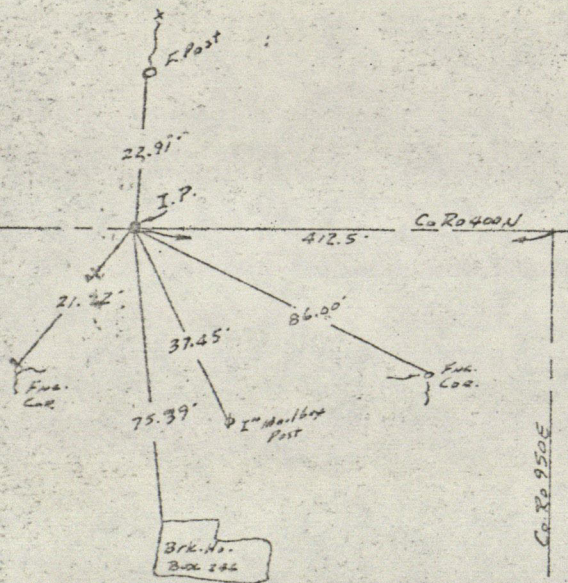


N 1/2 Mile, Sec 19-16-2E

4-20-71
L.B.

HENDRICKS COUNTY

DESIGNATION OF MARKER E Section SEC 19 TWP 16 RANGE 2E

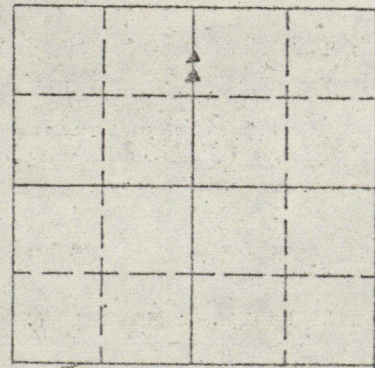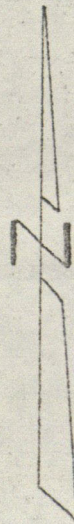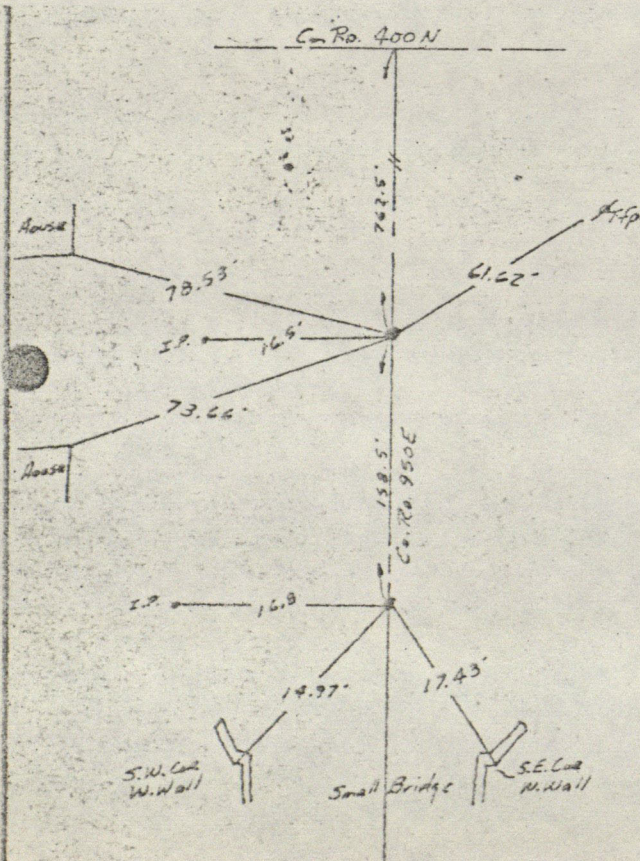

PTS. ON E SEC., SEC. 19-16-2E, ± 726' S. of N.L.

4-20-71
C.B.


RECORD OF CORNER

LOCATION OF MONUMENT: SECTION 20, T. 16 N., R. 2 E.

Found: ☒ Set: ☐ Depth: ☐ See below ☐

Description: See below

Bearings to reference objects are magnetic unless a contrary mode is shown.

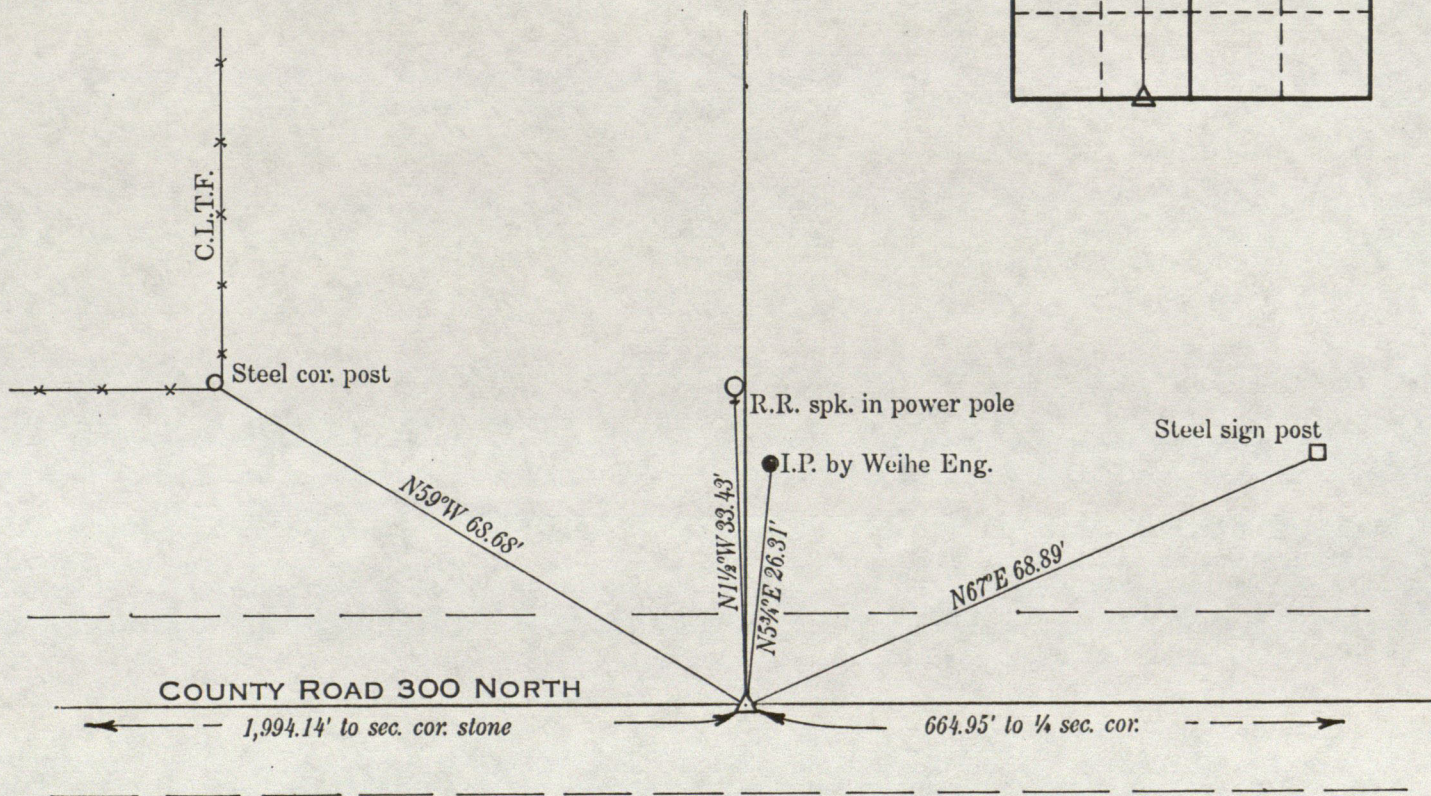

This corner stone, found about eight inches deep, was set about 1890 by County Surveyor John W. Trotter as his corner No. 3 in his survey of the estate of U. G. Ballard, deceased. No surface mark was placed over the stone.



Stanley M. Shartle
Stanley M. Shartle, P.E. & L.S.

Date: January 6, 1993



RECORD OF CORNER

LOCATION OF MONUMENT: SECTION 20, T. 16 N., R. 2 E.

Found: ☒ Set: ☐ Depth: ☐ See below ☐

Description: See below

Bearings to reference objects are magnetic unless a contrary mode is shown.

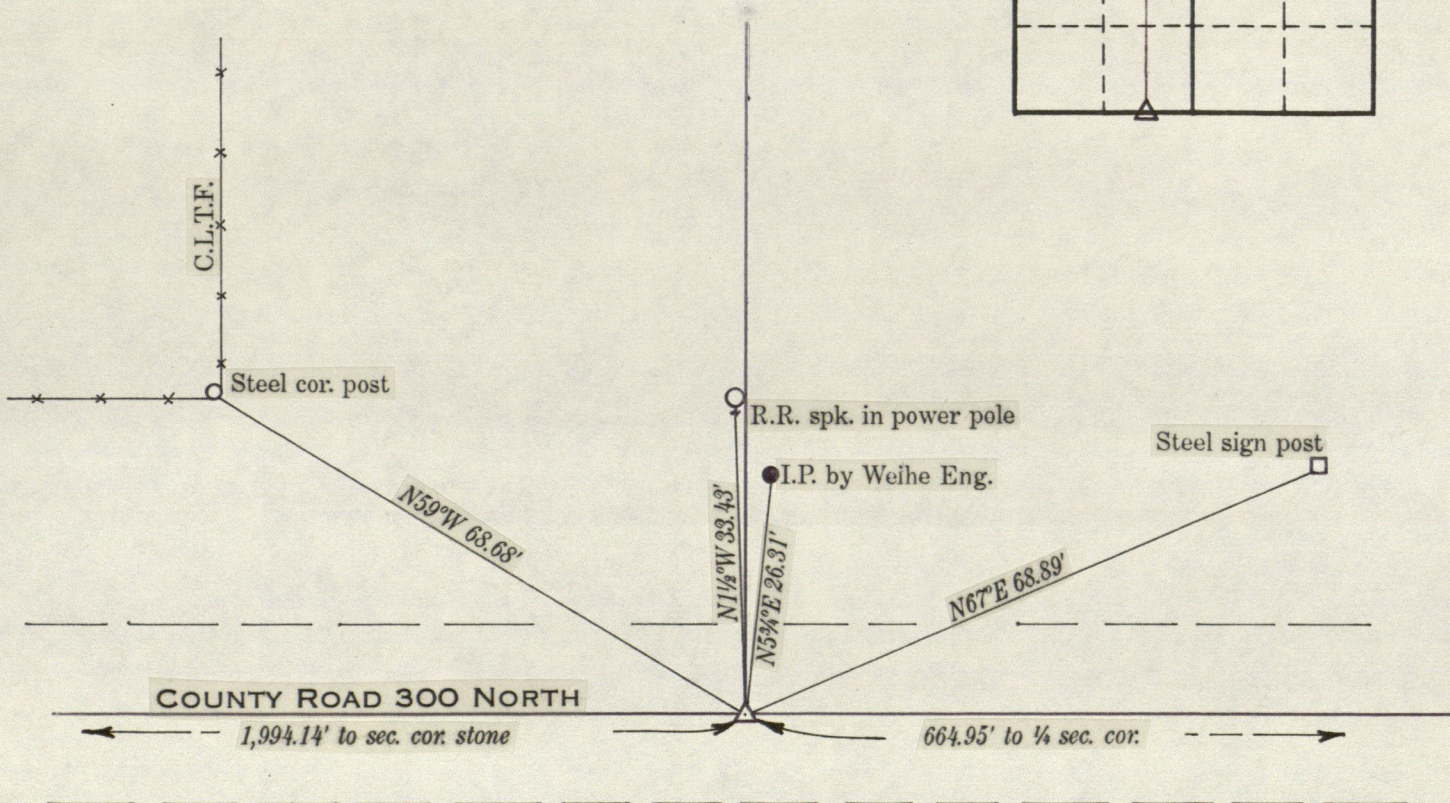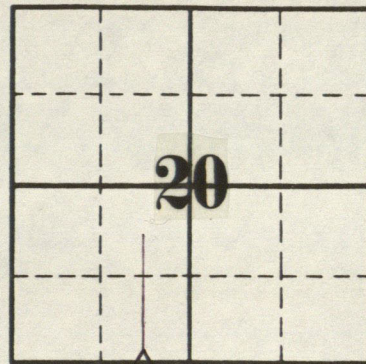


This corner stone, found about eight inches deep, was set about 1890 by County Surveyor John W. Trotter as his corner No. 3 in his survey of the estate of U. G. Ballard, deceased. No surface mark was placed over the stone.



Stanley M. Shartle
Stanley M. Shartle, P.E. & L.S.

Date: January 6, 1993

664.95'

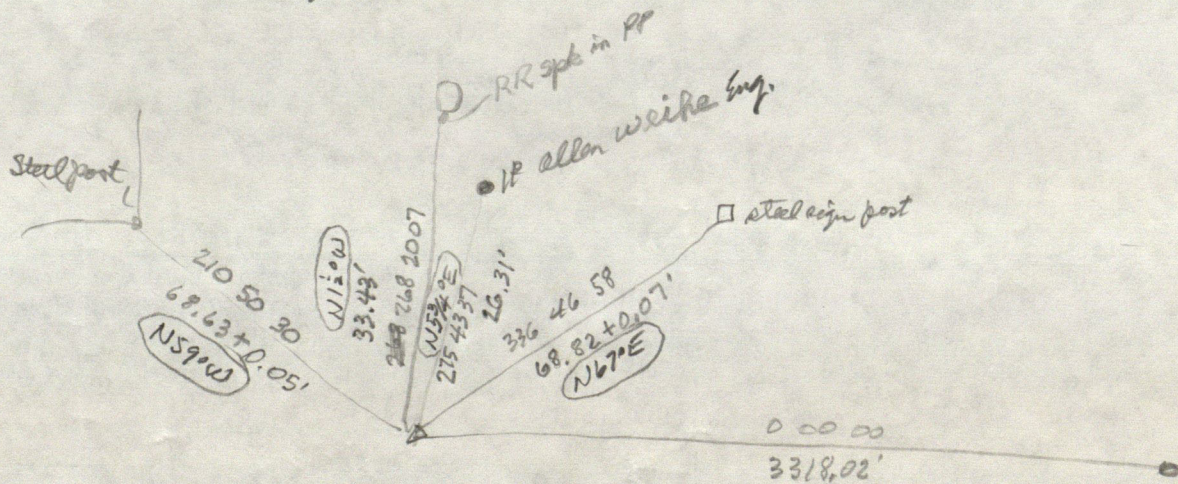



RECORD OF CORNER

LOCATION OF MONUMENT: SECTION 20, T. 16 N., R. 2E

Found: ☒ Set: ☐ Depth: 6 inches

Description: No. 6 rebar with standard county disk placed over the corner stone

Bearings to reference objects are magnetic unless a contrary mode is shown.

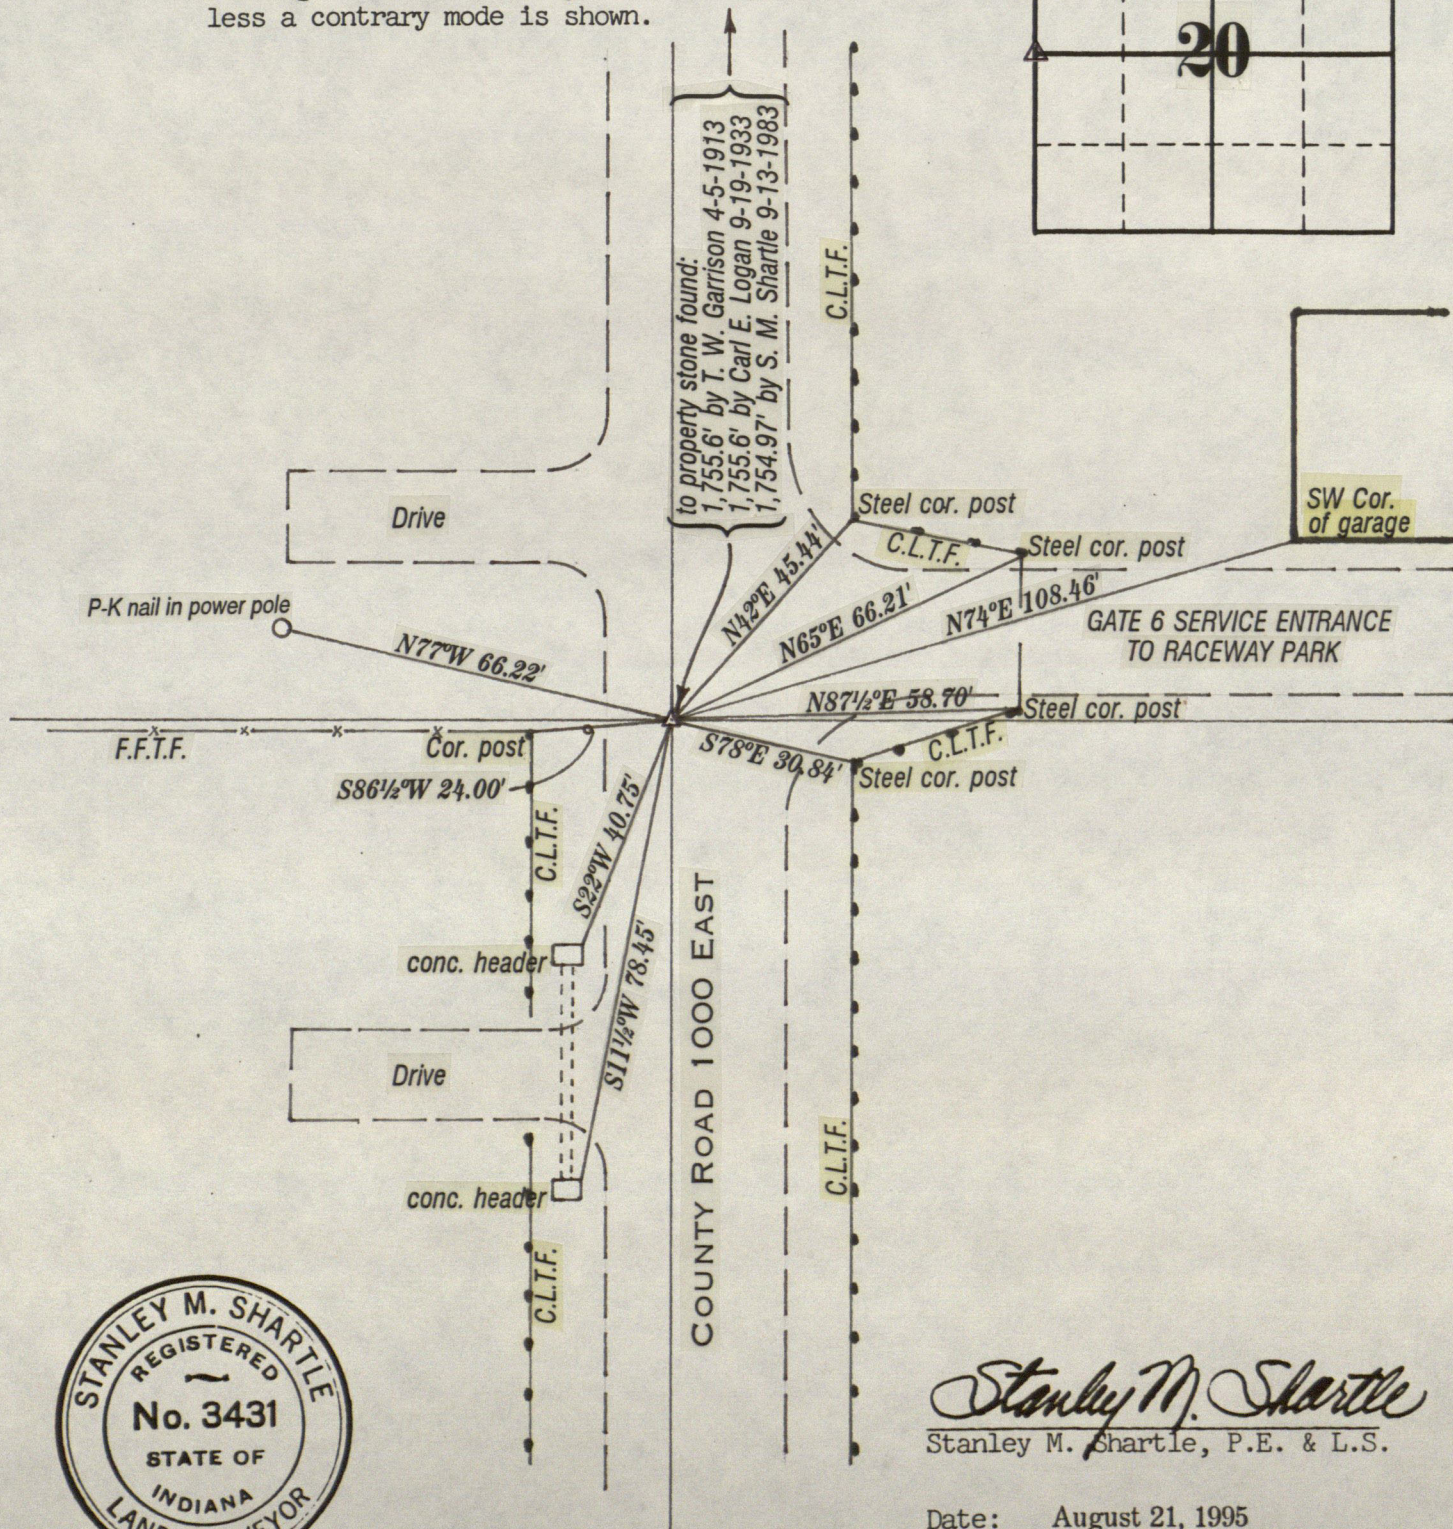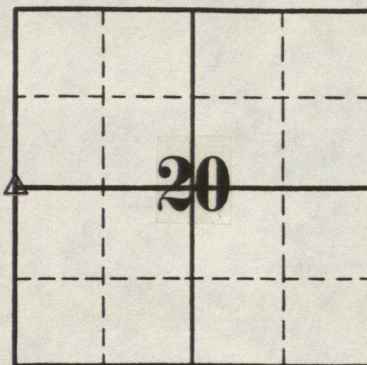

Stanley M. Shartle
Stanley M. Shartle, P.E. & L.S.

Date: August 21, 1995




STANLEY M. SHARTLE

LOCATION OF MONUMENT: SECTION 20, T. 16 N., R. 2 E.

Found: ☒ Set: ☐ Depth: 3 inches

Description: hole drilled in old stone

Bearings to reference objects are magnetic unless a contrary mode is shown.

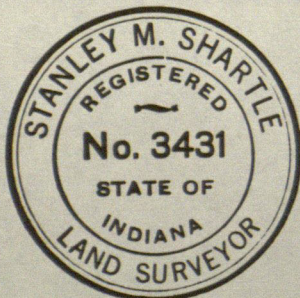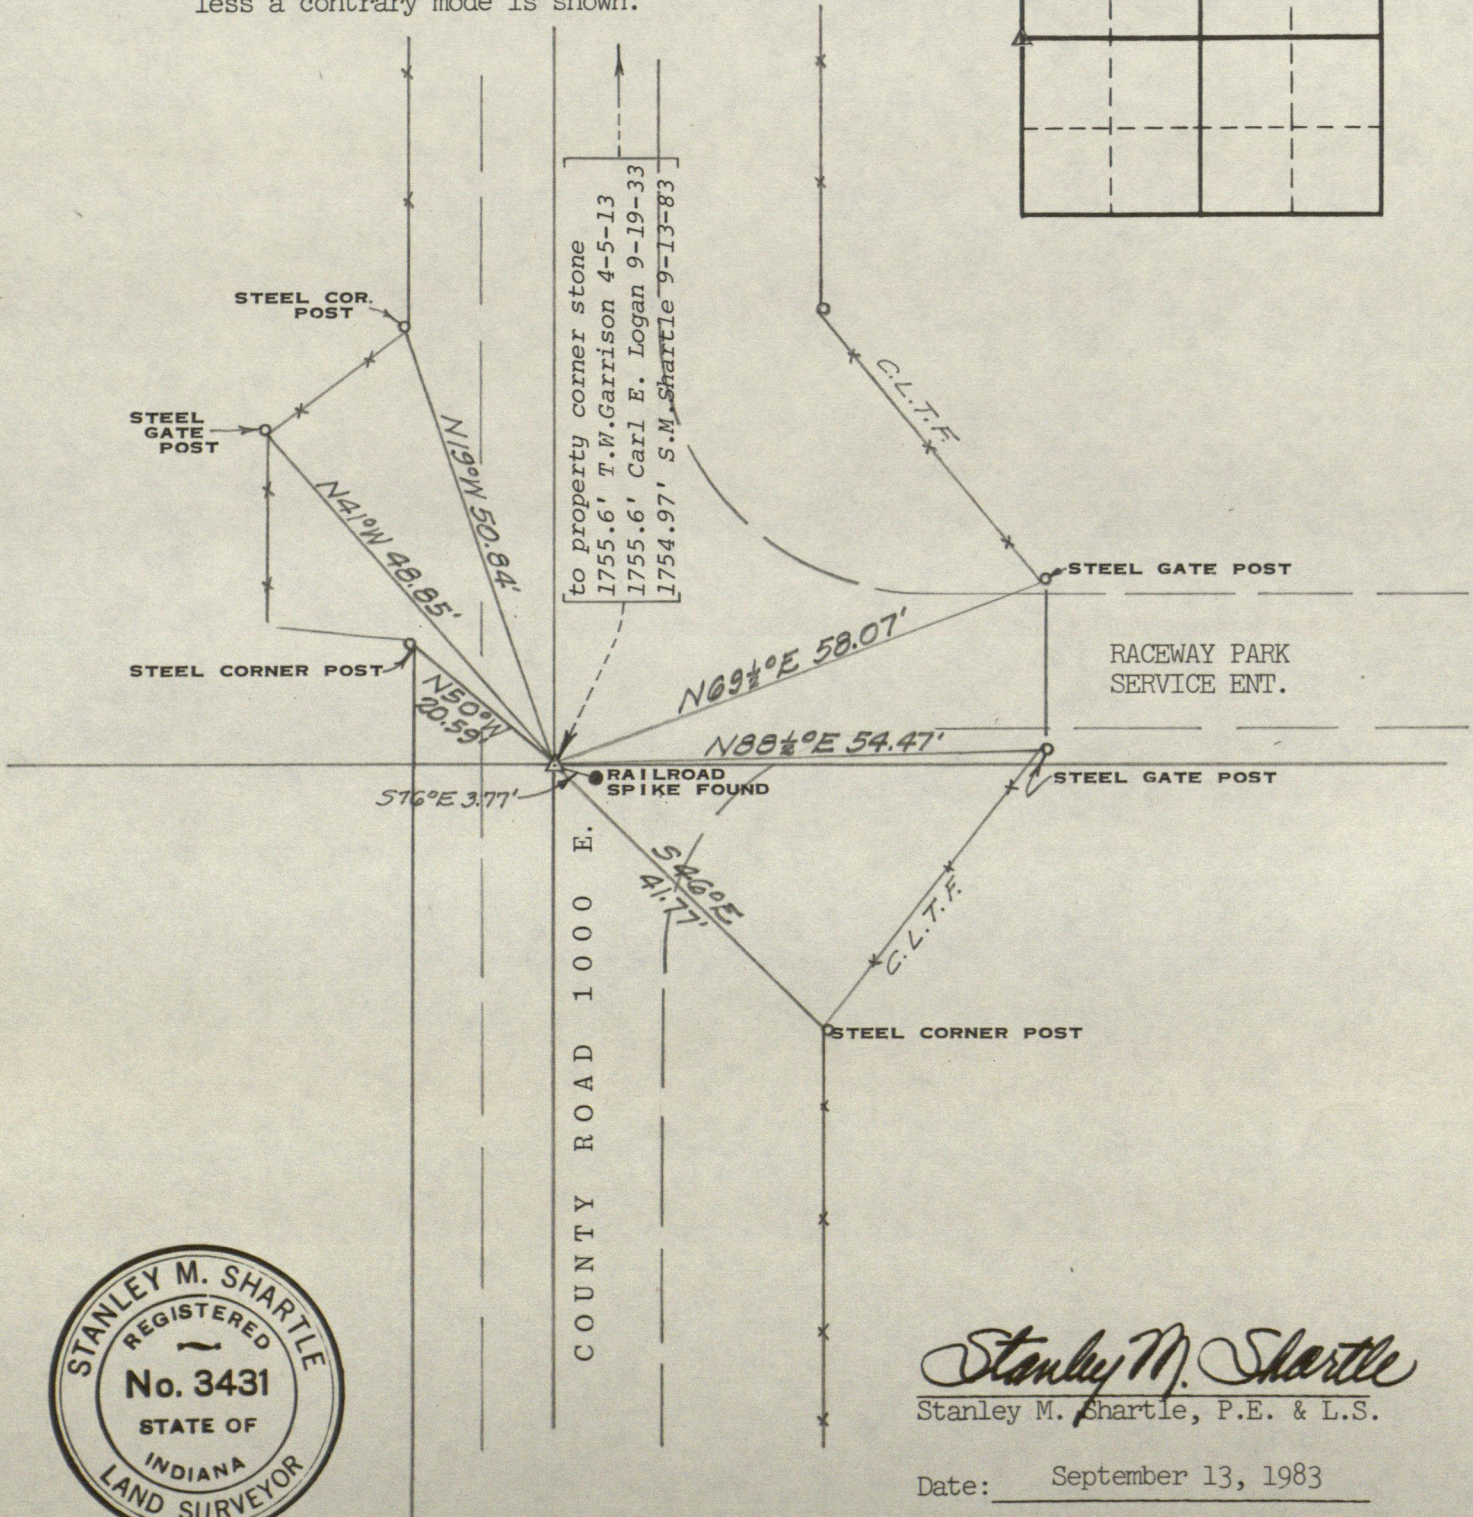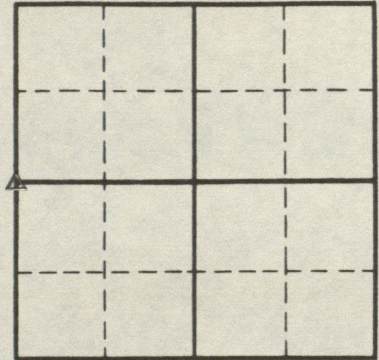

Stanley M. Shartle
Stanley M. Shartle, P.E. & L.S.

Date: September 13, 1983


STANLEY M. SHARTLE

LOCATION OF MONUMENT: SECTION 20, T. 16 N., R. 2 E.

Found: ☒ Set: ☐ Depth: 7 inches

Description: tip of peak on old stone

Bearings to reference objects are magnetic unless a contrary mode is shown.

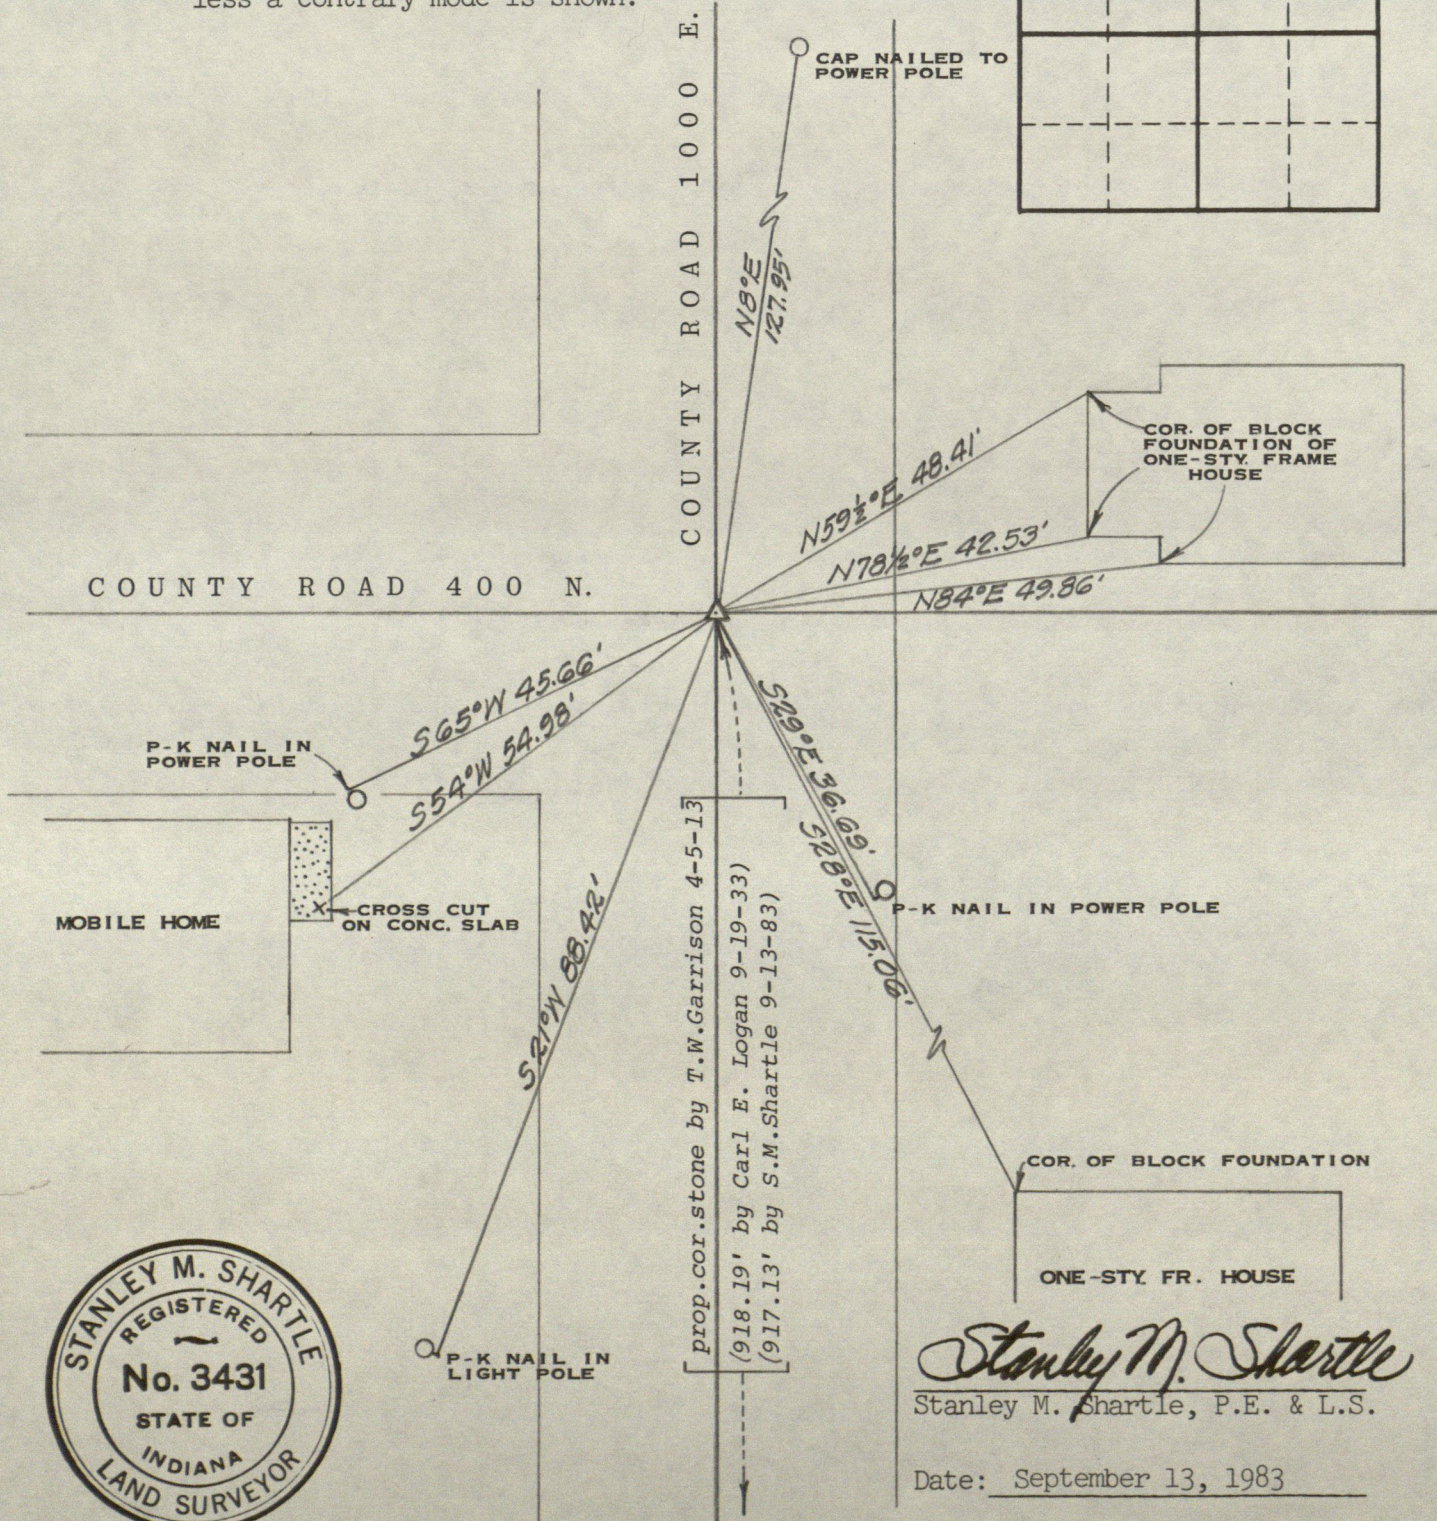


STANLEY M. SHARTLE

LOCATION OF MONUMENT: SECTION 20, T. 16 N., R. 2 E.

Found: ☒ Set: Depth: 3 inches

Description: hole drilled in stone

Bearings to reference objects are magnetic unless a contrary mode is shown.

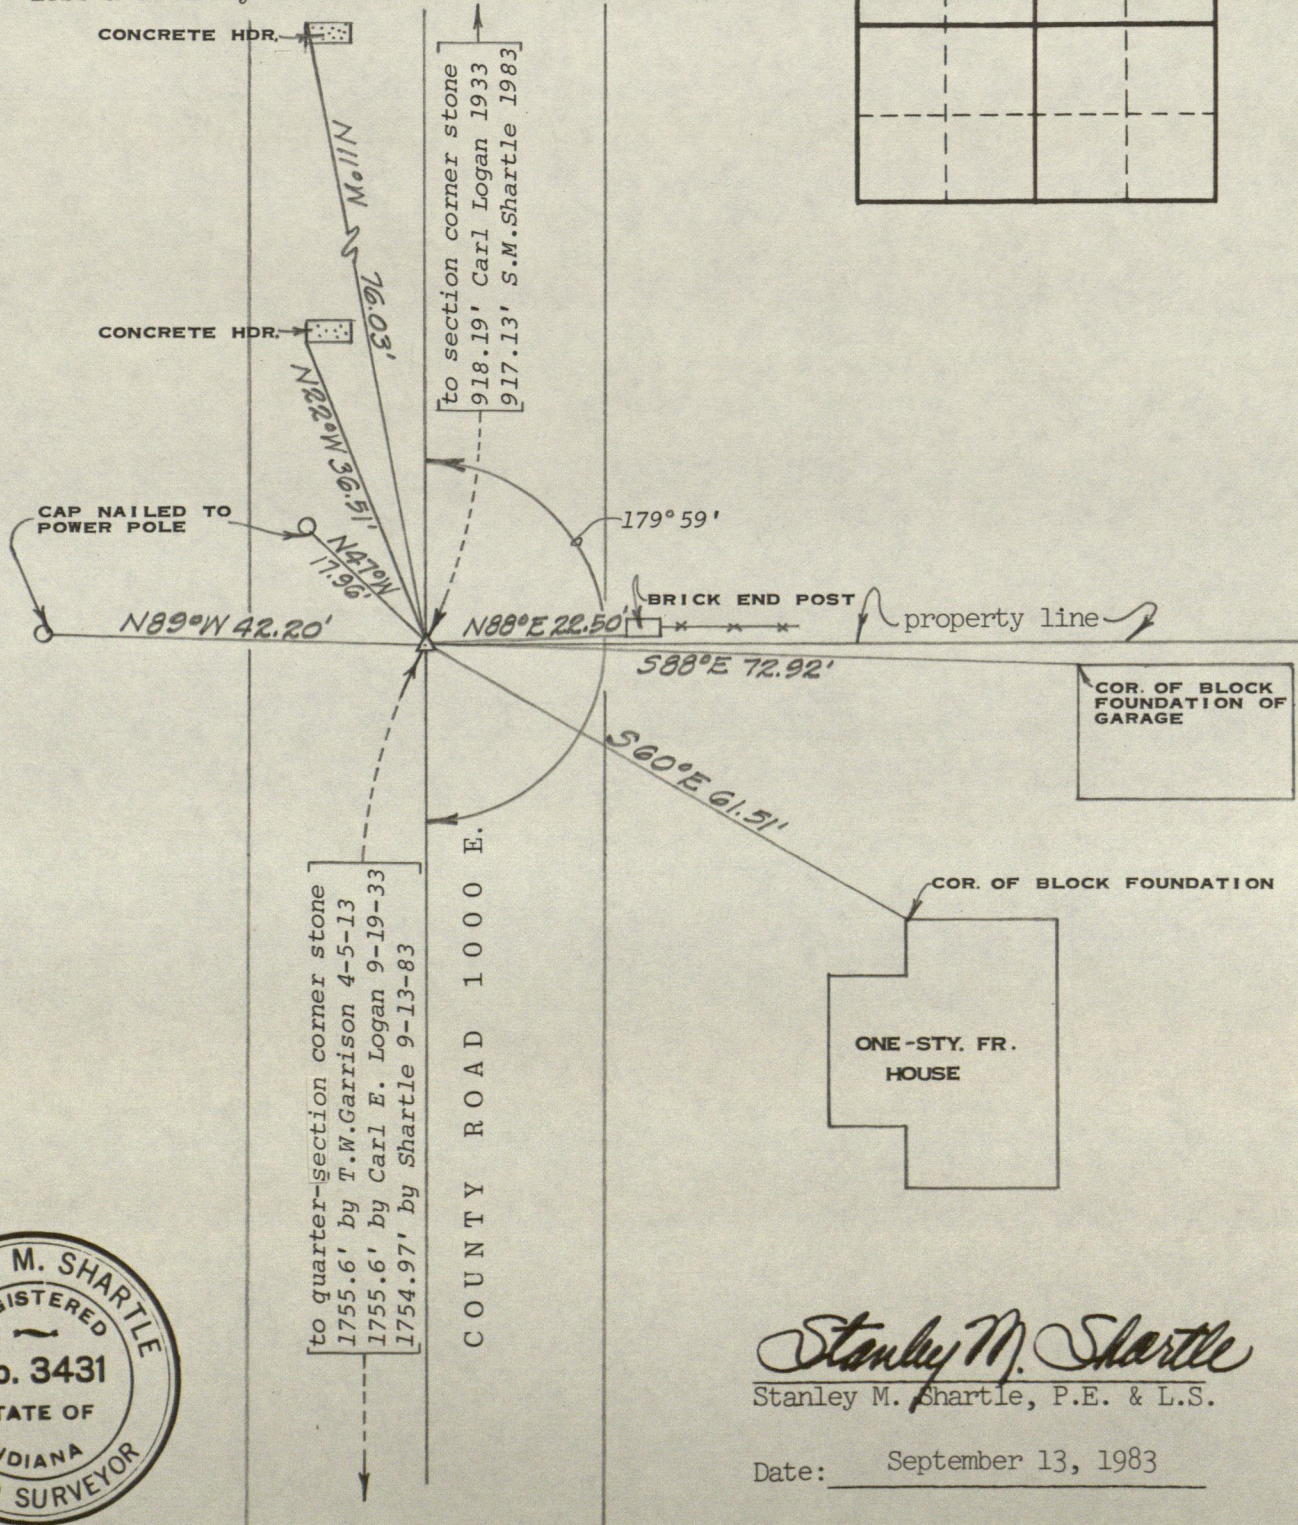

HENDRICKS COUNTY

DESIGNATION OF MARKER _____

Sec 20 T 16 N R 2E

Marker found: yes _____ no _____

Type of Marker: _____

Description: _____



Depth and Marking _____

References set: yes _____ no _____

Sketch References below.

Date: _____ Set by: _____

Comments:

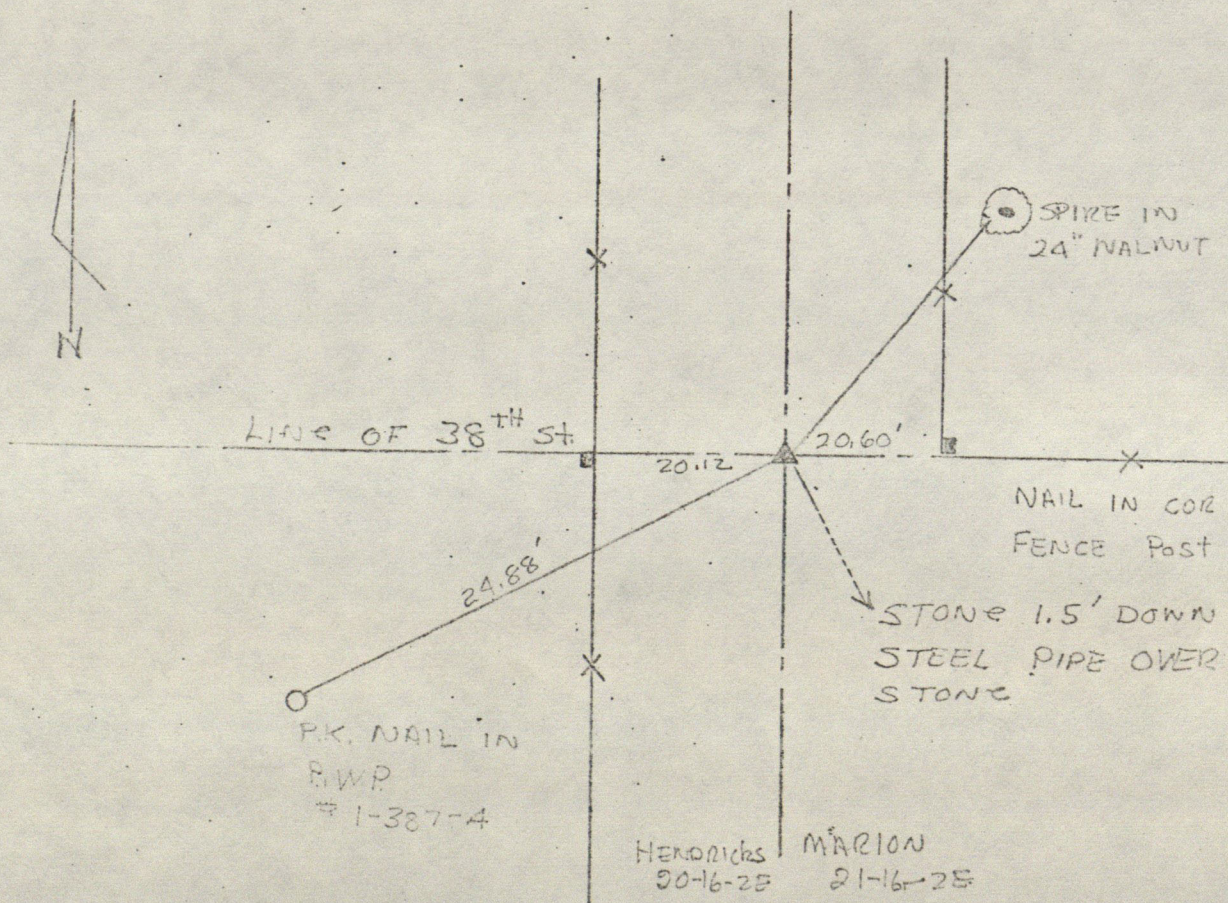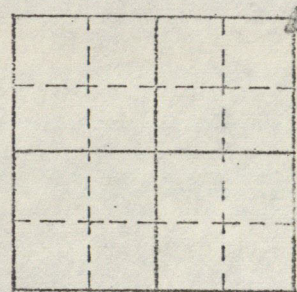

Hendricks County Surveyor

HENDRICKS COUNTY

DESIGNATION OF MARKER N.E. Corner Sec. 20 T 16 N R 2 E

Marker found: yes ☒ no ☐

Type of Marker: But Spike over Stone

Description: Stone with Steel Pipe Above Stone

Depth and Marking 1.5' below Grade

References set: yes ☐ no ☐



Sketch References below.

Date: June 15, 1970

Set by: Ray Schram

Comments:

Marion County Surveyor's Office
Certified by Gene W. Darnall

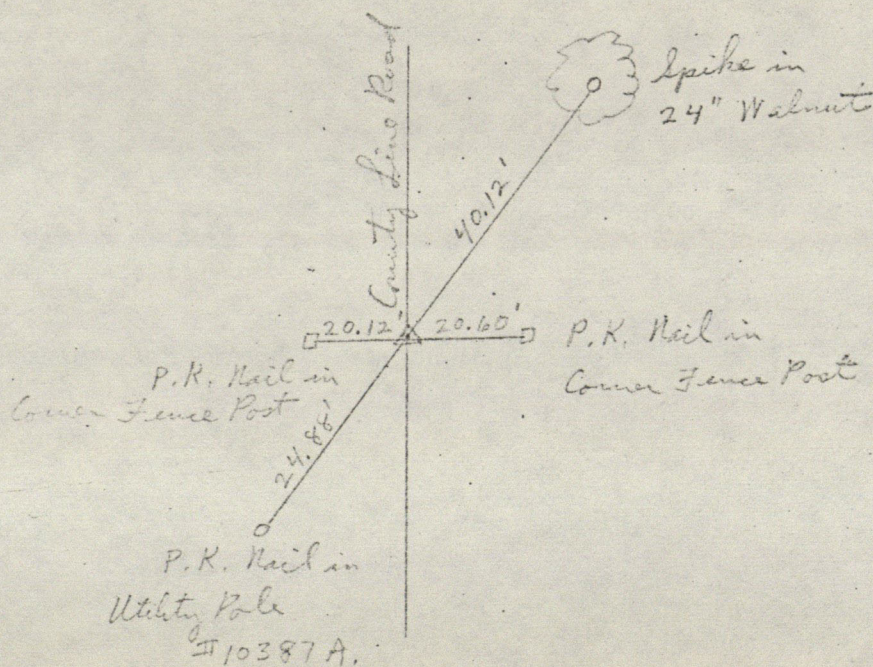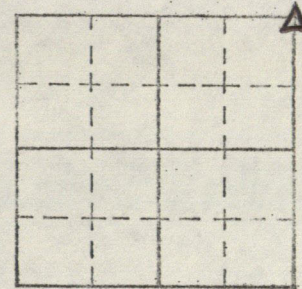


Hendricks County Surveyor

(We have 60.92)

Should be 37.52' from
Center of R.R. S to P.K.
Nail on Cty Line Rd.


COUNTY

Sec. 20 T 16 N R 2 E

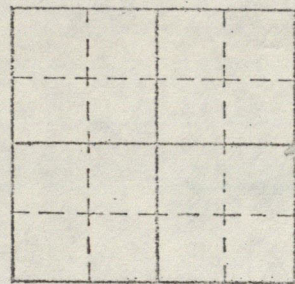

Set by: _____

N

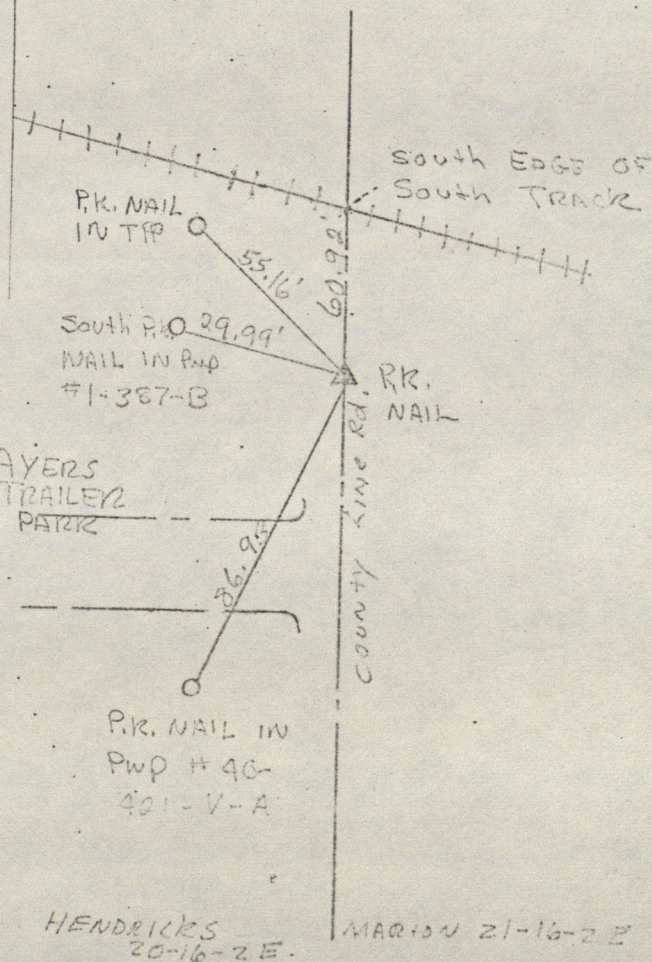

Hendricks County Surveyor

HENDRICKS COUNTY

DESIGNATION OF MARKER S.E. Corner Sec. 20 T 16 N R 2 E

Marker found: yes _____ no _____

Type of Marker: Railroad Spike

Description: P.K. Nail over Stone


Depth and Marking _____

References set: yes _____ no _____

Sketch References below.

Date: June 15, 1970 Set by: Ray Schranka

Comments: Certified by Gene W. Darnall (Macon County Surveyor's Office)

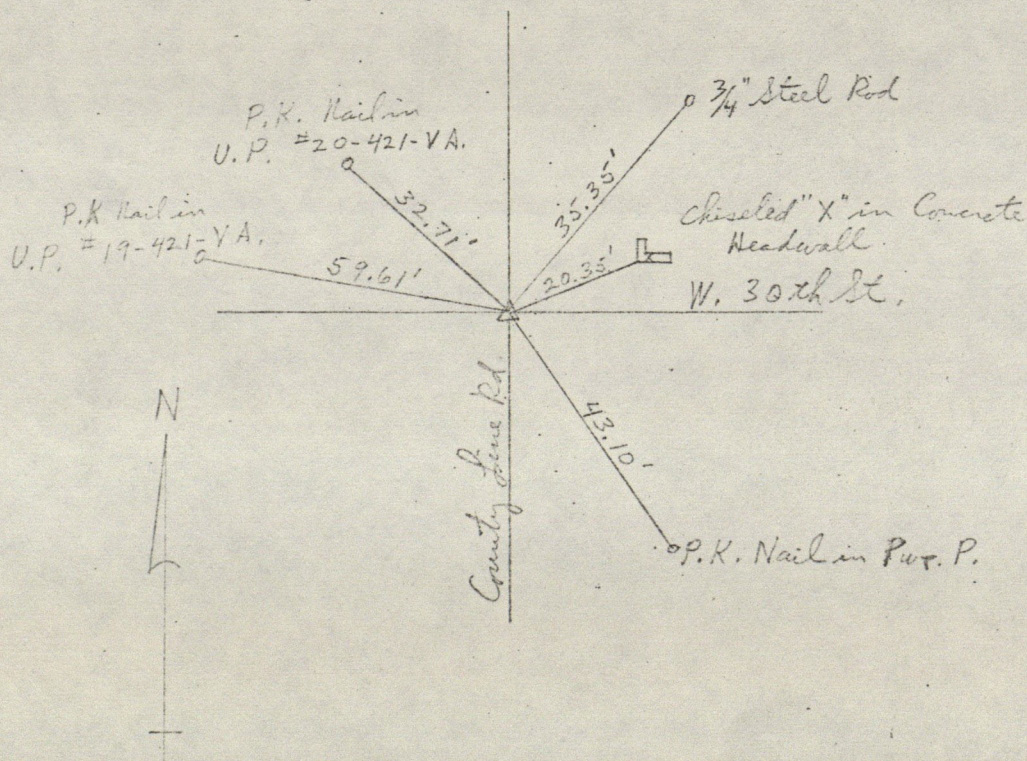

Hendricks County Surveyor

20-16-2E

Marker found: yes _____ no _____

Type of Marker: _____

Description: _____

Depth and Marking _____


References set: yes _____ no _____

Sketch References below.

Date: _____

Set by: _____

Comments:

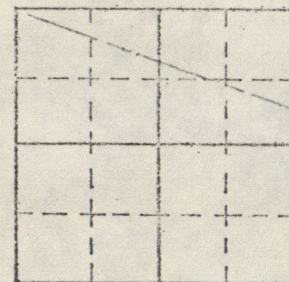

ALUM CAP
MARKED
LS 7749

PR. NAIL SIDE
T.E.P. RT-C9

55.13'

PR. NAIL E. SIDE
T.W.P. # 7-0-387-B

20-16-2E

CO. LINE RD.

HENDRICKS
TOWNSHIP


76.72'

S.E. EDGE CONC.
FORMATION WEST
OF WAYNE FEED

LS 136

PR. NAIL N. SIDE
T.E.P. BRACE POLE

21-16-2E

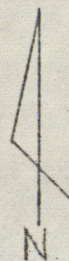

Hendricks County Surveyor

SECTION CORNER RECORD MARION COUNTY, INDIANA

Sec. 21 T. 16 R. 2E



DATE 2/14/70

DRAWN BY W. C. [unclear]

BY [unclear] Rod [unclear]

TYPE MARKER 1" K. NAIL Cond of MARKER Good

METHOD OF ESTABLISHMENT County Ties VL DATE 2/14/70

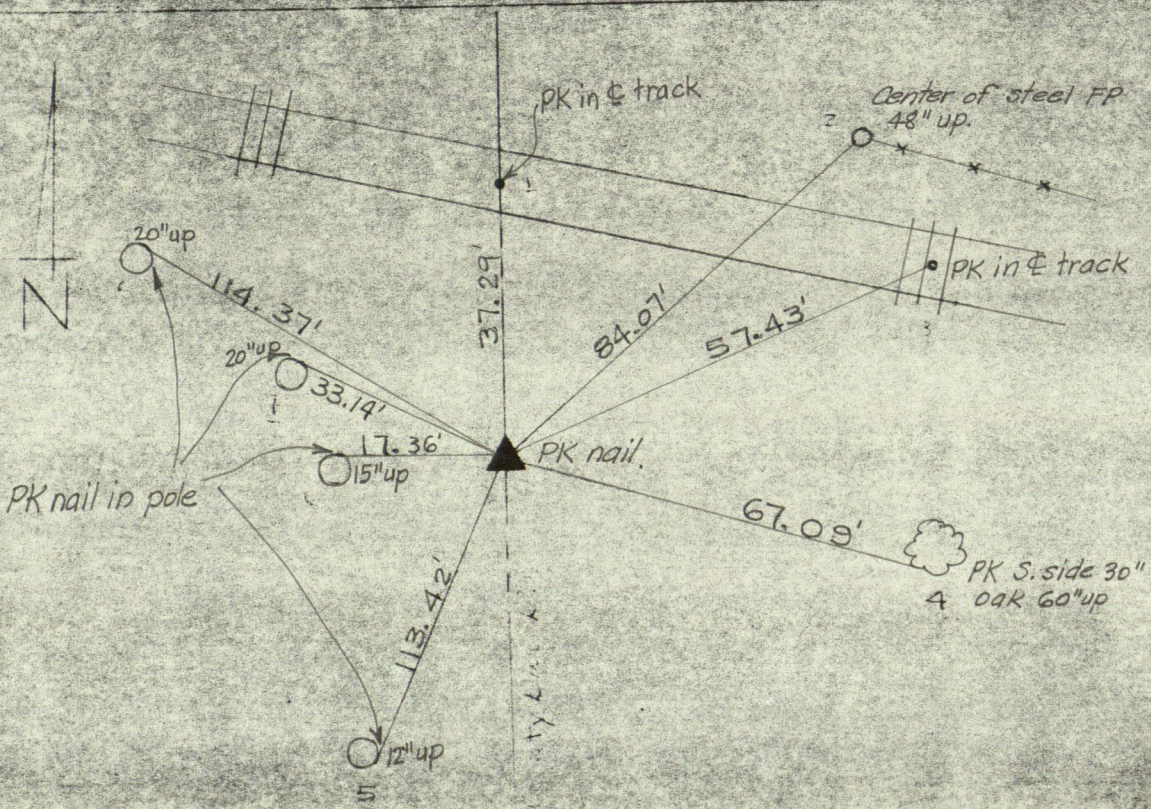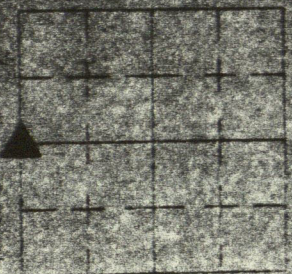

REFERENCE	DESCRIPTION
1	114.37' from PK nail to [unclear]
2	37.29' from PK nail to [unclear]
3	84.07' from PK nail to [unclear]
4	57.43' from PK nail to [unclear]
5	67.09' from PK nail to [unclear]
6	113.42' from PK nail to [unclear]
7	20" up from PK nail to [unclear]
8	33.14' from PK nail to [unclear]
9	17.36' from PK nail to [unclear]
10	15" up from PK nail to [unclear]
11	12" up from PK nail to [unclear]
12	Center of steel FP 48" up
13	PK in & track
14	PK S. side 30" 4 oak 60" up
15	County Line

DESIGNATION OF MARKER 5 1/2 mile SEC. 21 T. 16 N. 2 E

MARION COUNTY

Marker found: yes X no

Type of Marker: R/R SPIKE

Description: RUSTY

Depth and Marking: 1" DEEP



References set: yes X no

Sketch References below.

Date: 7/6/81

Set by: S. MAXWELL & R. SHAMBAUGH

Comments: DID NOT DIG UNDER SPIKE

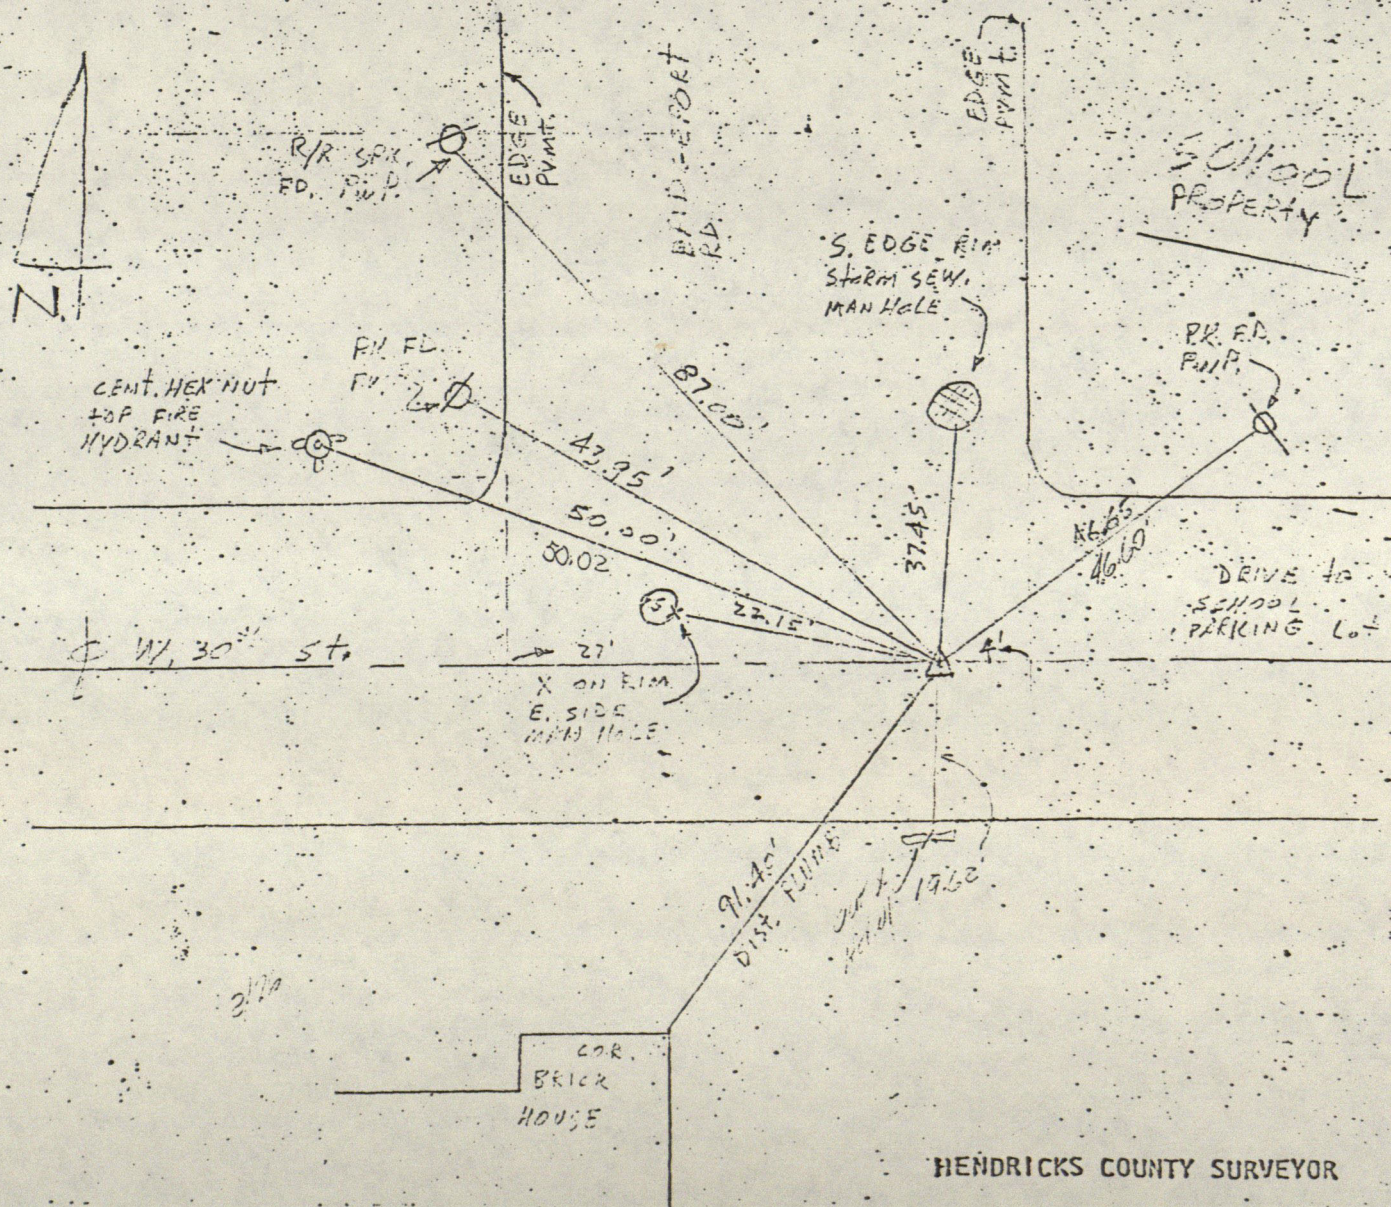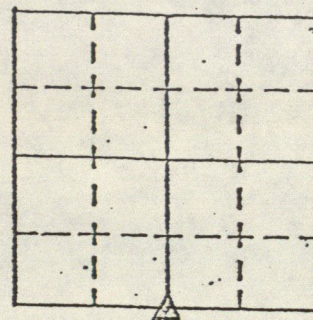

HENDRICKS COUNTY SURVEYOR

DESIGNATION OF MARKER CEN OF SEC. SEC. 21 T. 16 N R. 2 E

Marker found: yes ☒ no ☐

Type of Marker: STONE

Description: _____

Depth and Marking: 6"



References set: yes ☒ no ☐

Sketch References below.

Date: 7/6/81

Set by: S. MAXWELL & R. SHAMBAUGH

Comments: STONE FD. 6" BELOW SURFACE & SET
WOOD HUB OVER STONE. TIES ARE PLUMB

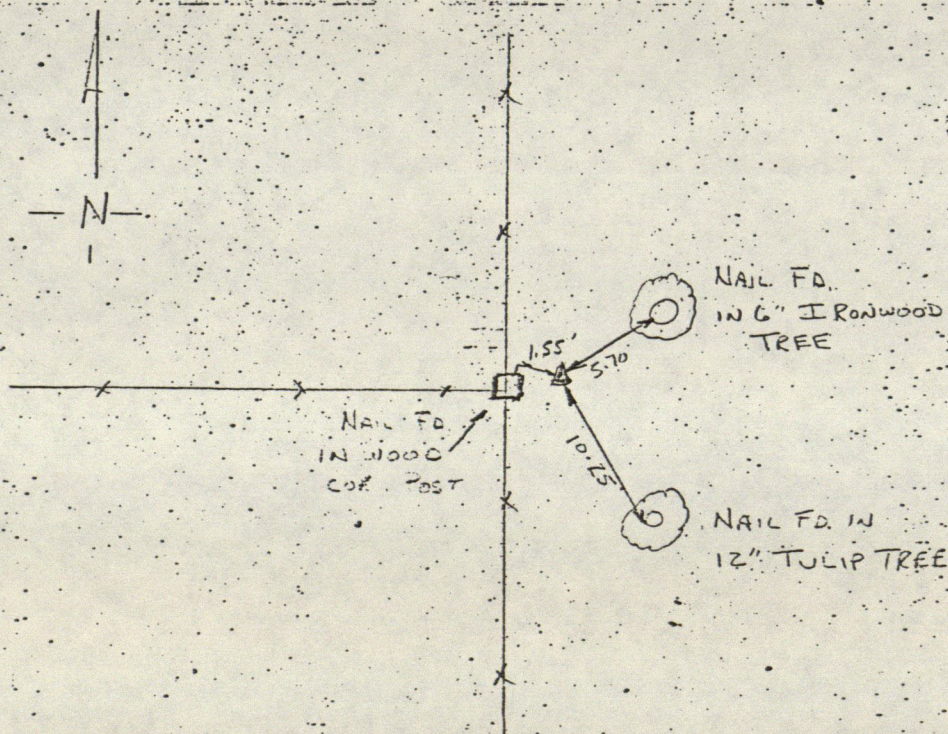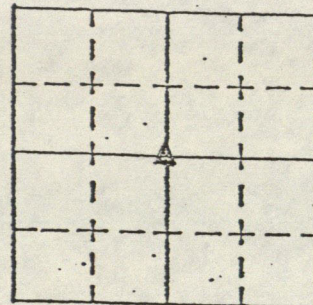

Sec. 21 T. 16 R. 2E


DATE 27/1/76

CREW P.C. 21010-11800

_____ Rod 5 (K...)

TYPE of MARKER RD NAIL Cond. of MARKER

METHOD of ESTABLISHMENT: Country Store

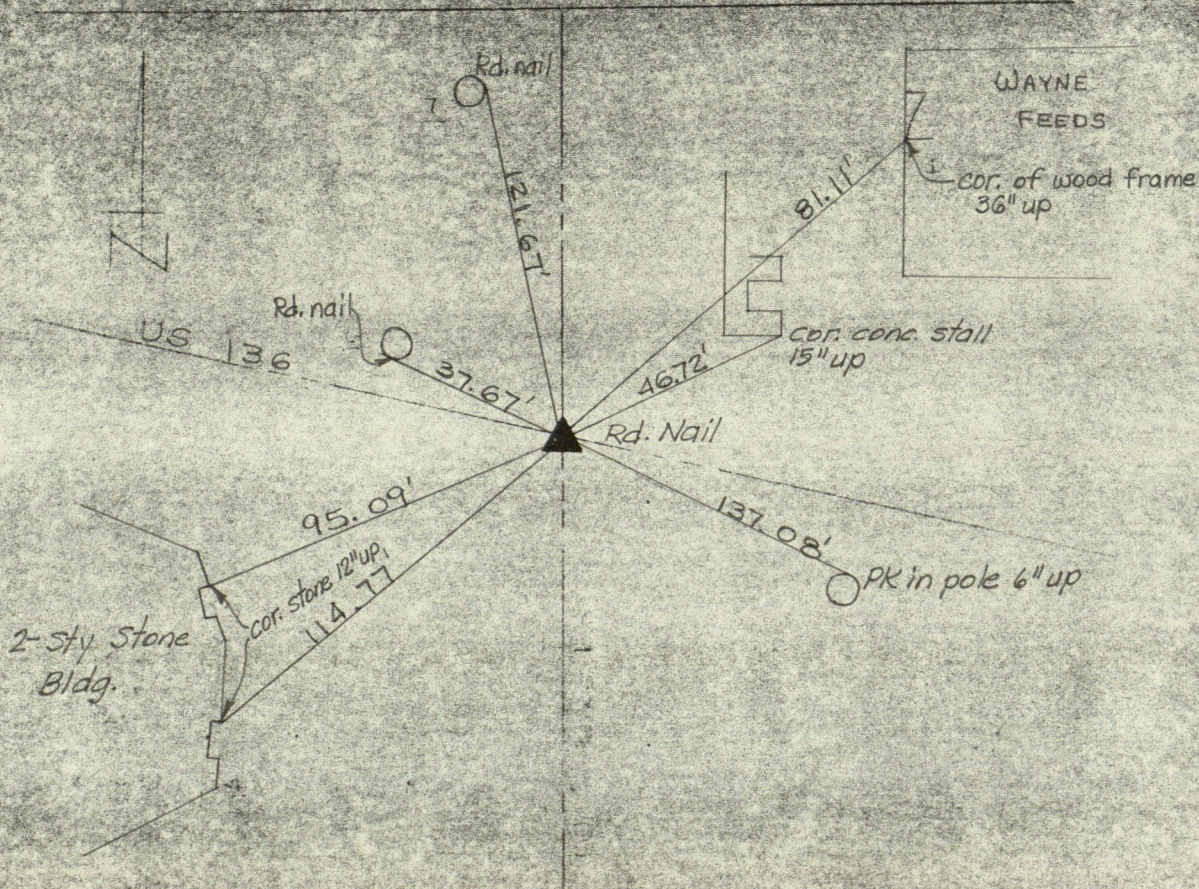

REFERENCE	STATION	DESCRIPTION
1	811500	1000 P.M.
2	811500	1000 P.M.
3	811500	1000 P.M.
4	811500	1000 P.M.
5	811500	1000 P.M.
6	811500	1000 P.M.
7	811500	1000 P.M.
8	811500	1000 P.M.
9	811500	1000 P.M.
10	811500	1000 P.M.


Sec. 21 T. 16 R. 2

CREW: PC - B. KLEINMAN

Inst - L. Hiss Rod - Mercer & Winkler

TYPE of MARKER Blue Ink Cond of MARKER Good

METHOD OF ESTABLISHMENT: Seeds (4/5/75)

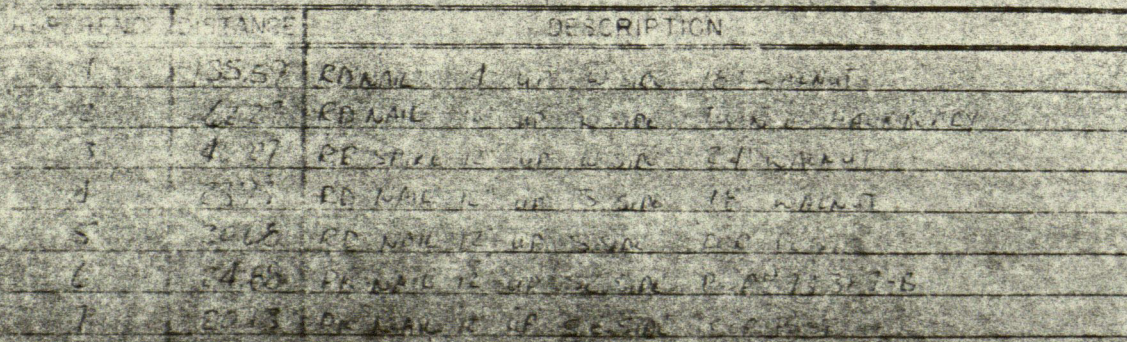

SECTION CORNER RECORD MARION COUNTY, INDIANA

Sec. 28 T. 16 R. 3


DATE 2/9/76

CREW P. C. - 2

Inst. W. V. M. R. T. Rod 3. H. M. R.

TYPE of MARKER PK nail Cond. of MARKER 3

METHOD of ESTABLISHMENT MARION COUNTY TIES (2-14-75)

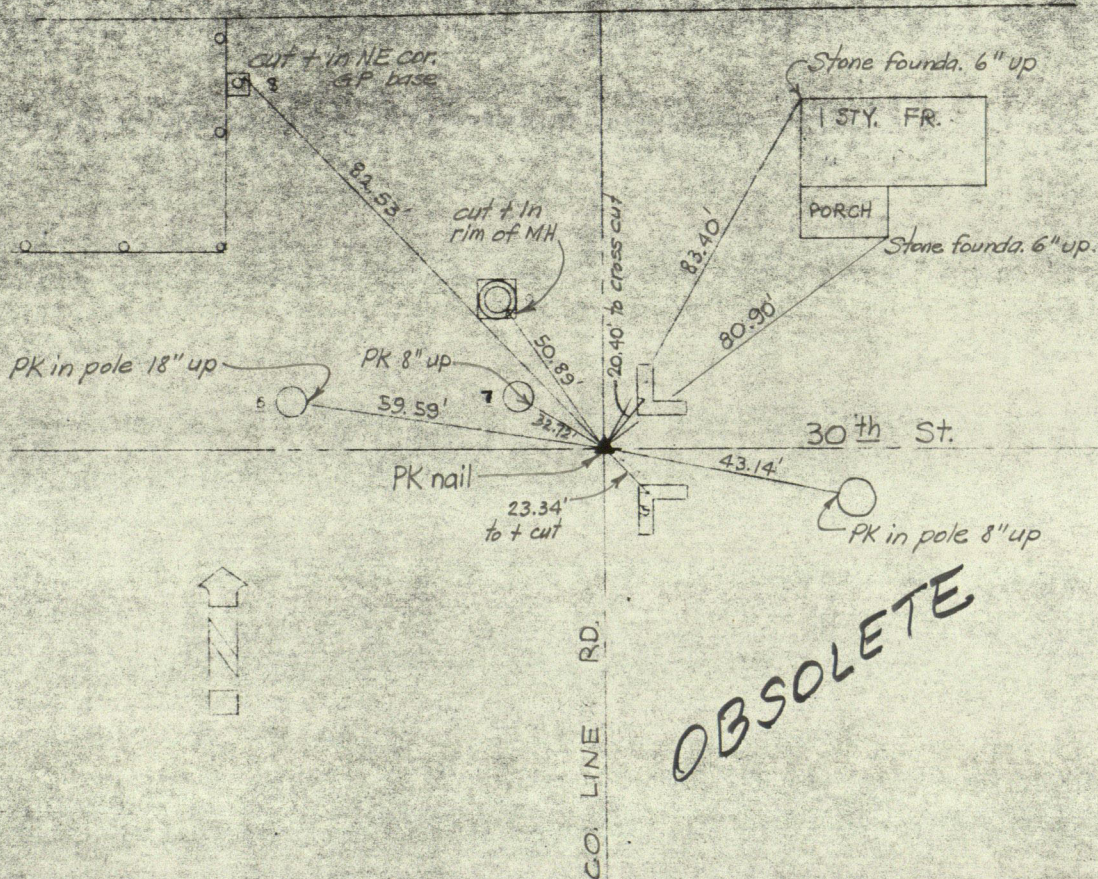

OBsolete

REFERENCE	DISTANCE	DESCRIPTION
1	84.53'	CUT + IN NE COR. GP BASE
2	50.89'	CUT + IN RIM OF MH
3	83.40'	STONE FOUND. 6" UP
4	80.90'	STONE FOUND. 6" UP
5	43.14'	PK IN POLE 8" UP
6	23.34'	TO + CUT
7	59.59'	PK 8" UP
8	38.72'	PK IN POLE 18" UP


RECORD OF CORNER

LOCATION OF MONUMENT: SECTION 29, T. 16 N., R. 2 E.

Found: Set: ☒ Depth: See below

Description: See below

Bearings to reference objects are magnetic unless a contrary mode is shown.

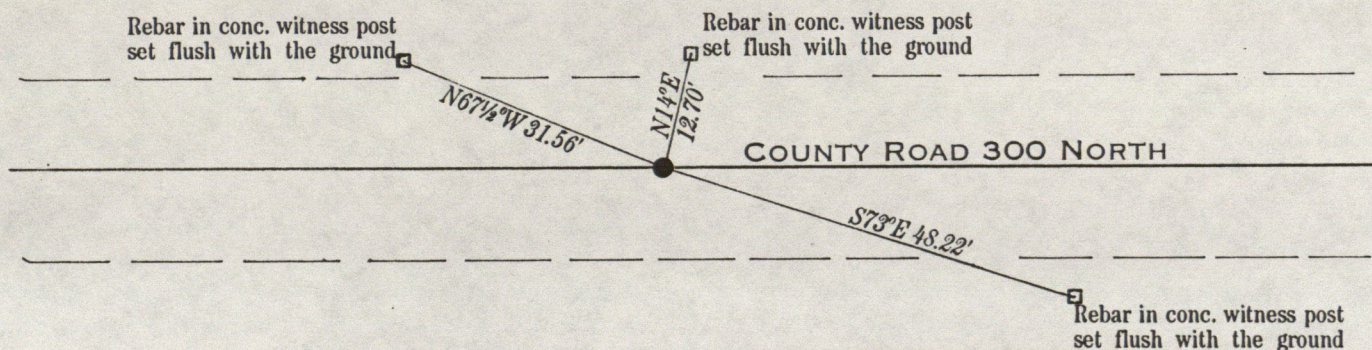

County Surveyor Eldred Huff "relocated" the North Quarter Corner of Section 29 in 1852 "by measurement" and, at that time, set the Center North of the Northeast Quarter. (Book C, page 94.) Digging on June 30, 1947, and in December 1992 has failed to uncover his North Quarter Corner but his stone at the Center North of the Northeast Quarter was found. County Surveyor John W. Trotter's stone No. 2 of his survey in 20-16-2E of the U. G. Ballard estate about 1890 was not found but his stone No. 3 was uncovered. No stone was found for the Center North of the Northwest Quarter of 29-16-2E. After carefully examining the evidence and weighing the reasons for and against a single proportionate measurement between the section corner stones to restore the quarter corner, I chose to employ a single proportionate measurement between Trotter's stone No. 3 and Huff's stone at the Center North of the Northeast Quarter based on Trotter's measurements. The corner was restored on the straight line connecting Stone No. 3 and the northeast corner of the section. Considering the aggregate of the evidence, conflicting as it may be, I believe that no other method would have restored the corner nearer to its original position. The restored corner is (1) about two feet west of the alignment of the former fence to the south, not the present chain link type fence; (2) 0.22 feet south and 3.01 feet east of the midpoint between the section corners; (3) 5.44 feet north and 2.32 feet west of a spurious axle found; (4) and 7.27 feet north and 6.73 feet west of the west end of the reproduction westward of the bearing and length of the north line of the East Half of the Northeast Quarter of Section 29.



Stanley M. Shartle
Stanley M. Shartle, P.E. & L.S.

Date: January 6, 1993

RECORD OF CORNER

LOCATION OF MONUMENT: SECTION 29, T. 16 N., R. 2 E.

Found: _____ Set: ☒ Depth: _____ See below _____

Description: _____ See below _____

Bearings to reference objects are magnetic unless a contrary mode is shown.



Rebar in conc. witness post
set flush with the ground

Rebar in conc. witness post
set flush with the ground

N67 $\frac{1}{2}$ °W 31.56'

N14°E
12.70'

COUNTY ROAD 300 NORTH

S73°E 48.22'


Rebar in conc. witness post
set flush with the ground

County Surveyor Eldred Huff "relocated" the North Quarter Corner of Section 29 in 1852 "by measurement" and, at that time, set the Center North of the Northeast Quarter. (Book C, page 94.) Digging on June 30, 1947, and in December 1992 has failed to uncover his North Quarter Corner but his stone at the Center North of the Northeast Quarter was found. County Surveyor John W. Trotter's stone No. 2 of his survey in 20-16-2E of the U. G. Ballard estate about 1890 was not found but his stone No. 3 was uncovered. No stone was found for the Center North of the Northwest Quarter of 29-16-2E. After carefully examining the evidence and weighing the reasons for and against a single proportionate measurement between the section corner stones to restore the quarter corner, I chose to employ a single proportionate measurement between Trotter's stone No. 3 and Huff's stone at the Center North of the Northeast Quarter based on Trotter's measurements. The corner was restored on the straight line connecting Stone No. 3 and the northeast corner of the section. Considering the aggregate of the evidence, conflicting as it may be, I believe that no other method would have restored the corner nearer to its original position. The restored corner is (1) about two feet west of the alignment of the former fence to the south, not the present chain link type fence; (2) 0.22 feet south and 3.01 feet east of the midpoint between the section corners; (3) 5.44 feet north and 2.32 feet west of a spurious axle found; (4) and 7.27 feet north and 6.73 feet west of the west end of the reproduction westward of the bearing and length of the north line of the East Half of the Northeast Quarter of Section 29.



Stanley M. Shartle
Stanley M. Shartle, P.E. & L.S.

Date: January 6, 1993

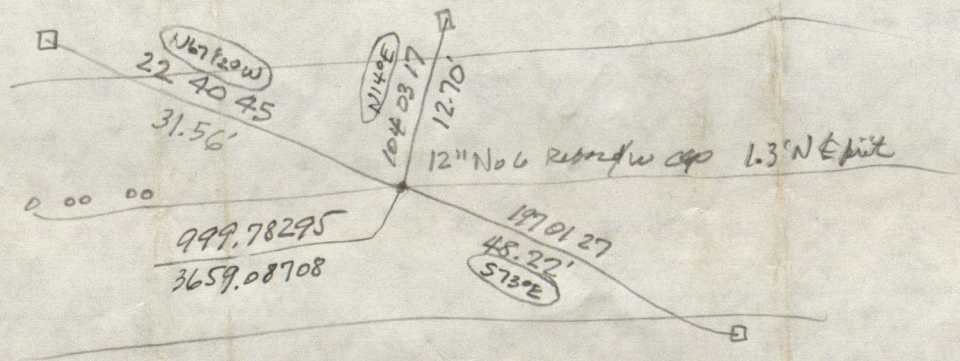



RECORD OF CORNER

LOCATION OF MONUMENT: SECTION 29, T. 16 N., R. 2 E.

Found: ☒ Set: ☐ Depth: See below

Description: See below

Bearings to reference objects are magnetic unless a contrary mode is shown.

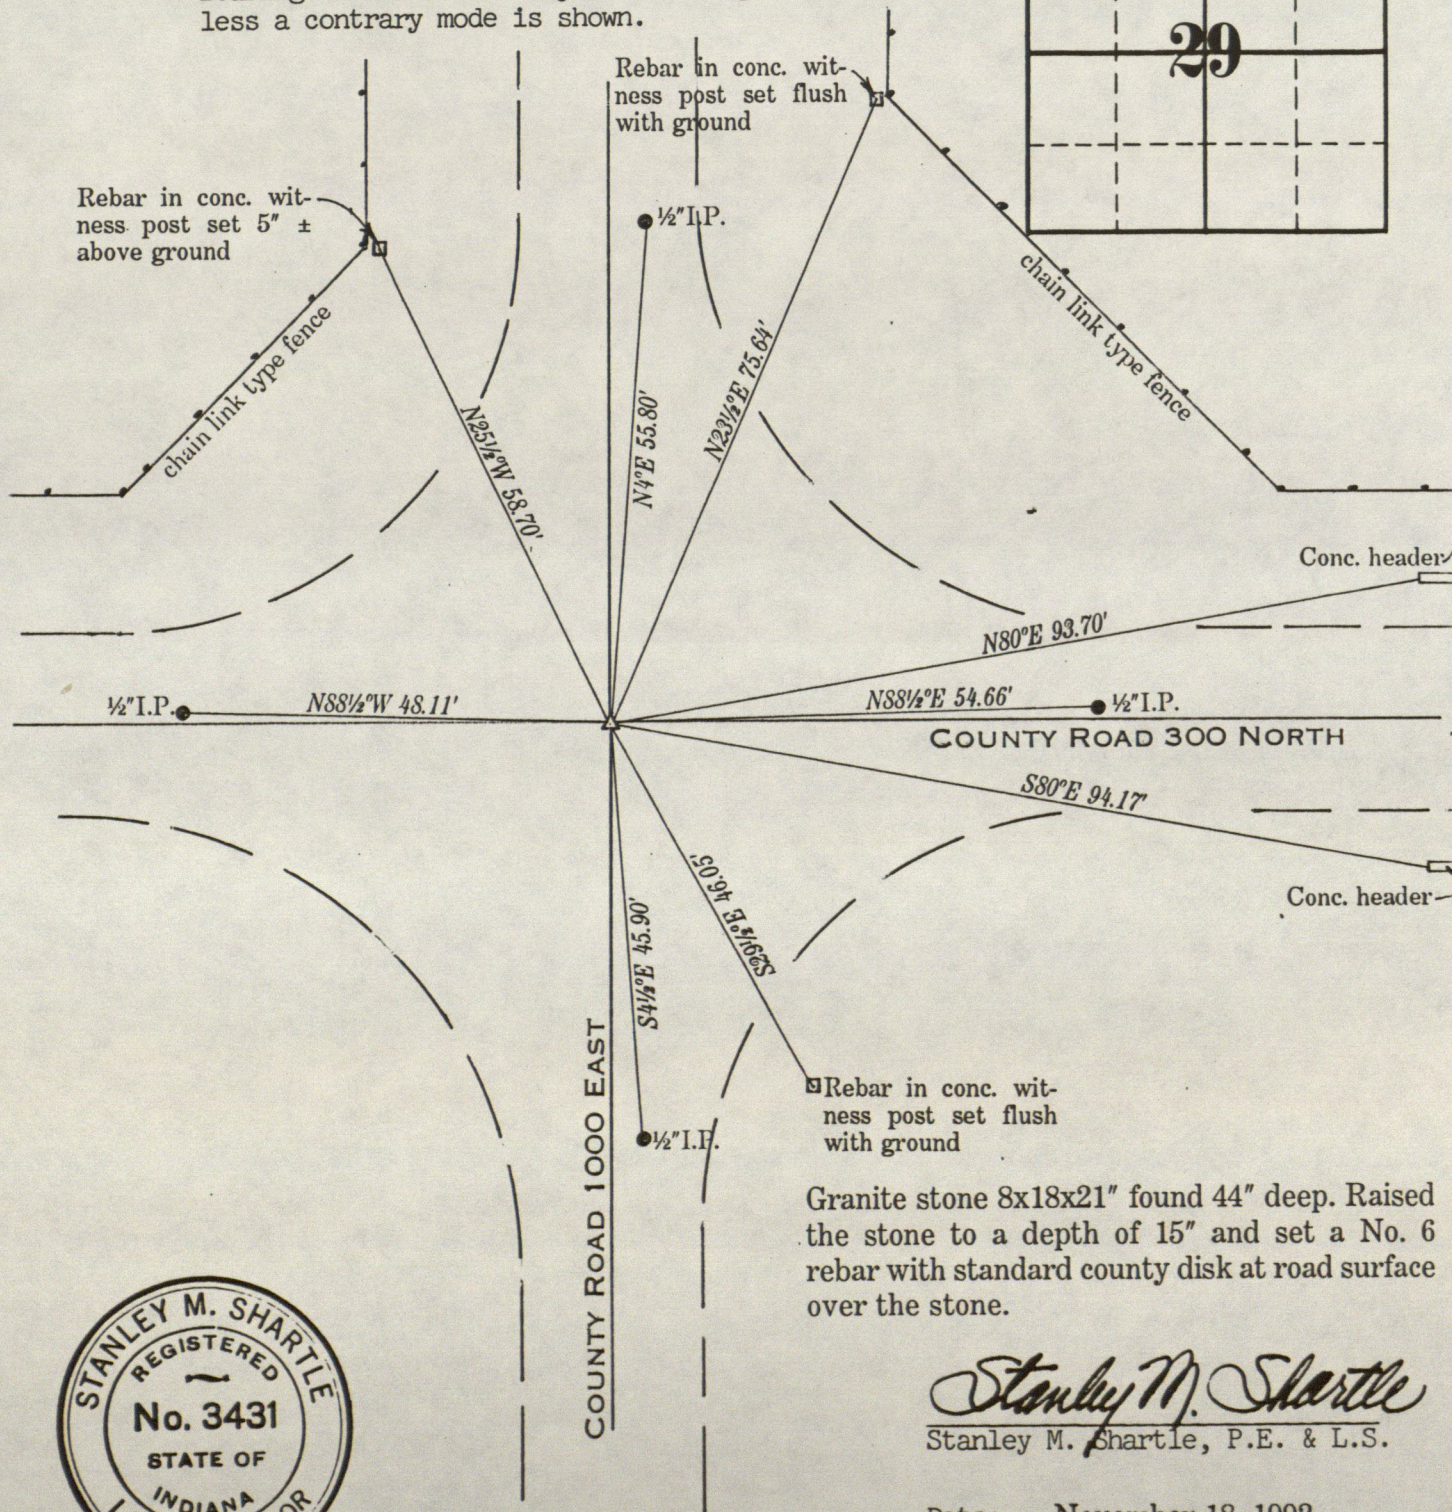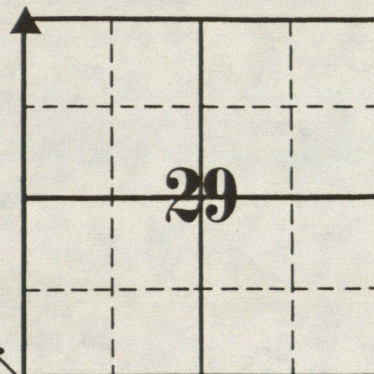

Stanley M. Shartle
Stanley M. Shartle, P.E. & L.S.

Date: November 18, 1992


RECORD OF CORNER

LOCATION OF MONUMENT: SECTION 29, T. 16 N., R. 2 E.

Found: ☒ Set: ☐ Depth: See below

Description: See below

Bearings to reference objects are magnetic unless a contrary mode is shown.

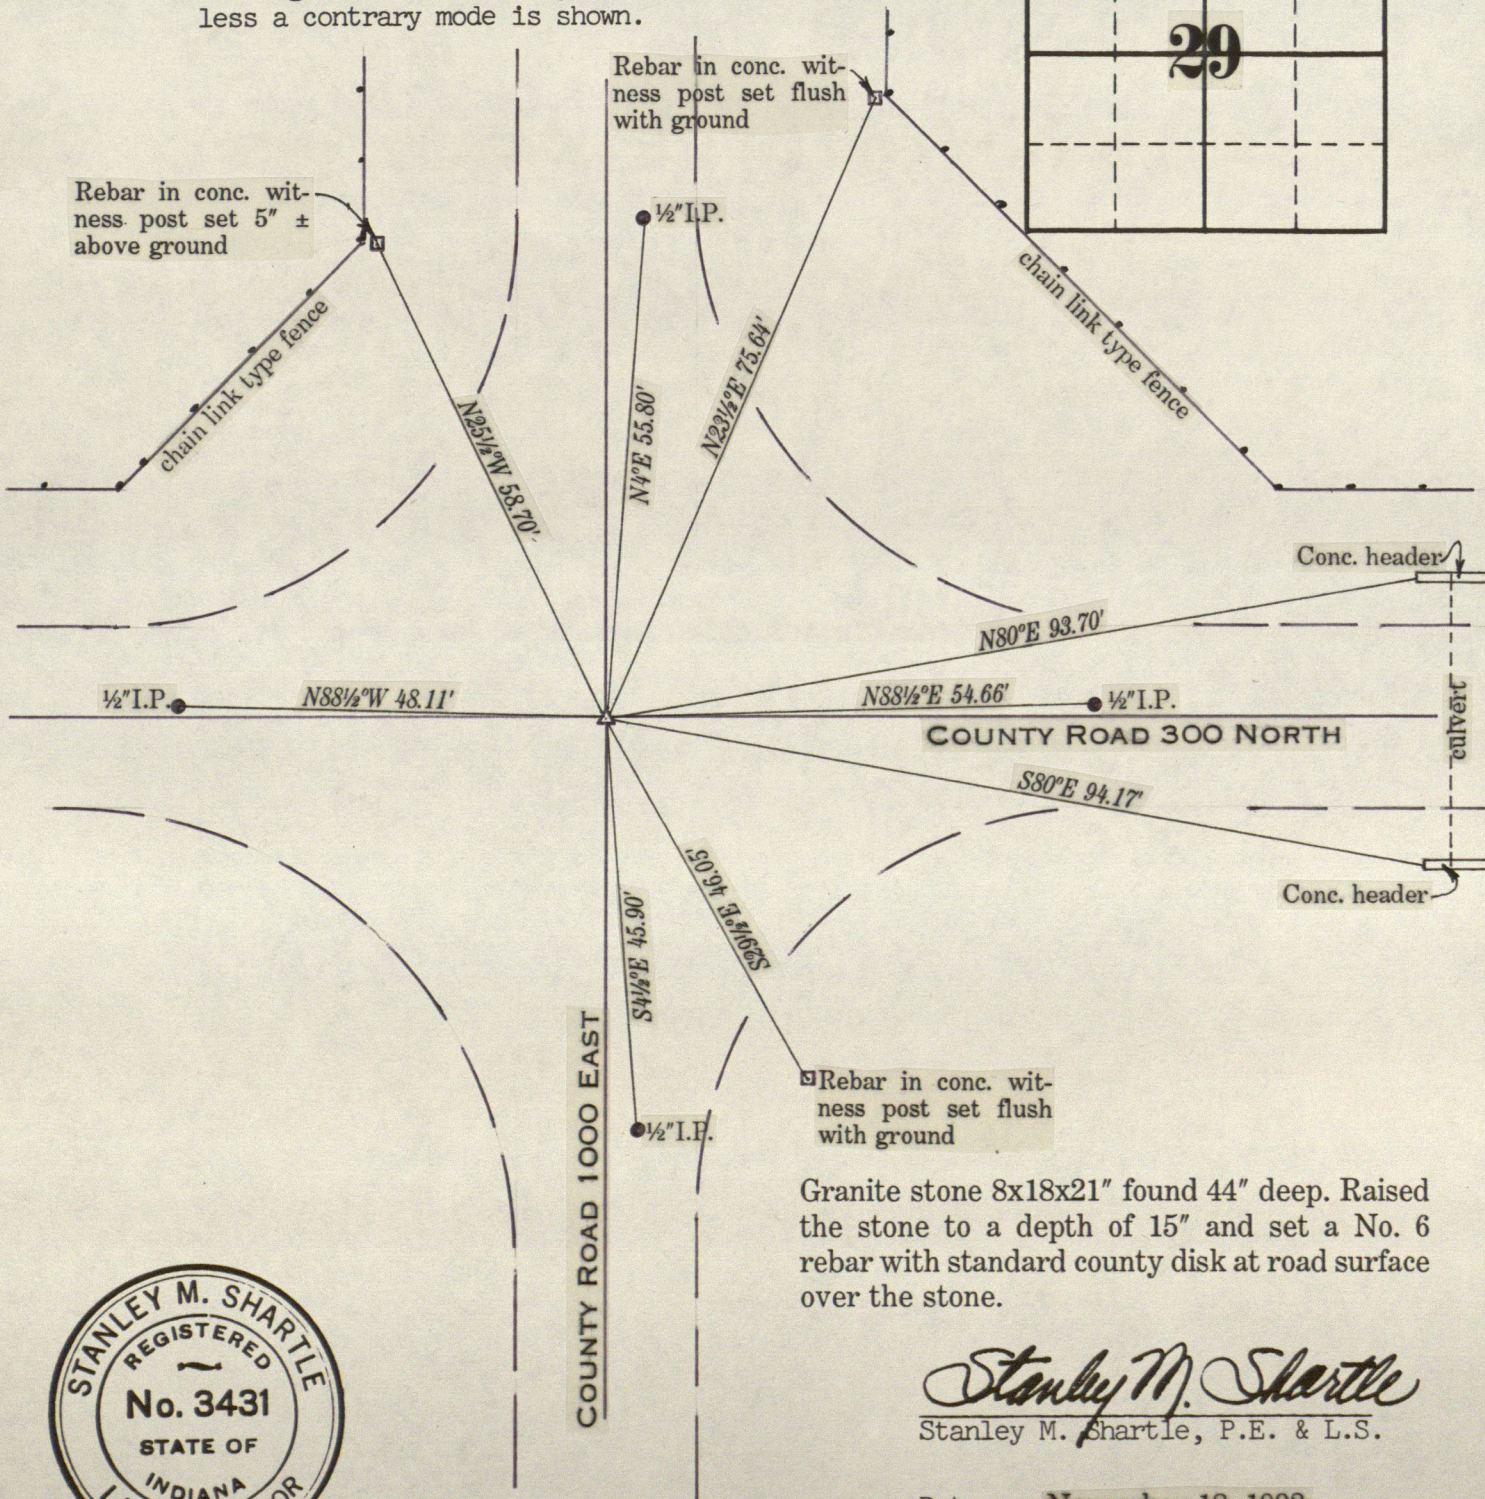


Stanley M. Shartle
Stanley M. Shartle, P.E. & L.S.

Date: November 18, 1992

TRI-POD LAND SURVEYING

RR 1, Box 211
Coatesville, IN 46121
317-386-7300

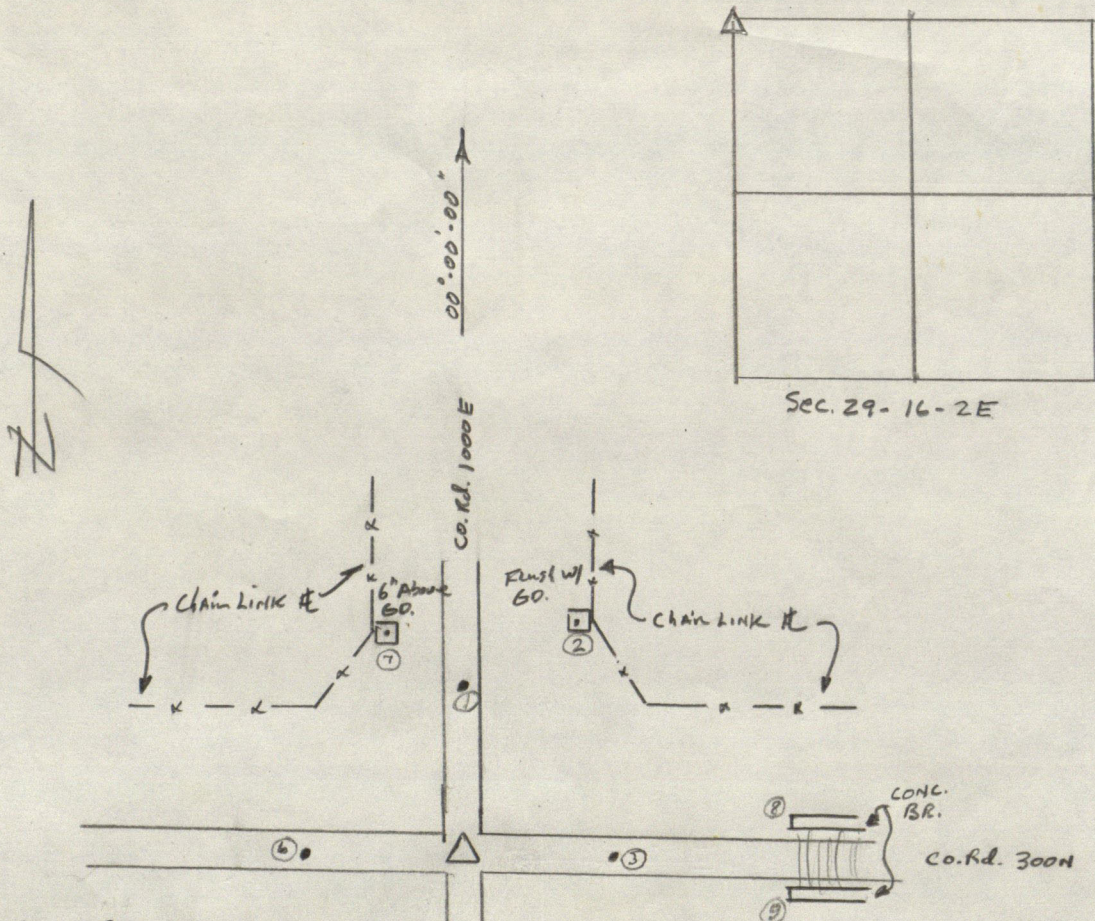

- (1) I.P.N 04°-16'-50" 55.80' (N4°E)
 (2) W. WITNESS POST 23°-37'-03" 75.64' (N23½°E)
 (3) I.P.N 88°-26'-56" 54.66' (N88½°E)
 (4) W. WITNESS POST 150°-35'-56" 46.05' (S29½°E)
 (5) I.P.N 175°-40'-10" 45.90' (S4½°E)
 (6) I.P.N 271°-30'-00" 48.11' (N88½°W)
 (7) WITNESS POST 334°-31'-01" 58.70' (N25½°W)
 (8) W. END N. CONC. HHD BR. 79°-48'-32" 93.70' (N80°E)
 (9) W. END S. CONC. HHD BR. 99°-43'-36" 94.17' (S80°E)

Flush w/6d.

NOTE: ● = 1/2" DIA. I.P.N SET
 □ = CONC. WITNESS POST SET

21" X 18" X 8" GRANITE
 STONE FD. 3.65' DEEP
 I MOVED THIS STONE TO
 15" DEEP & PLACED HEND. CO.
 DISC & REBAR ON TOP.

(I.P.N & RR SPK. FD. 24' NE
 OF STONE)


RECORD OF CORNER

LOCATION OF MONUMENT: SECTION 29, T. 16 N., R. 2 E.

Found: ☒ Set: ☐ Depth: 16 1/2 inches

Description: Unmarked stone

Bearings to reference objects are magnetic unless a contrary mode is shown.

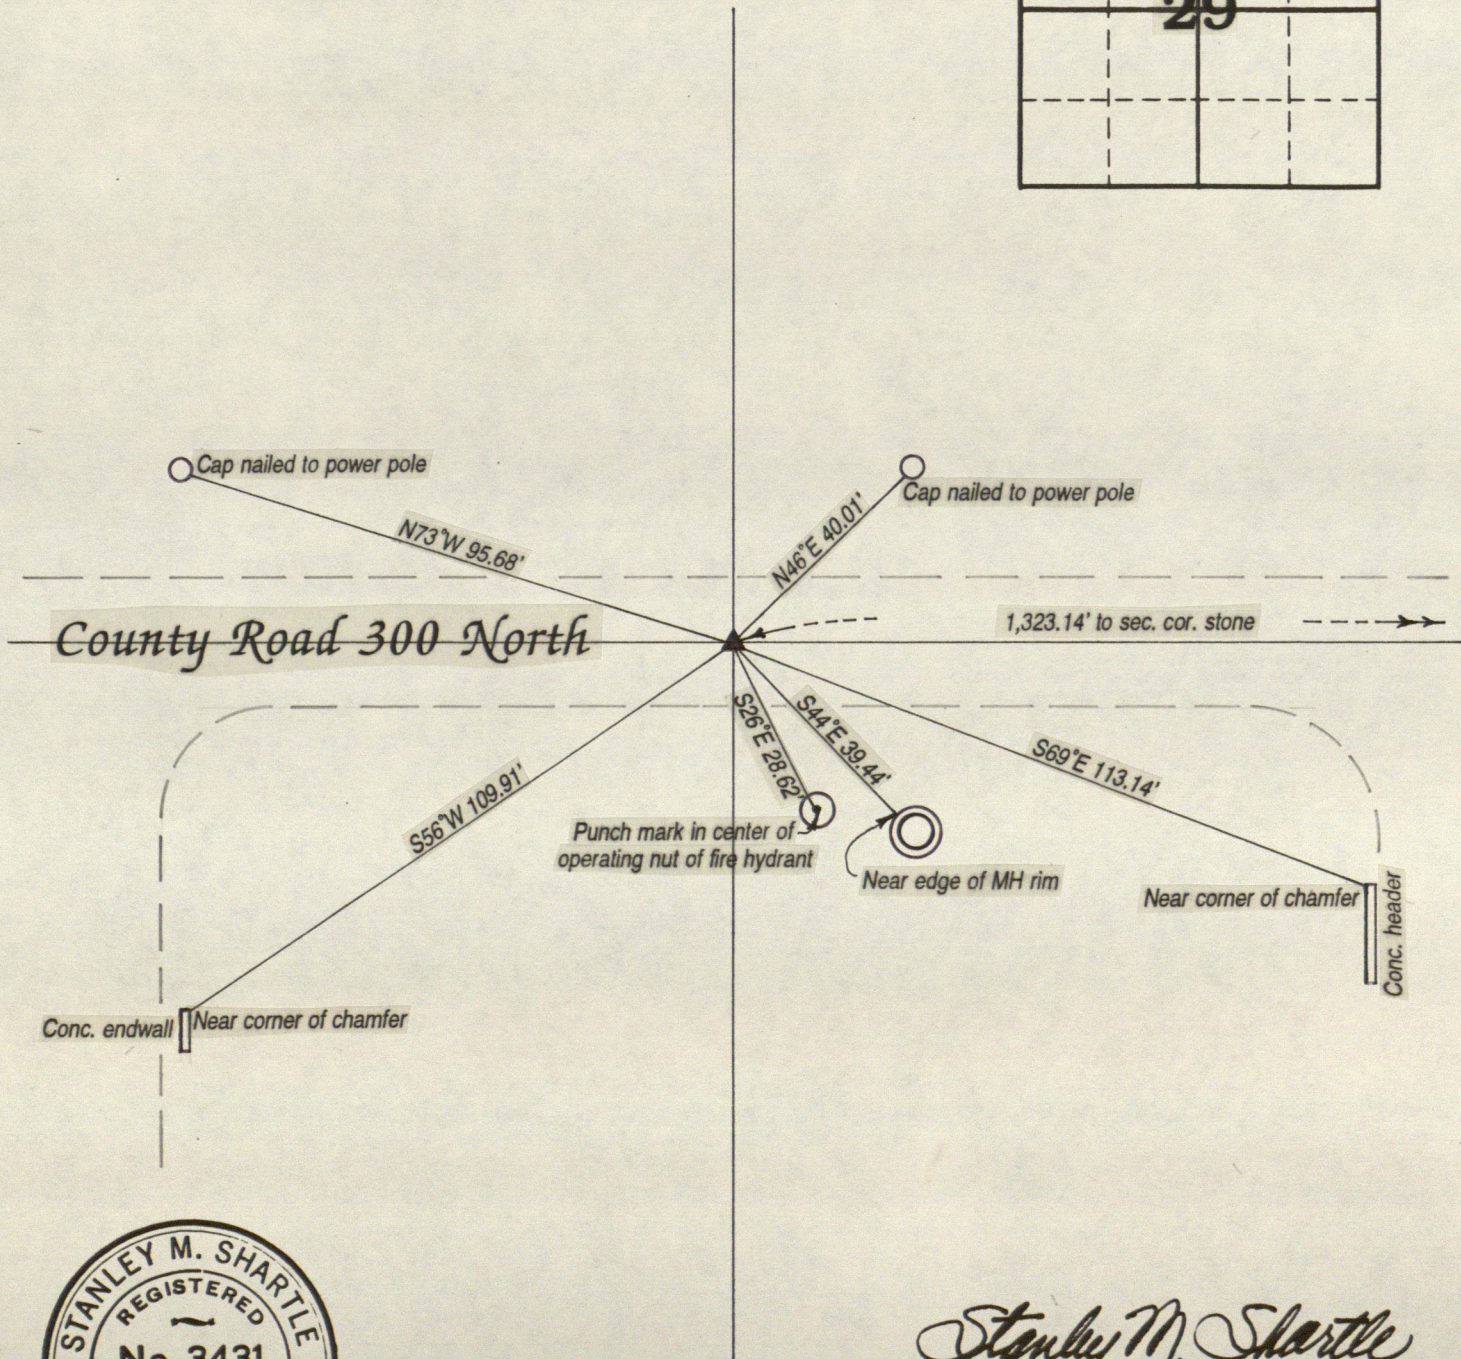

Stanley M. Shartle
Stanley M. Shartle, P.E. & L.S.

Date: February 7, 1991

STOEPPELWORTH AND ASSOCIATES INC.

9940 ALLISONVILLE ROAD

CONSULTING ENGINEERS



P. O. BOX 50296

INDIANAPOLIS, INDIANA 46250

TELEPHONE (317) 849-5935

SECTION 29 T16N R2E

STONE FOUND WITH CUT "4" 0.7' DEEP

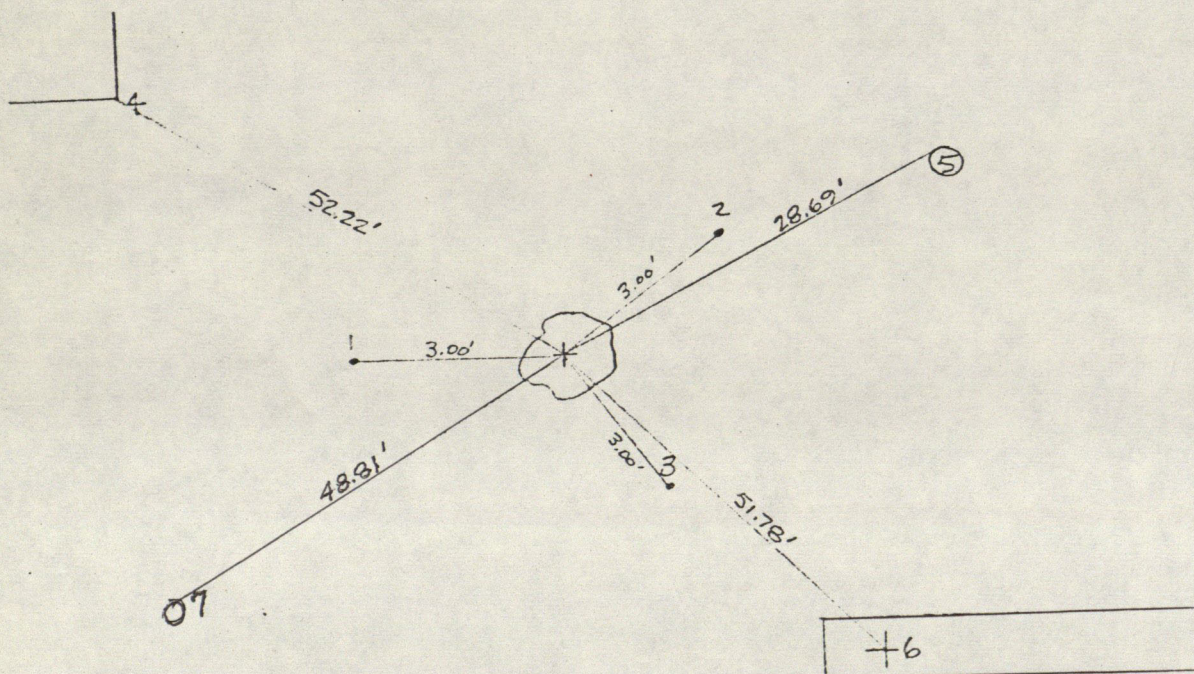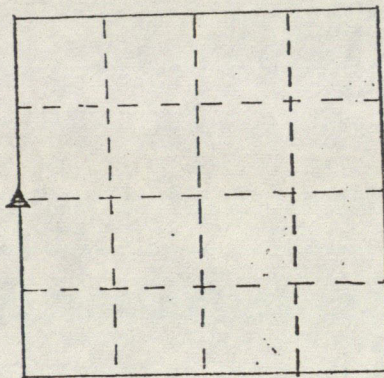

1 MASONRY NAIL 3.00'

2 MASONRY NAIL 3.00'

3 MASONRY NAIL 3.00'

4 S.E. CORNER HOUSE AT FOUNDATION 52.22'

5 P.K. NAIL LOCATED AT N.W. CORNER OF A POST (PART OF THE SIGN PLANTER) 28.69'



6 CUT "4" 0.6' EAST OF THE WEST END OF CURBING (SOUTH SIDE OF ENTRANCE) 51.78'

7 P.K. NAIL N.W. CORNER OF PWP # Z48 (13' HIGH) 43.81'

STON DUG AND WITNESSED BY DAVID STOE PPELWORTH, P.E. AND L.S. AND DON BALEN
SHARP WITNESSED BY DAVE ROBERSON (COUNTY SURVEYORS OFFICE)

29
SECTION ~~19~~ - 16N - 2E

Stone found 0.8' -deep
boat spike found on top.
11-20-78 ties set by
S. Maxwell & R. Shambaugh

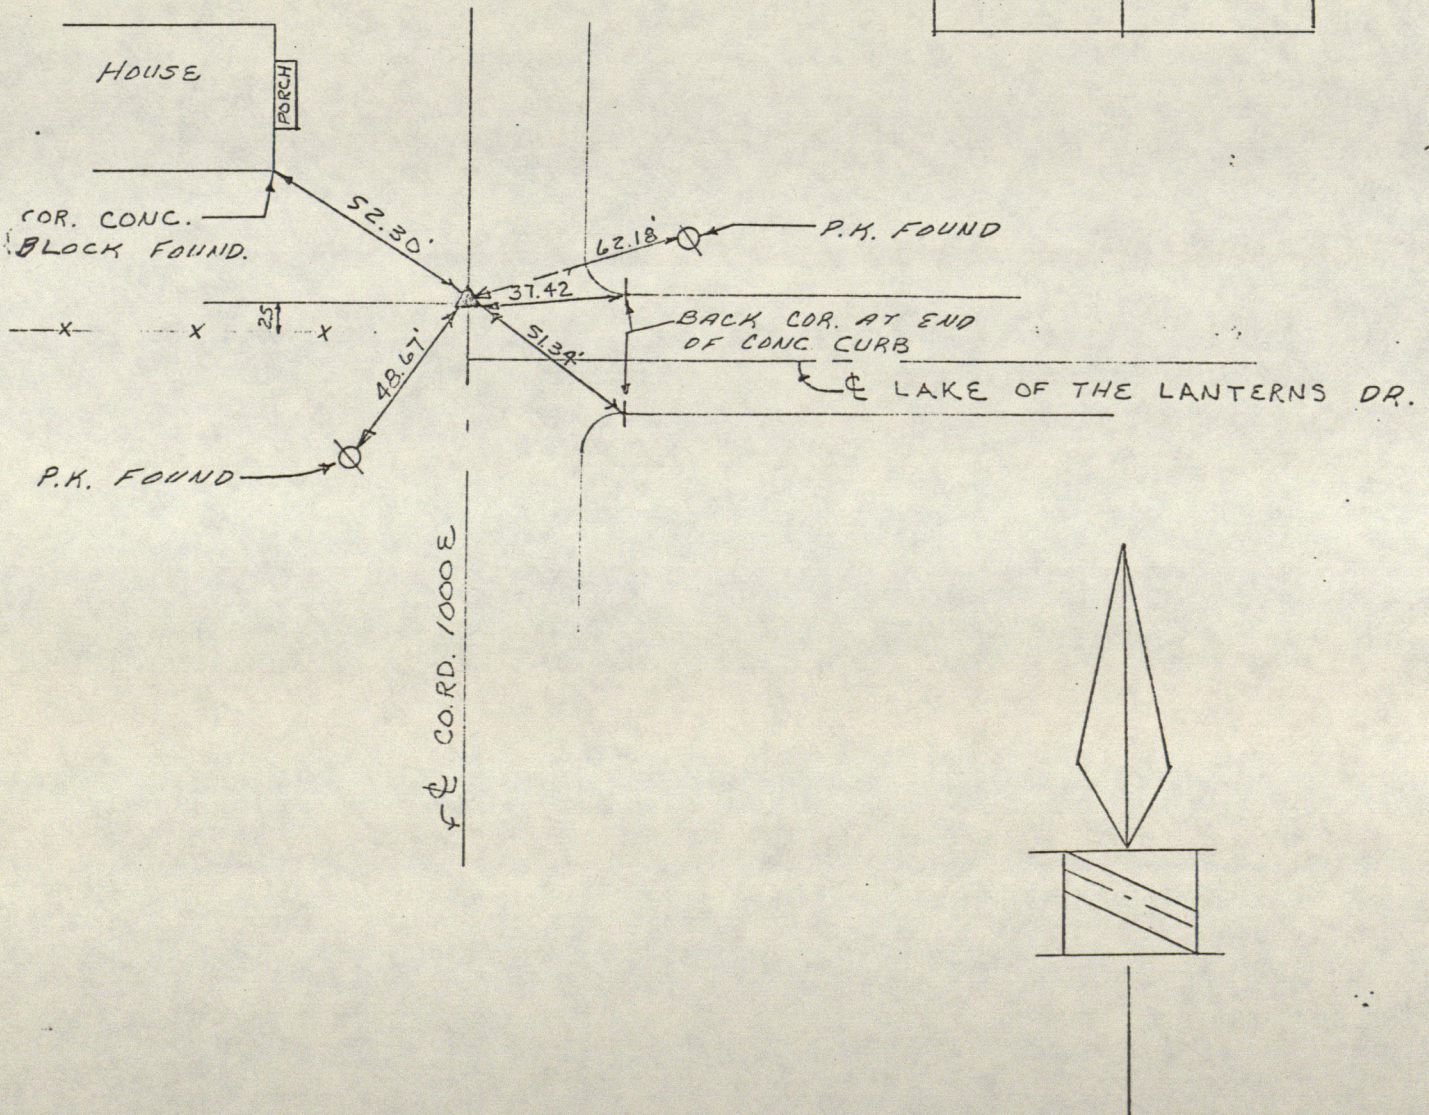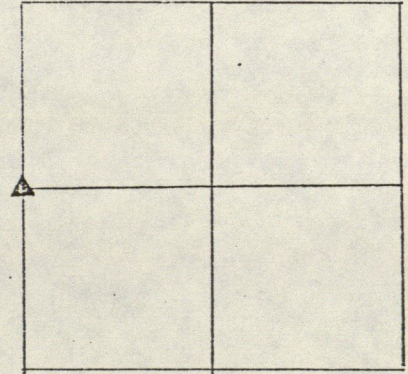

RECORD OF CORNER

LOCATION OF MONUMENT: SECTION 29, T. 16 N., R. 2 E.

Found: ☒ Set: ☐ Depth: 12 inches


Description: See description below

Bearings are magnetic and are corrected for declination. Distances are horizontal and are corrected to 68°F.

DESCRIPTION OF STONE

This 18x20x30" stone was lowered 9 inches by S. M. Shartle on October 10, 1946, because it protruded from the surface and hindered road maintenance. The cross cut by him for the corner is still visible.

Cap nailed to power pole

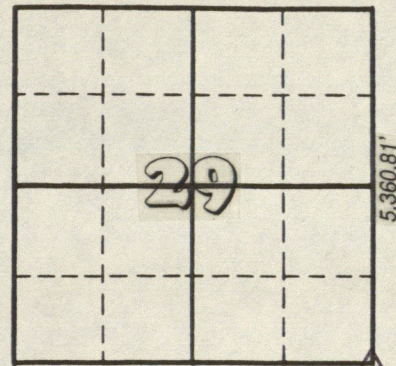

COUNTY

County Road 200 North

21st Street

COUNTY

HENDRICKS

S29°W 89.31'

S55°E 79.595'
S35°E 79.425'

stone façade

S6°W 148.66'

stone façade

Memorial Park Cemetery
& Mausoleum (West)


MARION

Raceway Road

Salem Primitive
Baptist Church
(FRAME BUILDING)

Corner board

Cap nailed to power pole

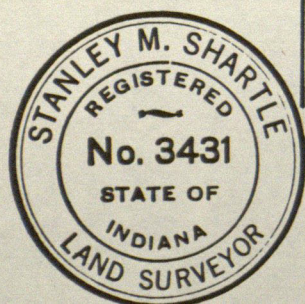

Stanley M. Shartle
Stanley M. Shartle, P.E. & L.S.

Date: February 4, 1991


RECORD OF CORNER

LOCATION OF MONUMENT: SECTION 29, T. 16 N., R. 2 E.

Found: ☒ Set: ☐ Depth: 16 inches

Description: Unmarked stone


Bearings are magnetic and are corrected for declination. Distances are horizontal and are corrected to 68°F.

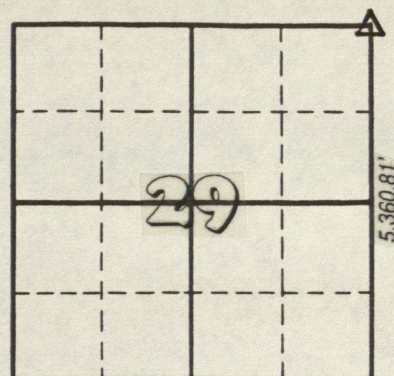

HENDRICKS COUNTY

Raceway Road

MARION COUNTY

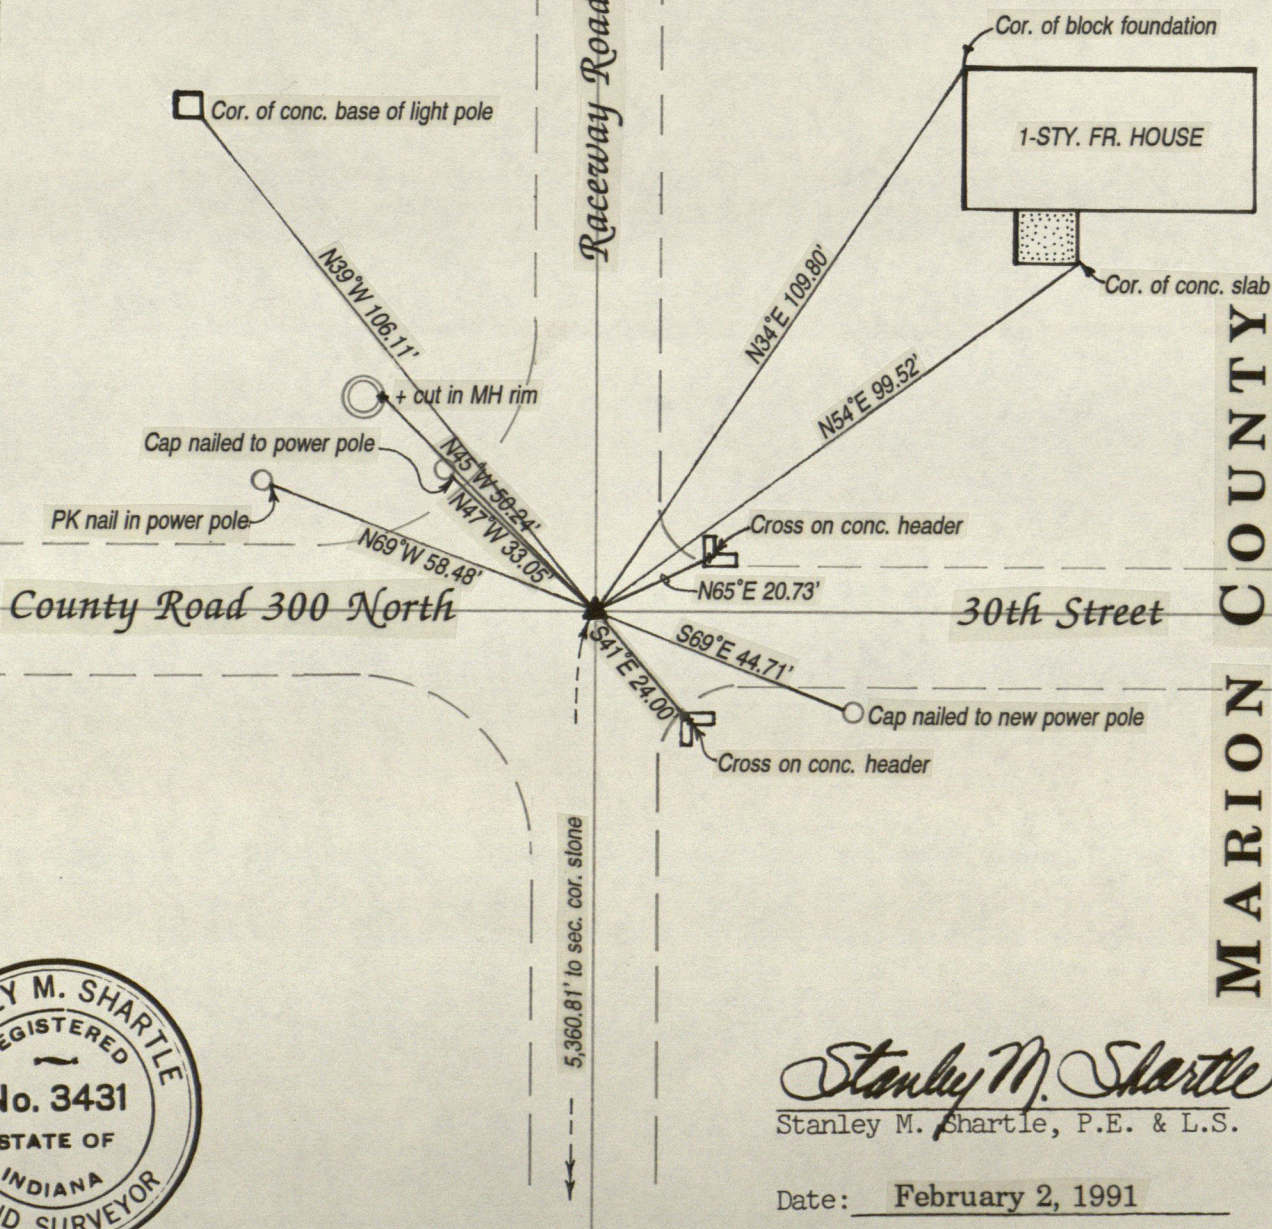

Stanley M. Shartle
Stanley M. Shartle, P.E. & L.S.

Date: February 2, 1991

HENDRICKS COUNTY

DESIGNATION OF MARKER _____ Sec. 29 T 16 N R 2 E

Marker found: yes _____ no _____

Type of Marker: _____

Description: _____



Depth and Marking _____

References set: yes _____ no _____

Sketch References below.

Date: _____ Set by: _____

Comments:


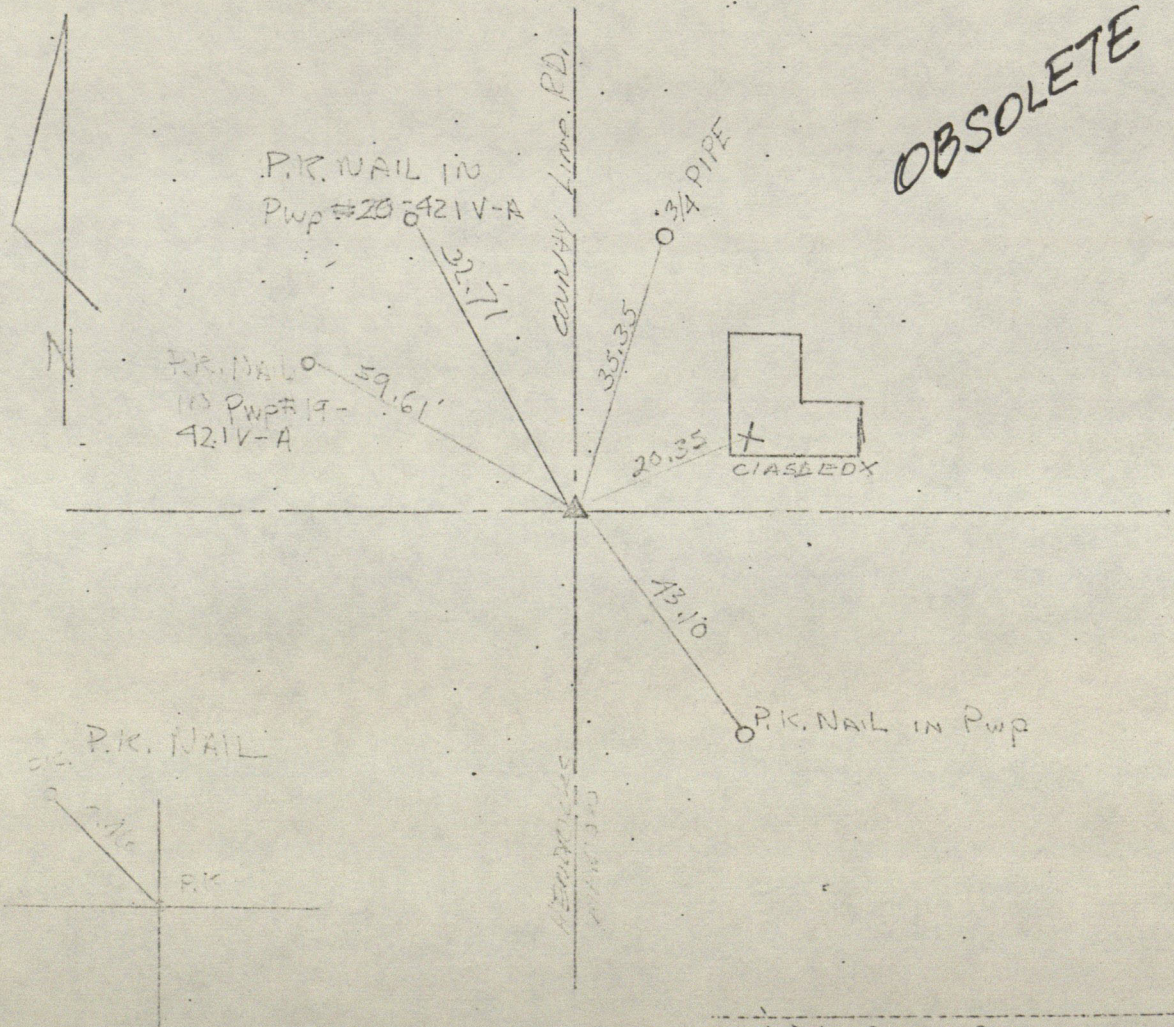
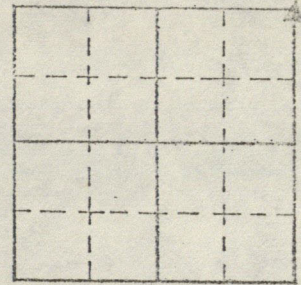


Hendricks County Surveyor

HENDRICKS COUNTY


Designation of Marker Sw Cor Sec. 28 Twp. 16 Range 2E
S.E. Corner 29

OBsolete

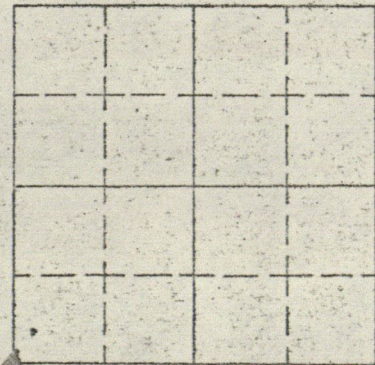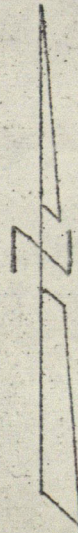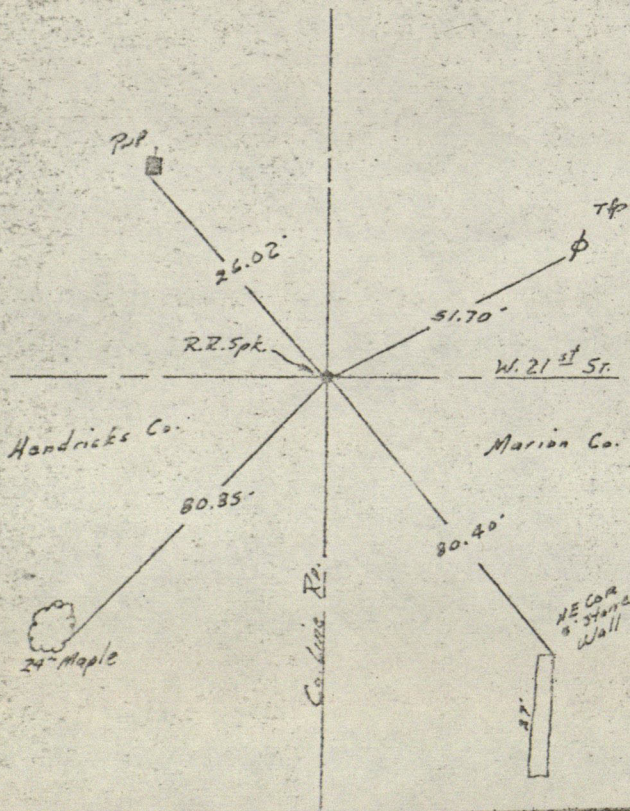


S.W. COR., SEC. 28-16-2E

Attn
Stan Shurtle

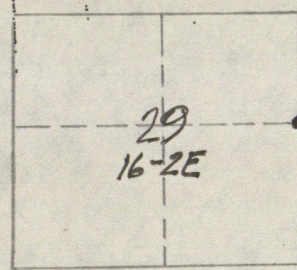

PROJ. NO. _____ LINE _____


PAGE ____ OF ____

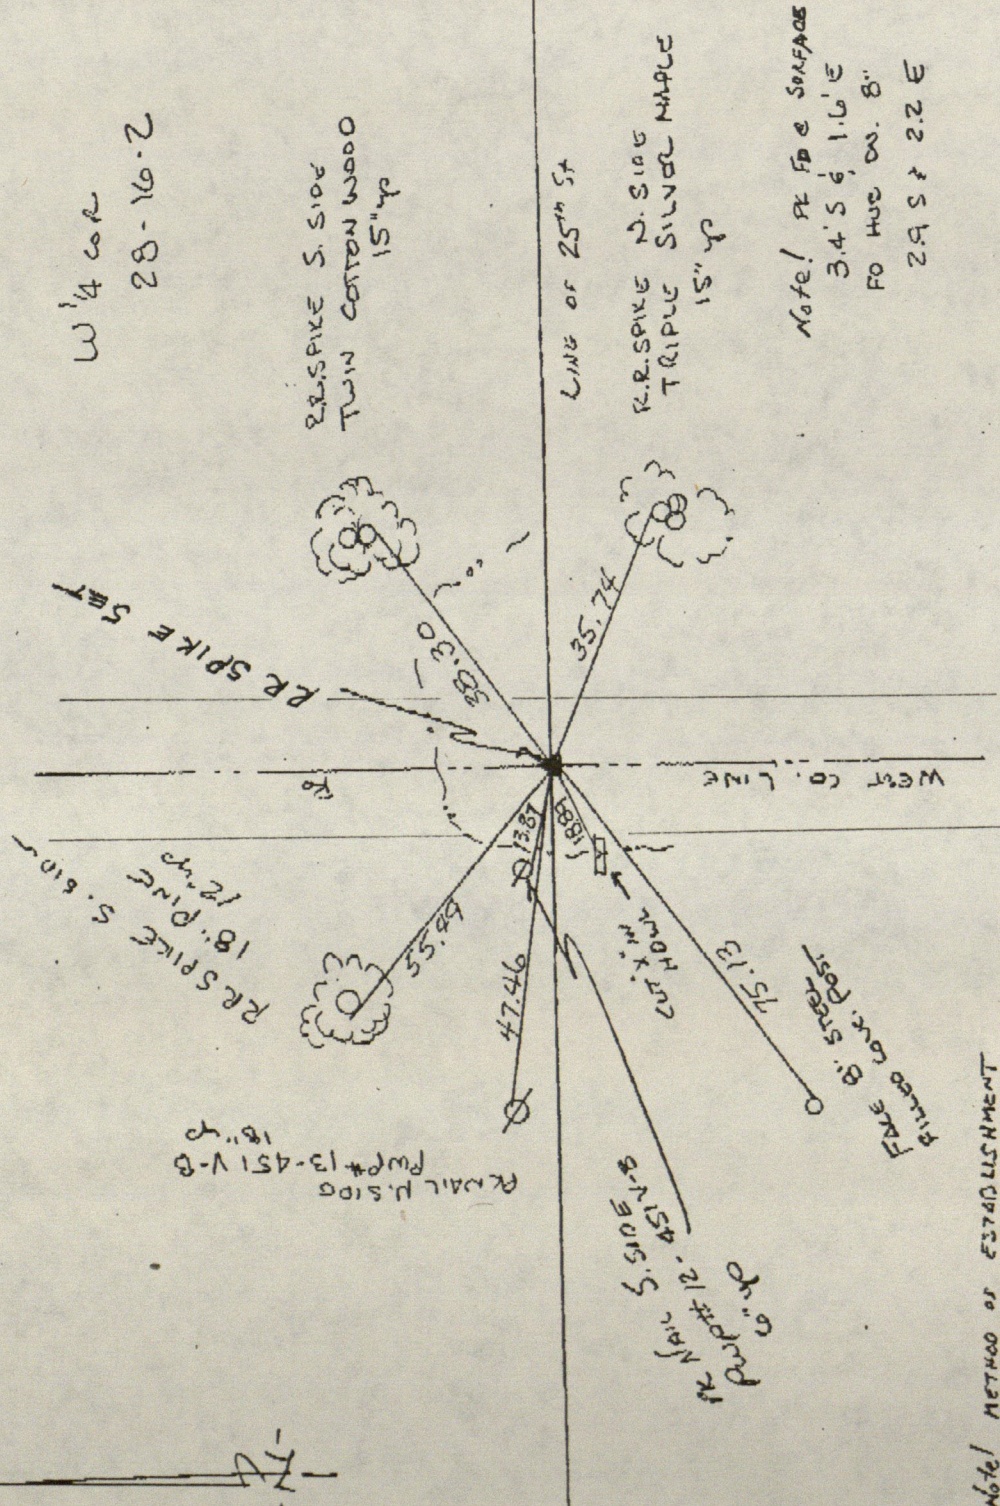


MEMORICK CO BY JOHN O. KAIN CO. SURVEYOR
1911-1913 GOT INFO FROM
STAN SHURTLE

new tie: M. C. Surveyor 2-16-95

SECTION 29 T16N R2E

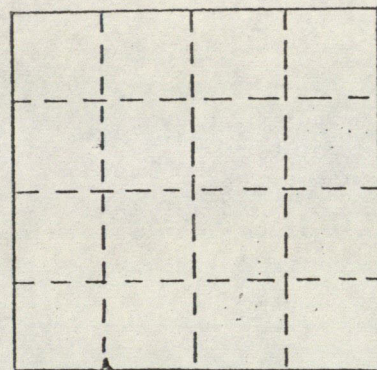



STONE FOUND WITH CUT "4" 0.7' DEEP

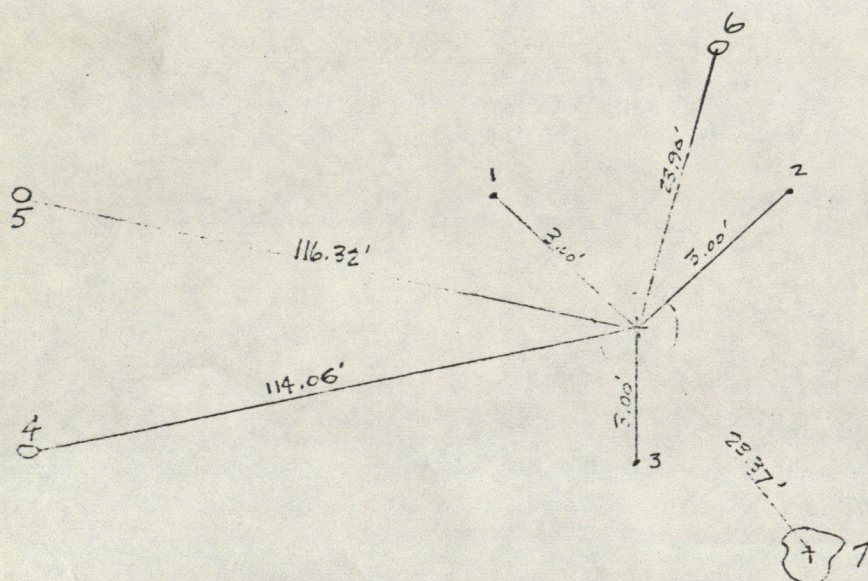


- | | | | |
|---|----------------------------|-------------|---------|
| 1 | MASONRY NAIL | 3.00' | |
| 2 | MASONRY NAIL | 3.00' | |
| 3 | MASONRY NAIL | 3.00' | |
| 4 | N SIDE FWP # Z-58L-4 | (0.8' HIGH) | 114.06' |
| 5 | S SIDE FWP # Z-58L-4L-1 | (0.5' HIGH) | 116.32' |
| 6 | N.W. SIDE FWP | (0.4' HIGH) | 23.90' |
| 7 | PK. NAIL NE. SIDE 12" TREE | (0.8' HIGH) | 23.37' |

STONE FOUND AND WITNESSED BY DAVID STOEPPELWERTH P.E. & L.S. AND DON BOLLEN
STONE WITNESSED BY DAVE ROBERTSON (COUNTY SURVEYORS OFFICE)

SECTION 29 T16N R2E

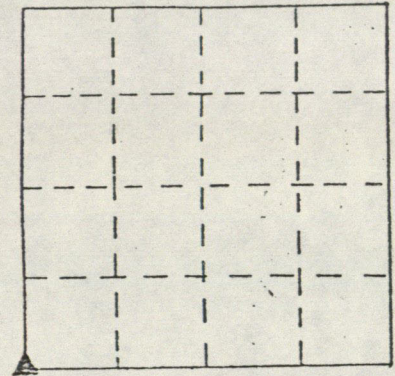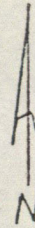

STONE FOUND WITH CUT "4" 1.3' DEEP

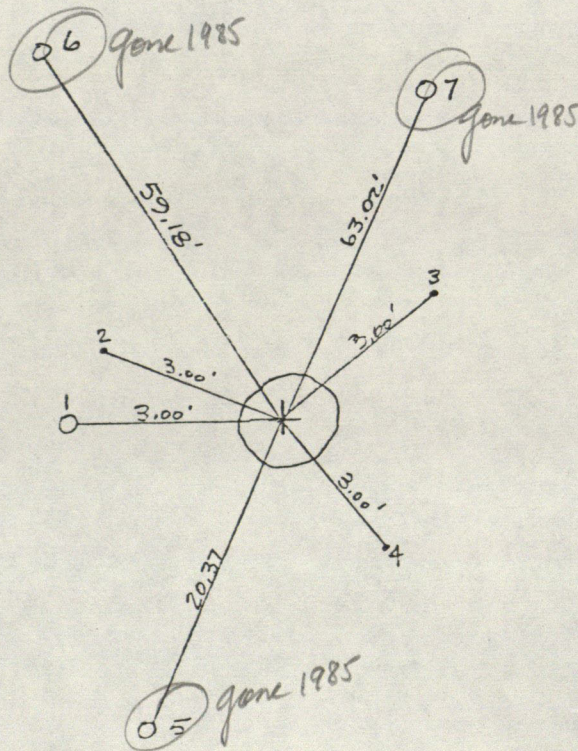

- 1 5/8" REBAR FOUND 3.00' WEST
- 2 MASONRY NAIL 3.00'
- 3 MASONRY NAIL 3.00'
- 4 MASONRY NAIL 3.00'
- 5 P.K. NAIL W SIDE PWP (1.2' HIGH) Z-58 20.37'
- 6 P.K. NAIL W SIDE PWP (1.3' HIGH) 59.18'
- 7 CUT "4" SOUTH SIDE GAS VALVE RIM 63.02'

STONE DUG AND WITNESSED BY DAVID STOEPPELWERTH P.E., AND L.S., AND DON CALLEN
STONE ALSO WITNESSED BY LANE R. PETERSON (COUNTY SURVEYORS OFFICE)



RECORD OF CORNER

LOCATION OF MONUMENT: SECTION 29, T. 16 N., R. 2 E.

Found: ☒ Set: ☐ Depth: 11 inches

Description: No. 6 rebar with standard county disk placed over the corner stone


Bearings to reference objects are magnetic unless a contrary mode is shown.

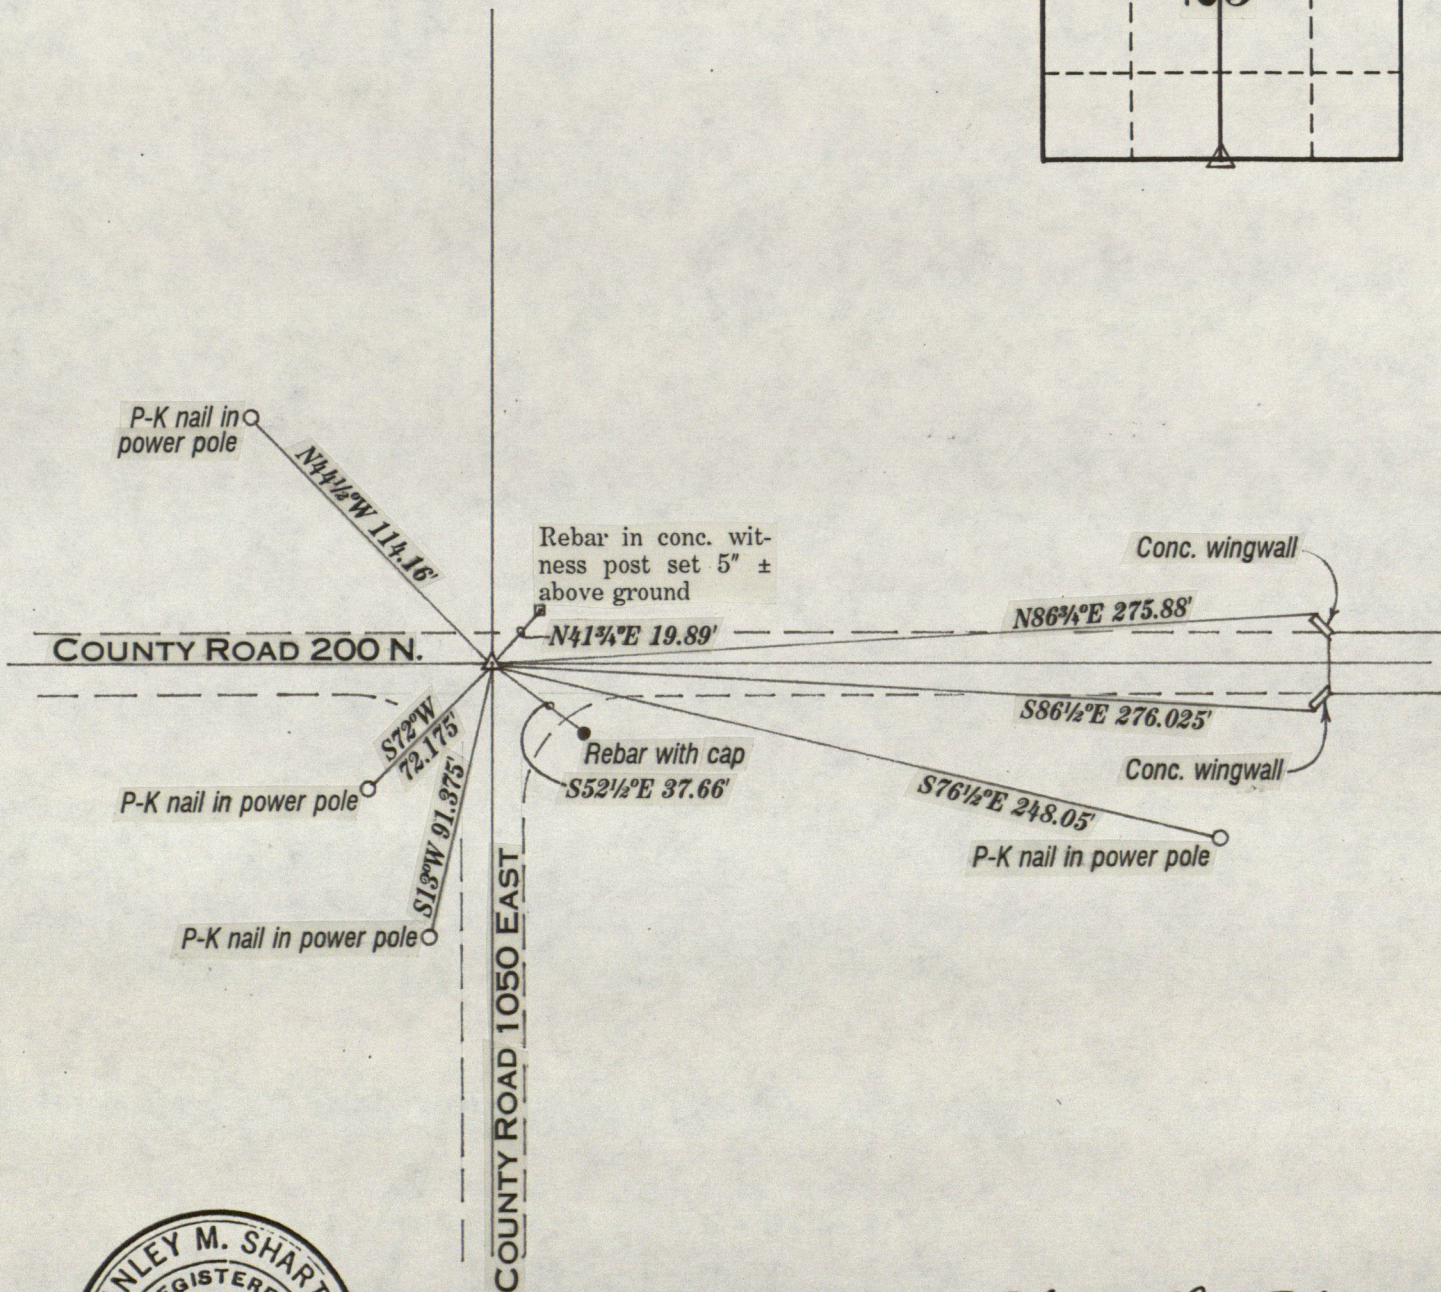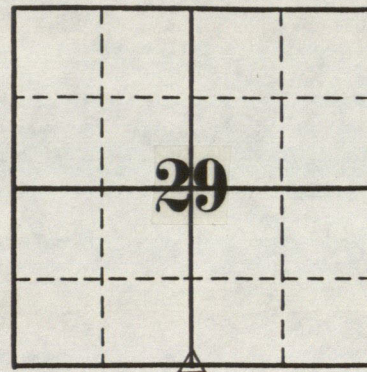


Stanley M. Shartle
Stanley M. Shartle, P.E. & L.S.

Date: March 17, 1997

SECTION 29 T16N R2E

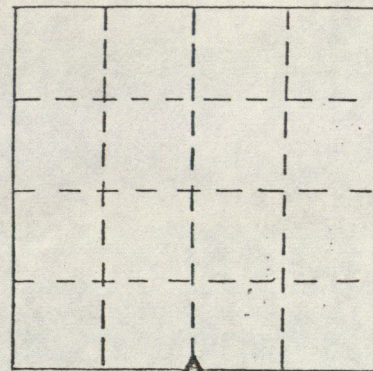

STONE FOUND NO CUT "T" USED HIGH POINT
(0.7' DOWN)

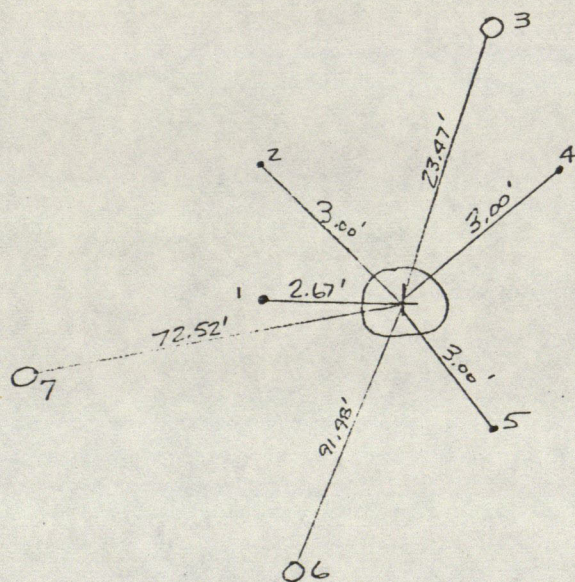

- 1 R.R. SPIKE FOUND 2.67' WEST OF STONE
- 2 MASONRY NAIL 3.00'
- 3 PK NAIL NW SIDE PWP (1.7' HIGH) 23.47'
- 4 MASONRY NAIL 3.00'
- 5 MASONRY NAIL 3.00'
- 6 PK NAIL E. SIDE PWP Z 5BL-8R-1/2 91.98'
- 7 PK NAIL N SIDE PWP Z 5BL-8 (1' HIGH) 72.52'

STONE Laid AND WITNESSED BY DAVID STOEPPELWERTH P.E. AND L.S., AND DON BELLEN
STONE WITNESSED ALSO BY DAVID ROBERTSON (COUNTY SURVEYORS OFFICE)

HENDRICKS COUNTY

DESIGNATION OF MARKER _____

Sec. 29 T. 16 N R. 2 E

CO. LINE

Marker found: yes _____ no _____

Type of Marker: _____

Description: _____

Depth and Marking _____


References set: yes _____ no _____

Sketch References below.

Date: _____ Set by: _____

Comments: _____

HENDRICKS MARION

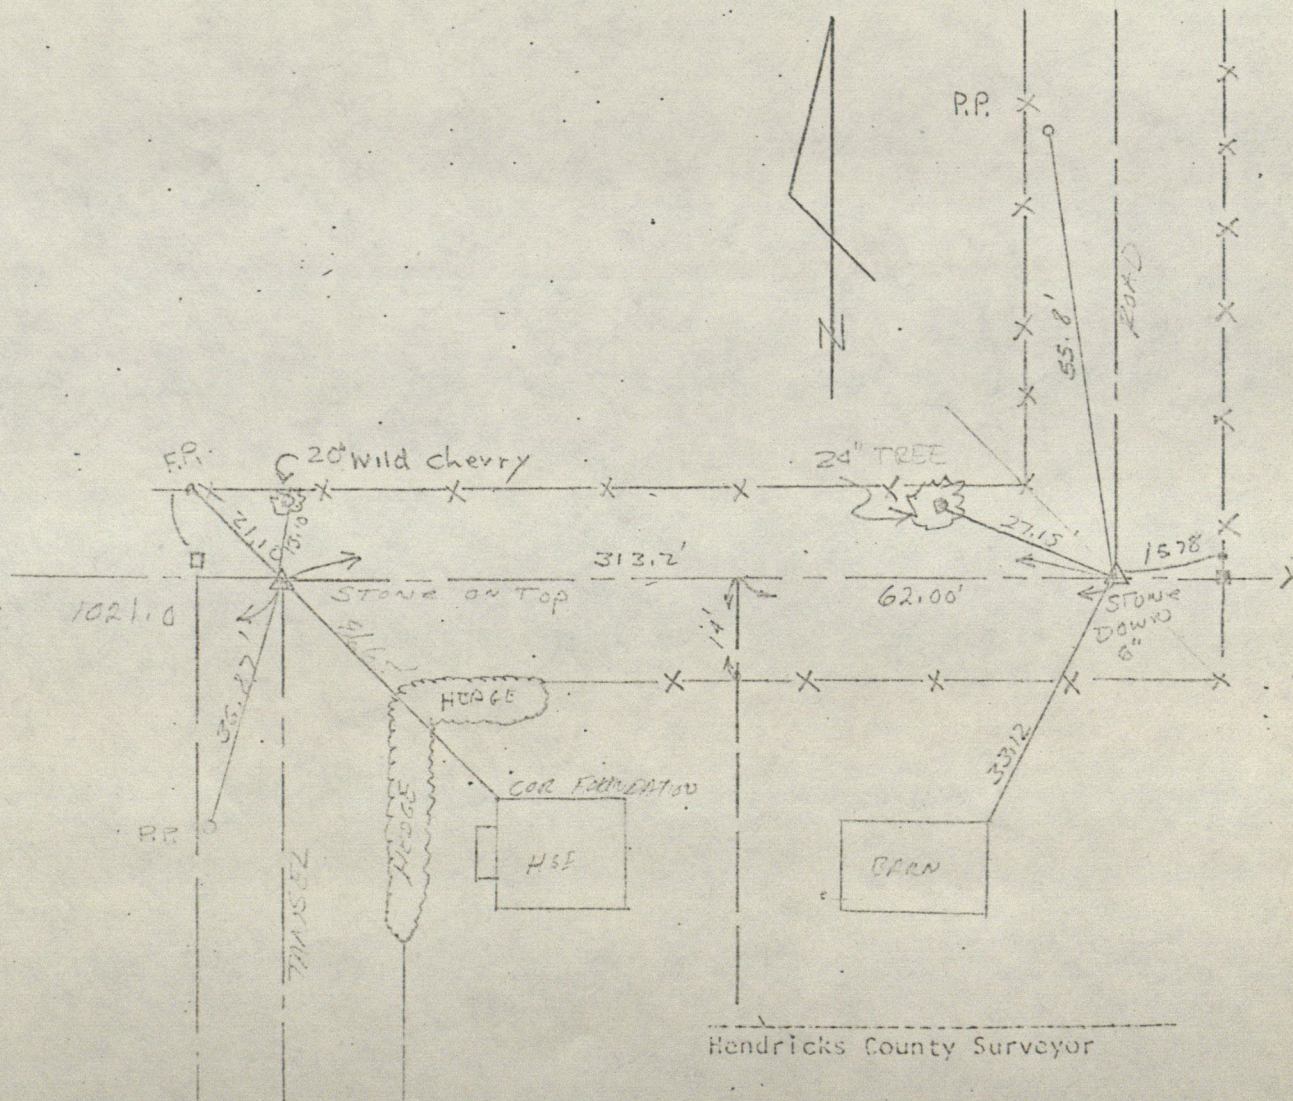

Hendricks County Surveyor


RECORD OF CORNER

LOCATION OF MONUMENT: SECTION 30, T. 16 N., R. 2 E.

Found: ☒ Set: ☐ Depth: 16 inches

Description: stone

Bearings to reference objects are magnetic unless a contrary mode is shown.

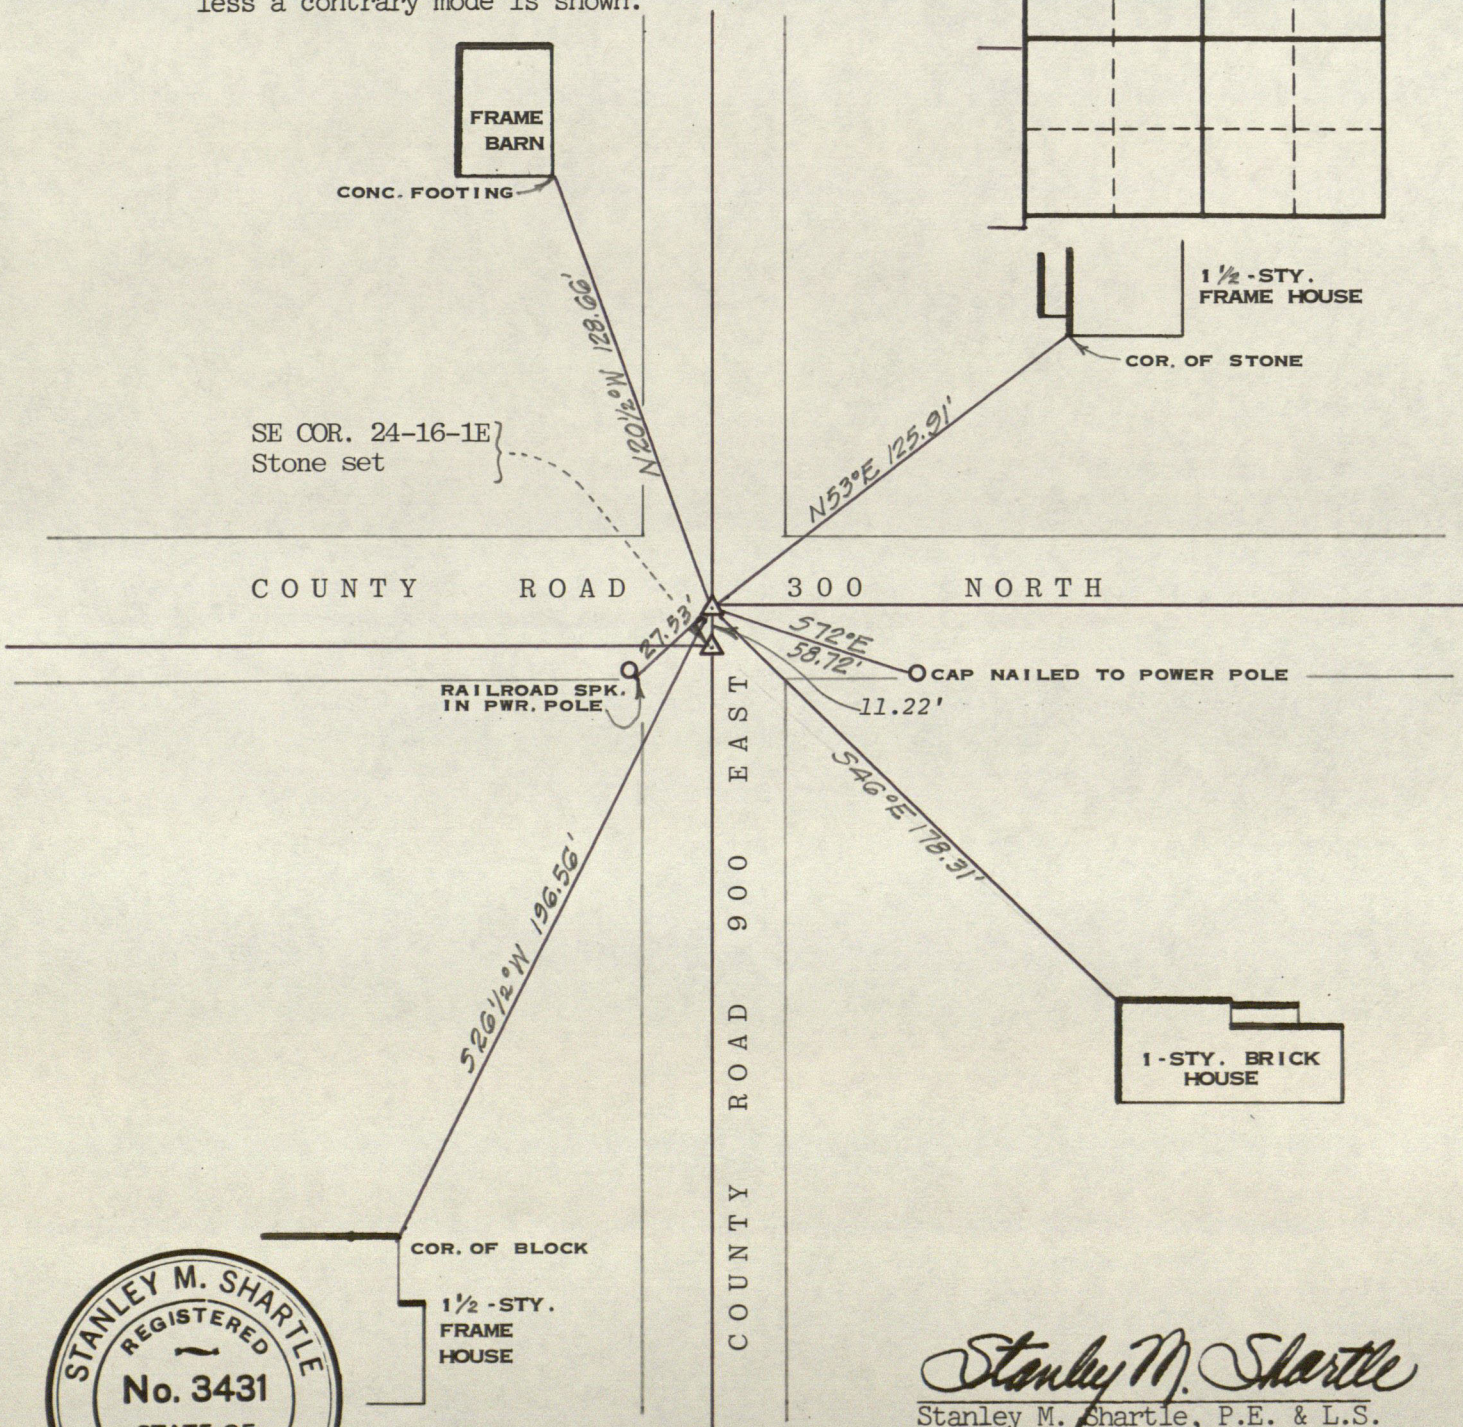

Stanley M. Shartle
Stanley M. Shartle, P.E. & L.S.

Date: July 31, 1985




RECORD OF CORNER

LOCATION OF MONUMENT: SECTION 30, T. 16 N., R. 2 E.

Found: ☒ Set: ☐ Depth: 11 inches

Description: stone

Bearings to reference objects are magnetic unless a contrary mode is shown.

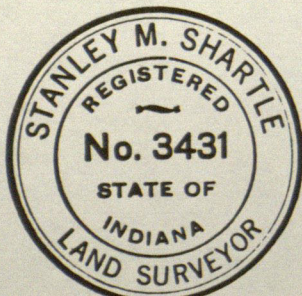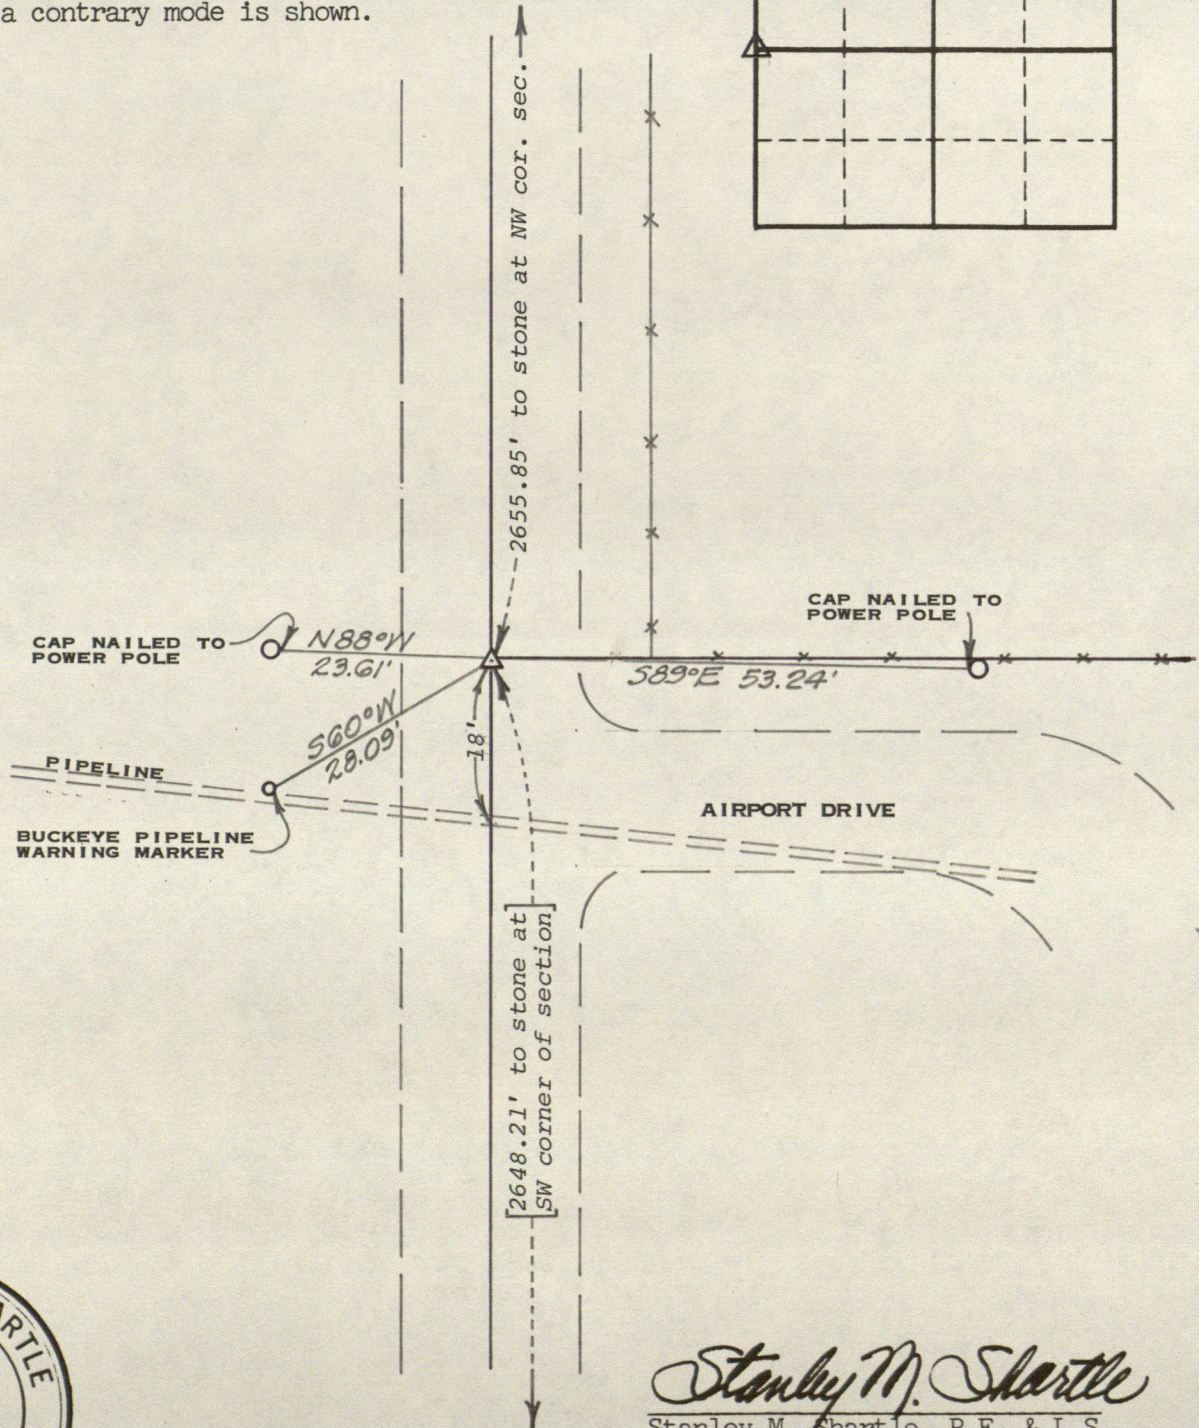
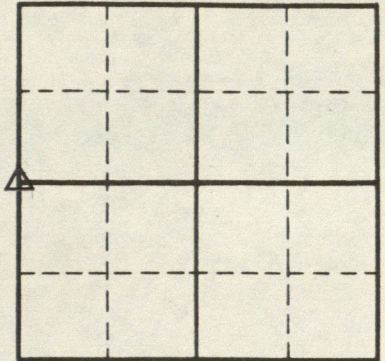


Stanley M. Shartle
Stanley M. Shartle, P.E. & L.S.

Date: July 31, 1985

N.W. CORNER

30-16-2 E

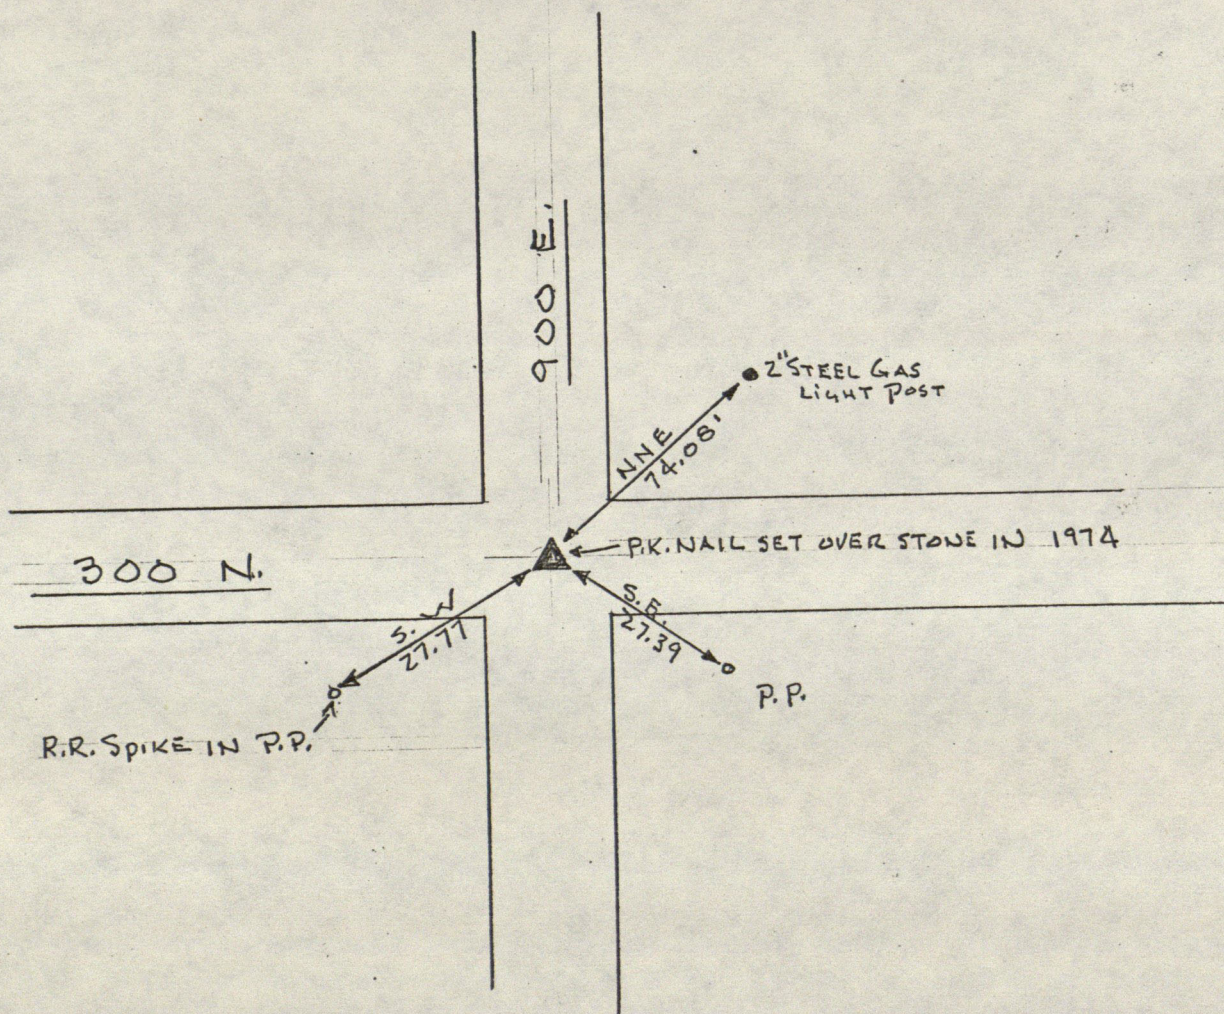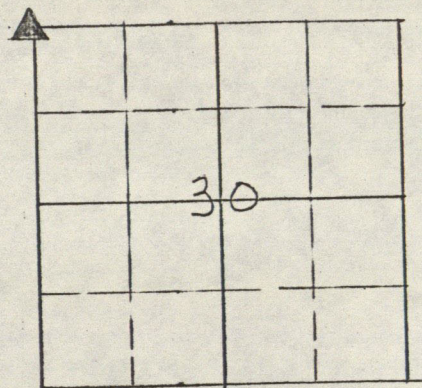

RECORD OF CORNER

LOCATION OF MONUMENT: SECTION 31, T. 16N., R. 2 E.


Found: ☒ Set: ☐ Depth: See below

Description: No. 6 rebar with standard county disk placed over the corner stone

Bearings to reference objects are magnetic unless a contrary mode is shown.




Red granite stone found 14½" deep. The standard county disk is at the surface of the road.

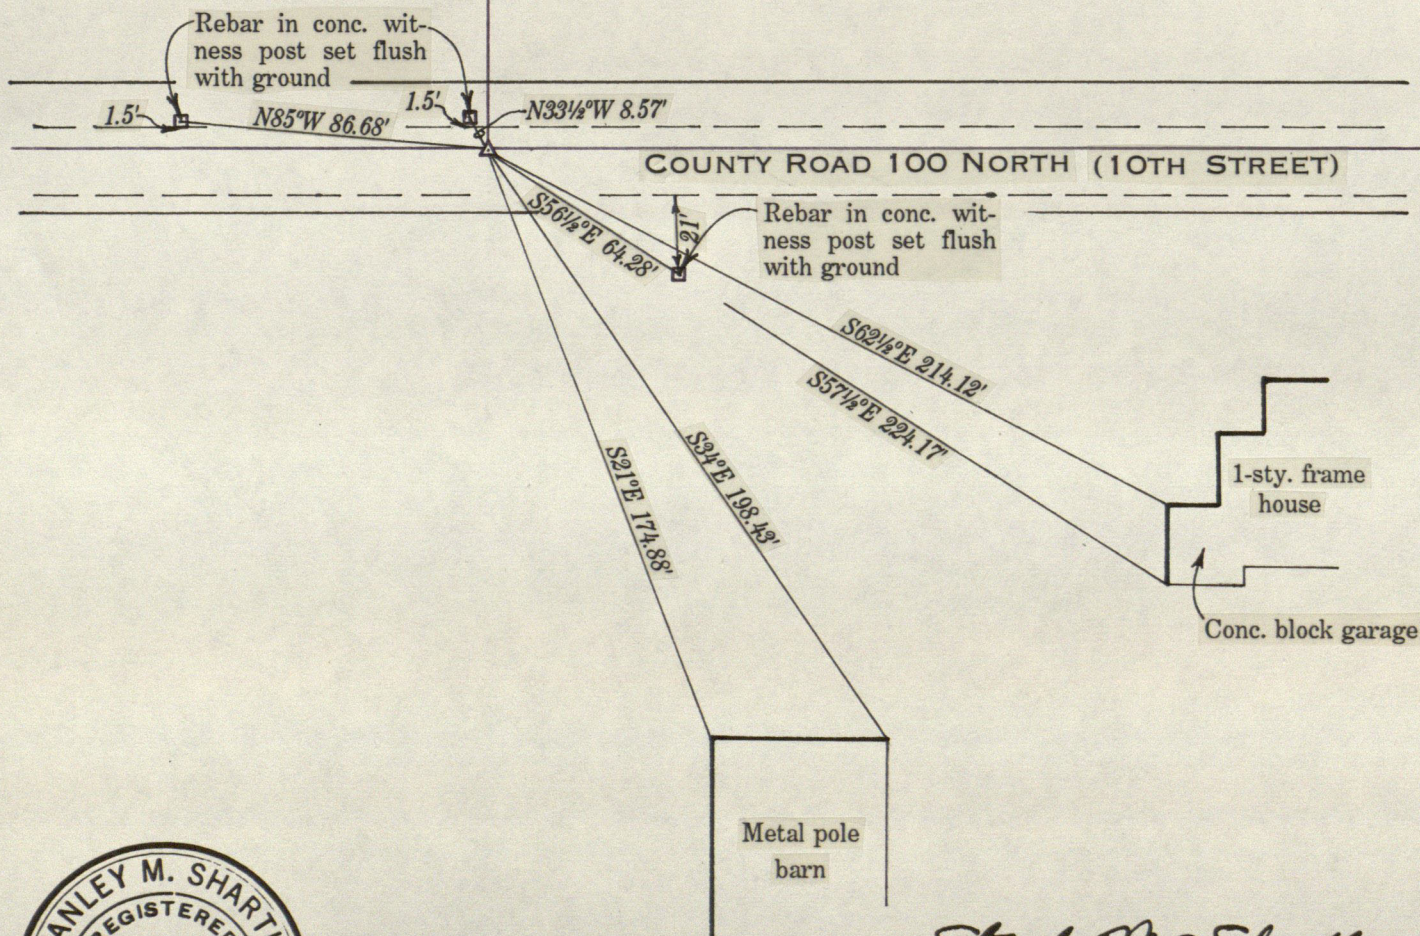

Stanley M. Shartle
Stanley M. Shartle, P.E. & L.S.

Date: December 3, 1992

11-27-92
TRI-Pod

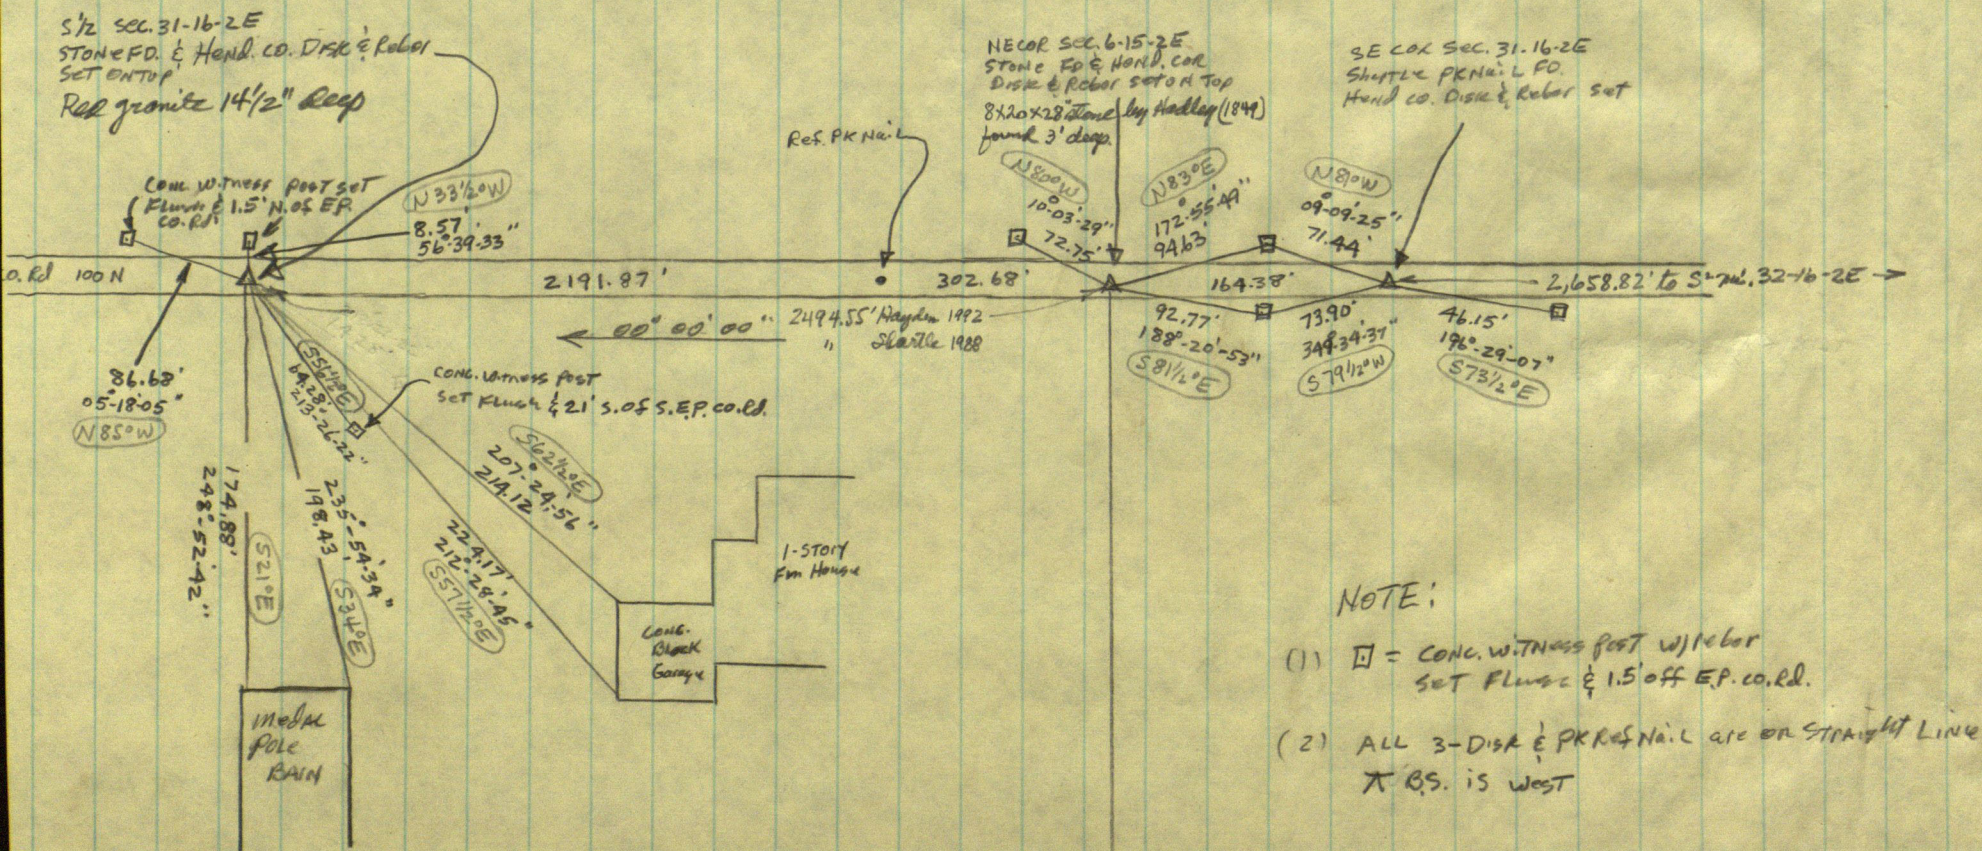

RECORD OF CORNER



LOCATION OF MONUMENT: SECTION 31, T. 16 N., R. 2 E.

Found: ☒ Set: ☐ Depth: 4 inches

Description: + on stone 8x10x15 inches

Bearings to reference objects are magnetic unless a contrary mode is shown.

This stone was found after digging more than five days. It was 14 inches deep and measured 8x12x12 inches instead of 7x12x12 inches as recorded by Trotter. The old stone fell into several pieces as it was removed for checking of dimensions for validity. It was replaced by the present 8x10x15-inch stone. The Co. Surveyor intends to replace the new stone with a concrete monument.

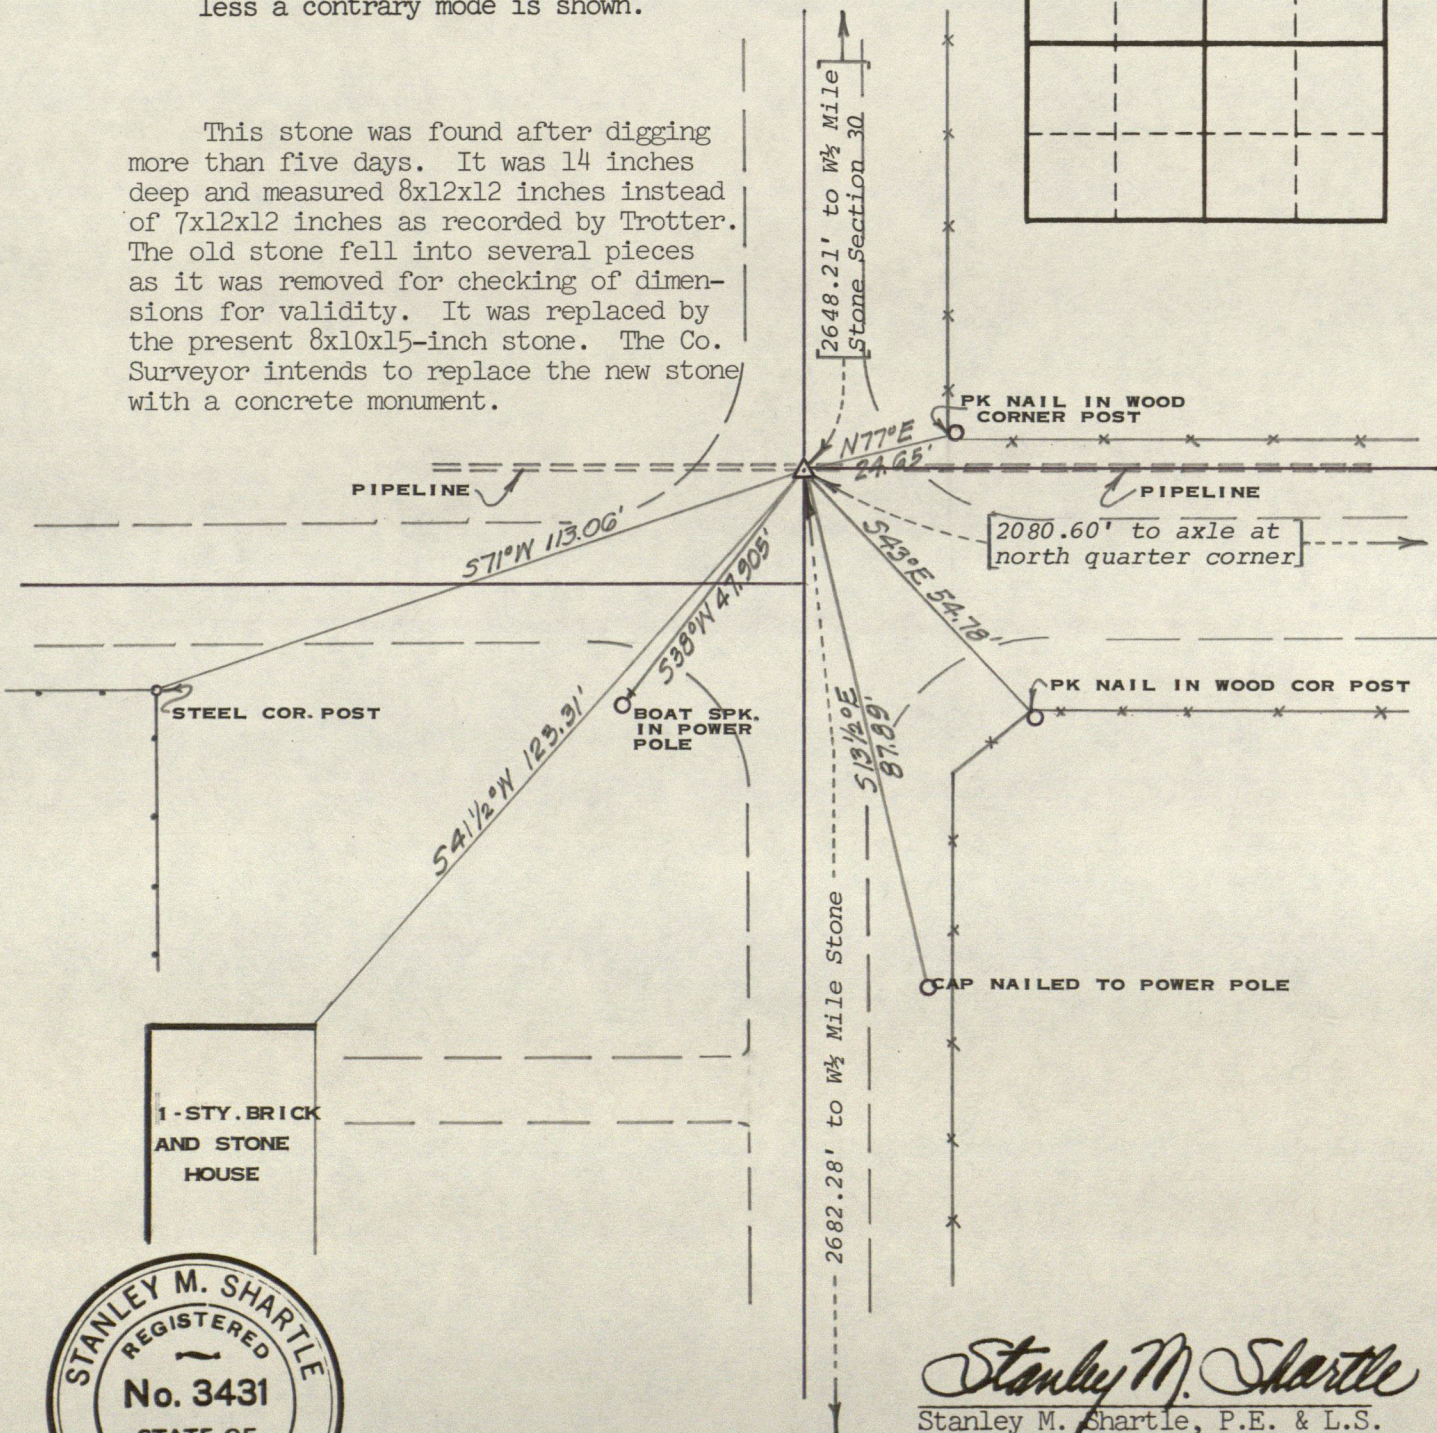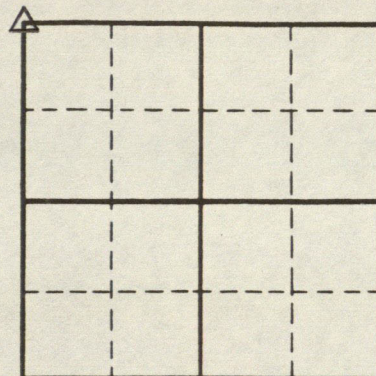

Stanley M. Shartle
Stanley M. Shartle, P.E. & L.S.

Date: July 31, 1985



RECORD OF CORNER

LOCATION OF MONUMENT: SECTION 31, T. 16 N., R. 2 E.

Found: Set: ✓ Depth: See below

Description: See below

Bearings to reference objects are magnetic unless a contrary mode is shown.

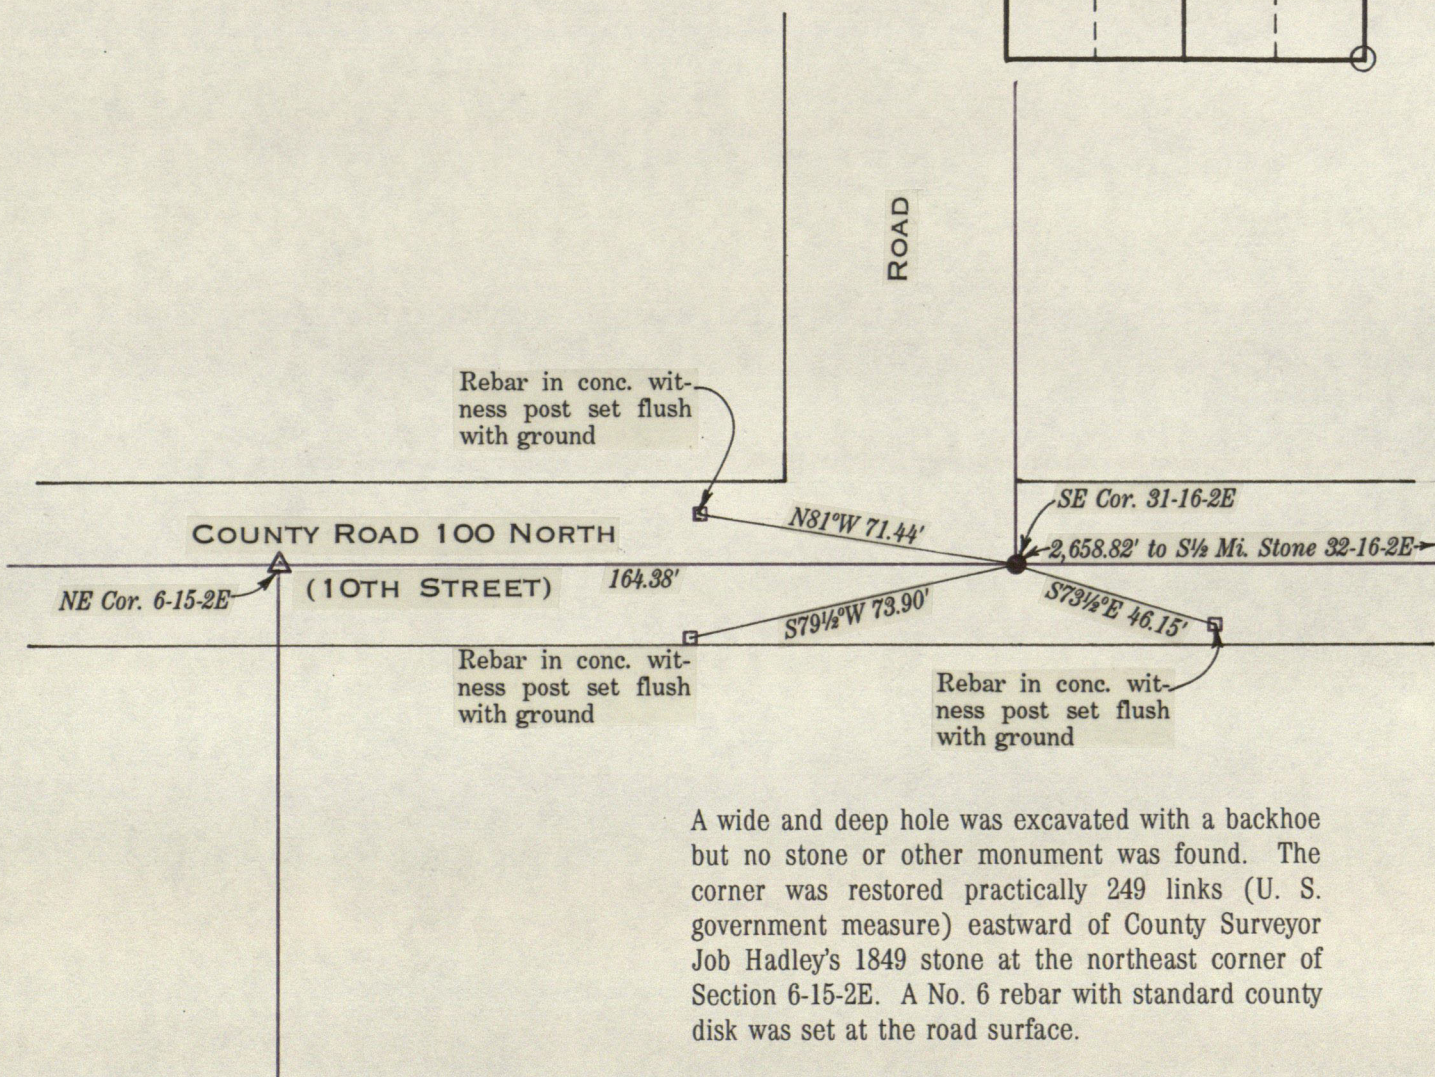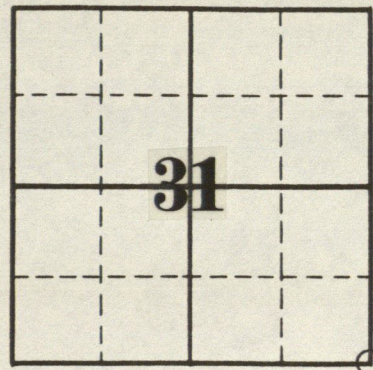

A wide and deep hole was excavated with a backhoe but no stone or other monument was found. The corner was restored practically 249 links (U. S. government measure) eastward of County Surveyor Job Hadley's 1849 stone at the northeast corner of Section 6-15-2E. A No. 6 rebar with standard county disk was set at the road surface.



Stanley M. Shartle
Stanley M. Shartle, P.E. & L.S.

Date: December 3, 1992


RECORD OF CORNER

LOCATION OF MONUMENT: SECTION 31, T. 16 N., R. 2 E.


Found: Set: ☒ Depth: top flush

Description: axle

Bearings to reference objects are magnetic unless a contrary mode is shown.

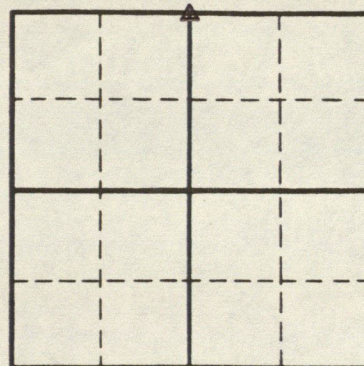

This corner was searched for over a two-day period, not found, and deemed lost. It was restored by a single proportionate measurement.

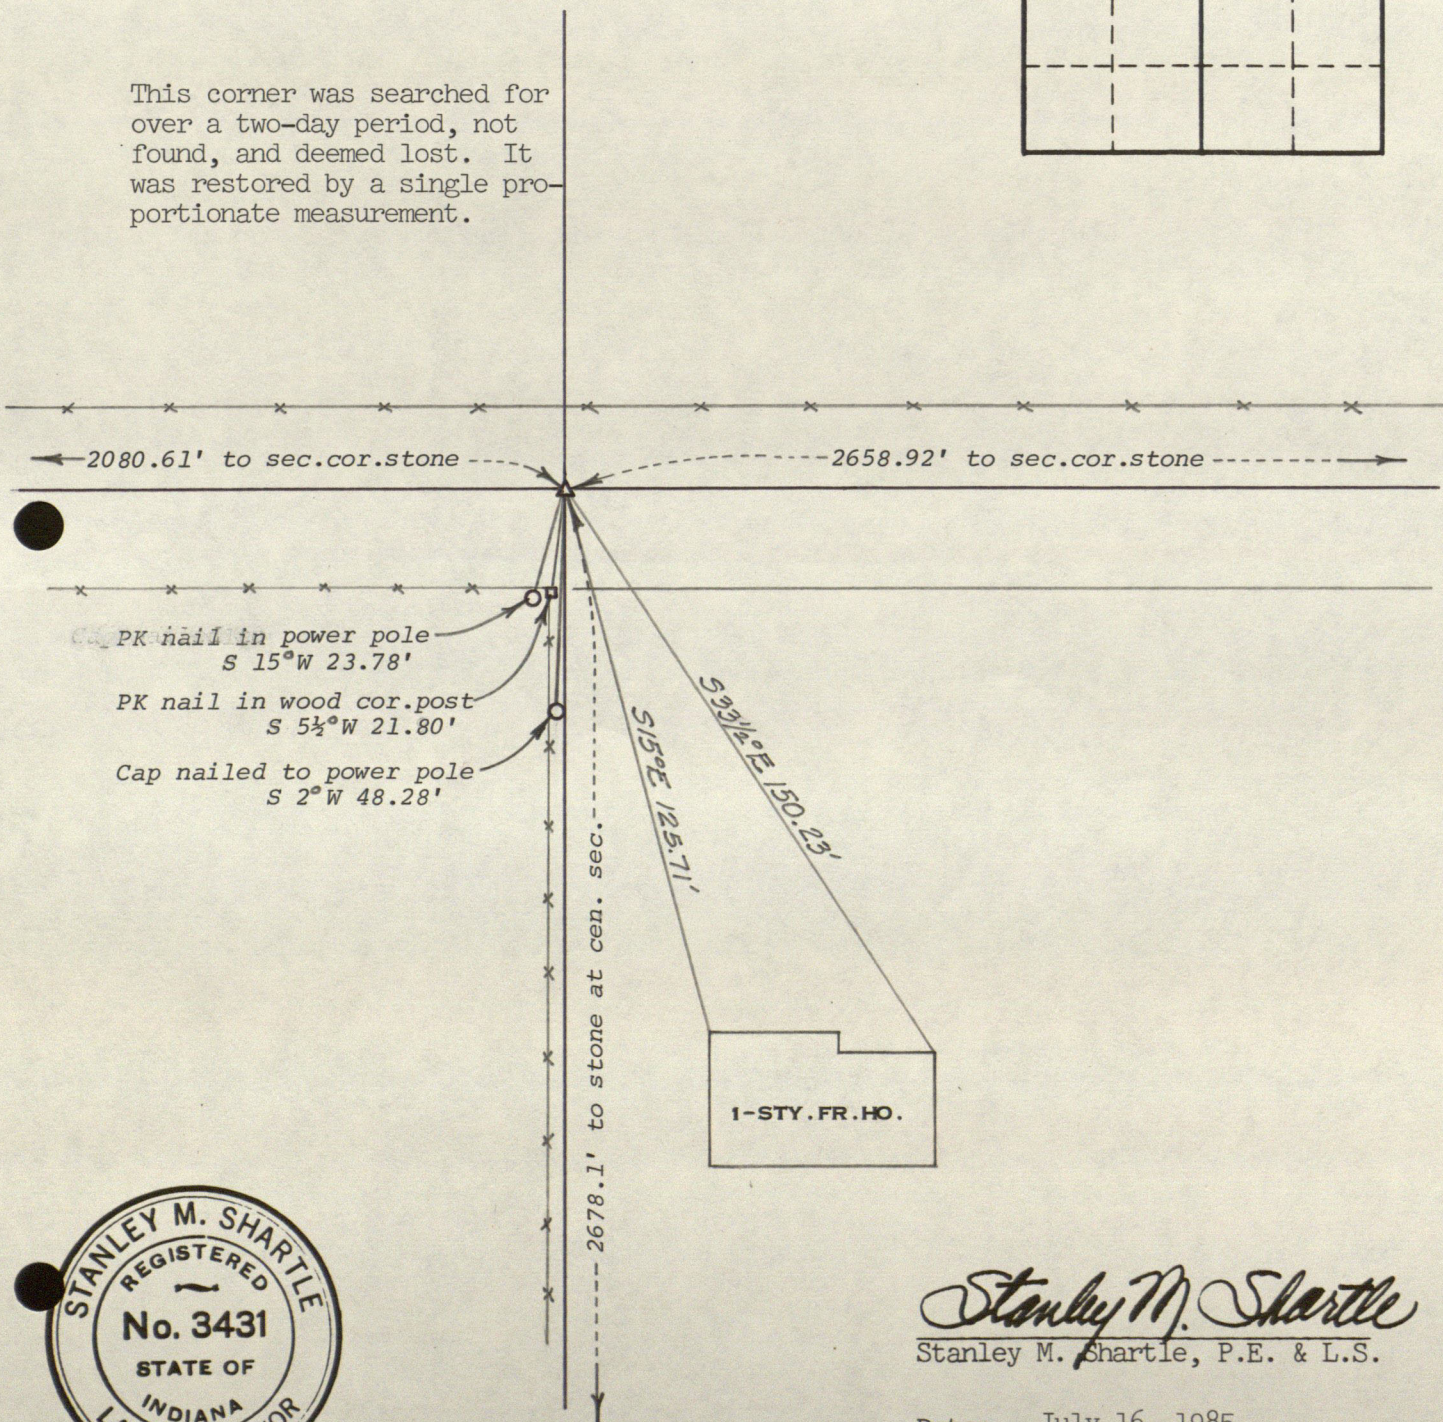

Stanley M. Shartle
Stanley M. Shartle, P.E. & L.S.

Date: July 16, 1985


4/25/79

31-16-2E

(CENTER NORTH NW 1/4)

R.R. SPIKE LAYED OVER STONE, P.K. NAIL

DRIVEN IN OVER TOP OF STONE.

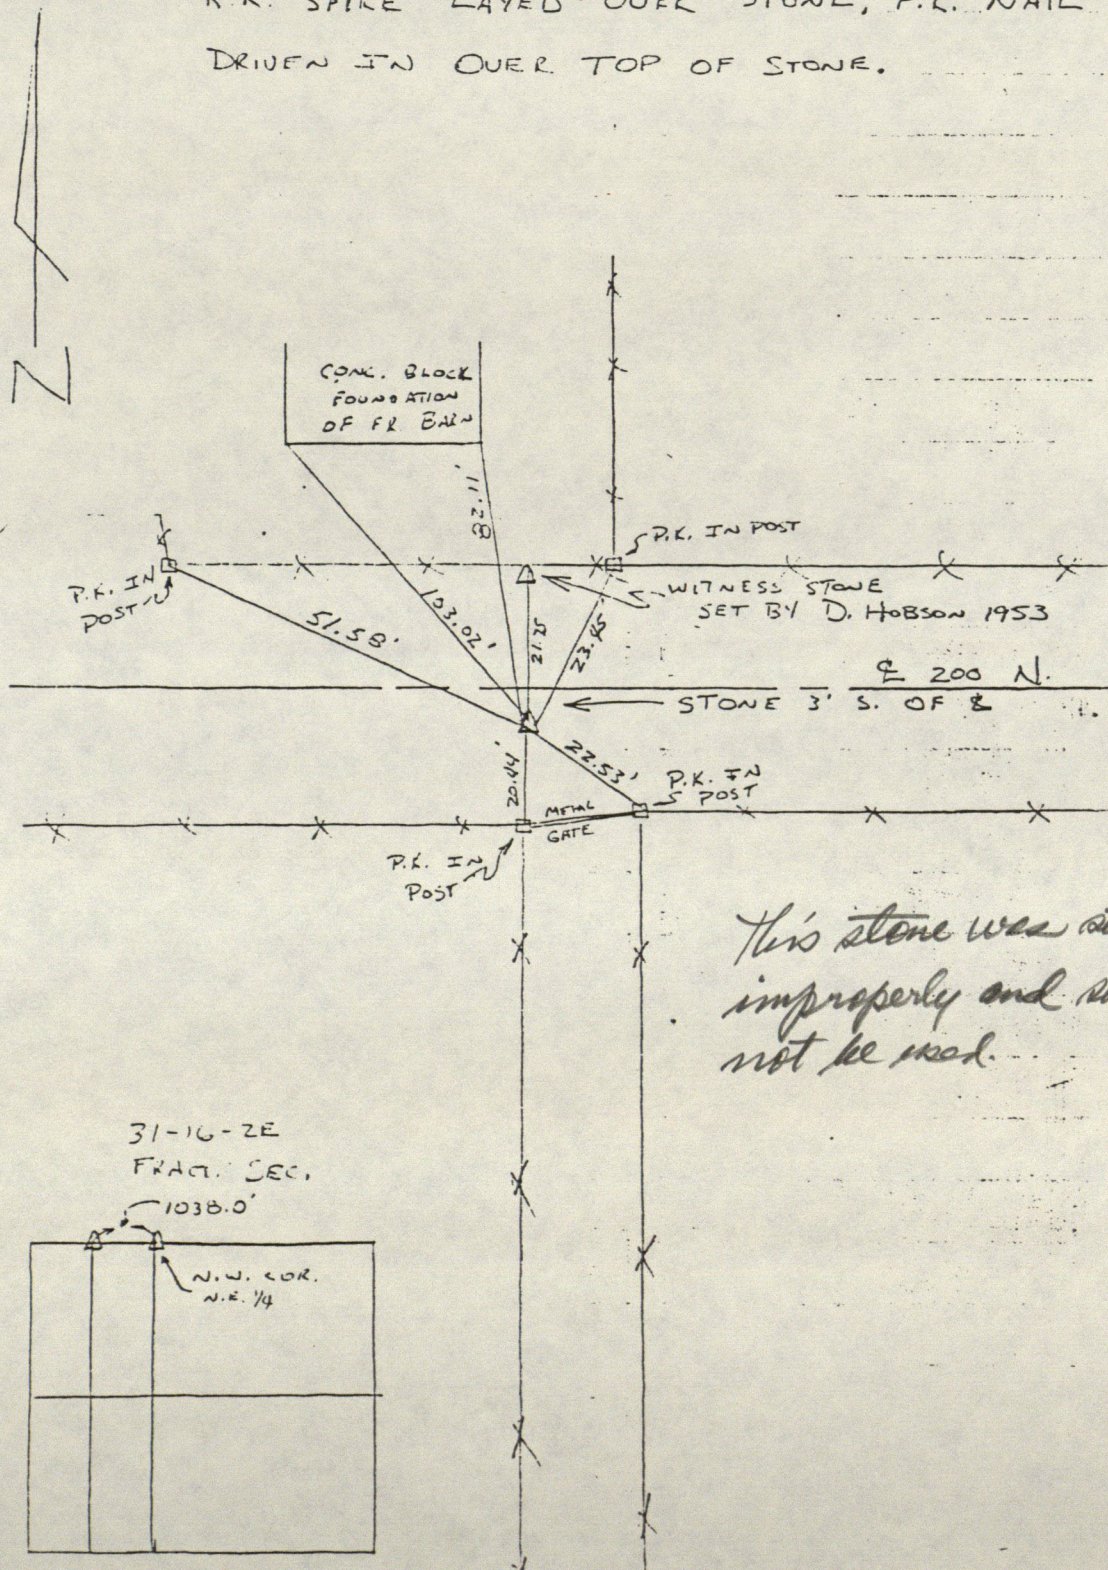

This stone was set
improperly and should
not be used.



31-16-ZE
FRAG. SEC.

-1038.0'

N.W. COR.
N.E. 1/4

STONE W/ NOSE ON TOP
 FOUND ? 8" DEEP WOOD HUB FD.
 ON E. SIDE OF STONE
 STONE SET BY D. HOBSON?
 UNCOVERED & TIES MADE.
 R/R BOLT SET ON TOP OF STONE
 4/25/79
 S. MAXWELL & R. SHAMBAUGH

N 1/2 MILE STONE
 FRAC. SEC. 31-16N, -2E.

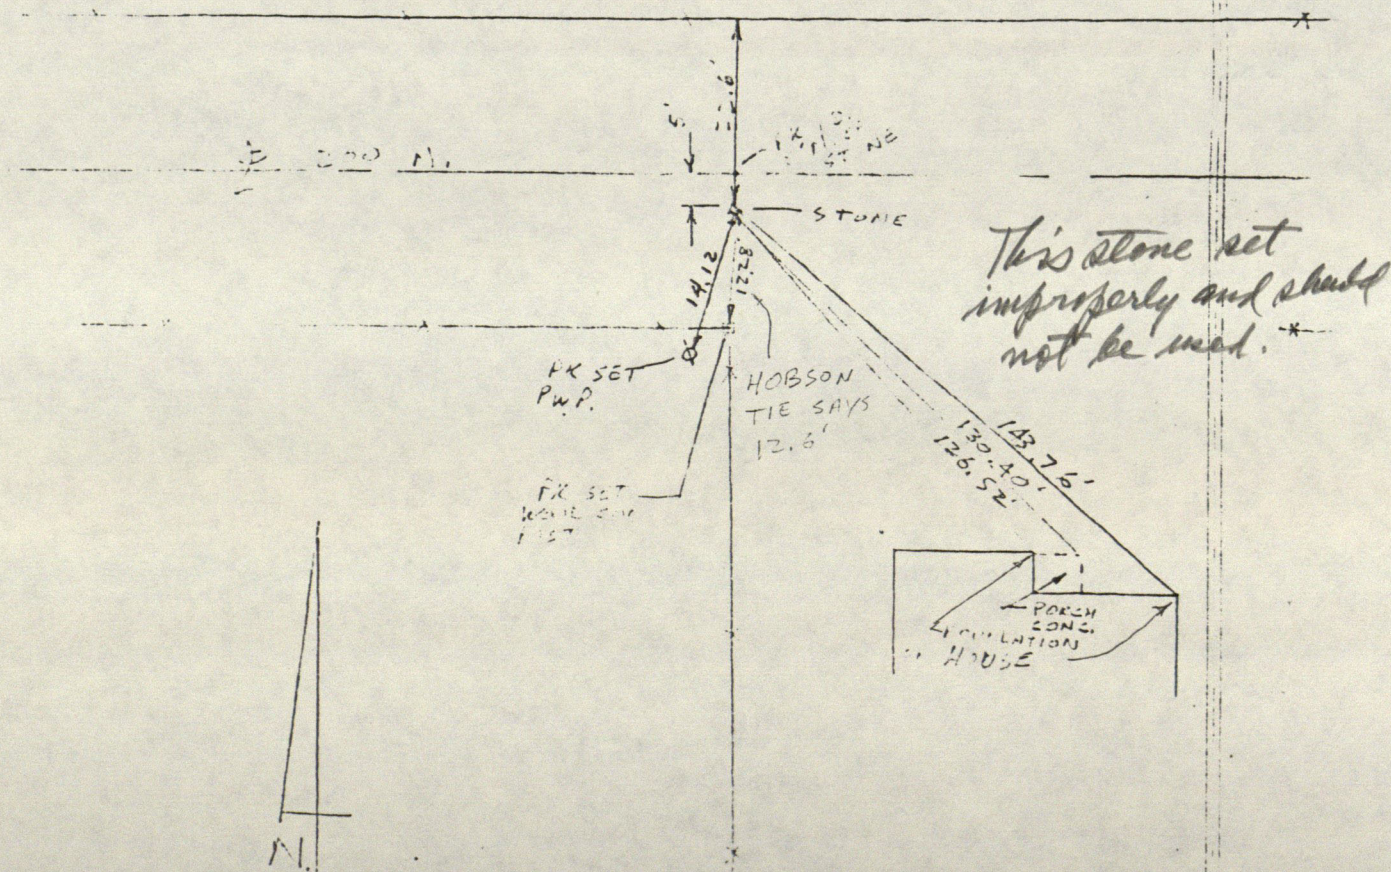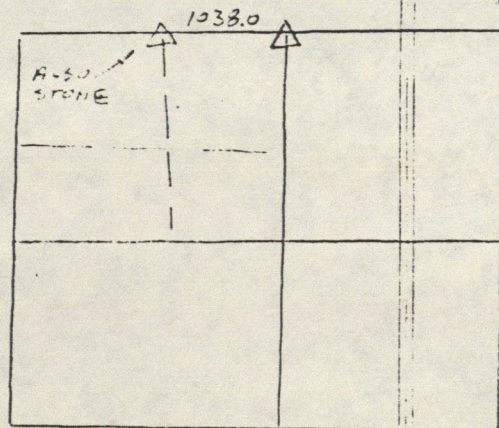


RECORD OF CORNER

LOCATION OF MONUMENT: SECTION 31, T. 16 N., R. 2 E.

Found: ☒ Set: ☐ Depth: 16 inches

Description: stone

Bearings to reference objects are magnetic unless a contrary mode is shown.

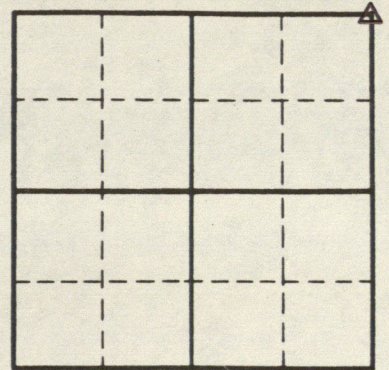

CAP NAILED TO POWER POLE

CAP NAILED TO POWER POLE

CROSS ON STONE

CAP NAILED TO POWER POLE

2658.92' to axle at qtr. cor.

COUNTY ROAD 200 NORTH

COUNTY ROAD 1000 EAST



Stanley M. Shartle
Stanley M. Shartle, P.E. & L.S.

Date: July 16, 1985

RECORD OF CORNER

LOCATION OF MONUMENT: SECTION 31, T. 16 N., R. 2 E.



Found: ☒ Set: Depth: 13 1/4 inches

Description: Trotter's second stone; good condition

Bearings to reference objects are magnetic unless a contrary mode is shown.

CAP NAILED TO TELEPHONE POLE

CAP NAILED TO PWR. POLE

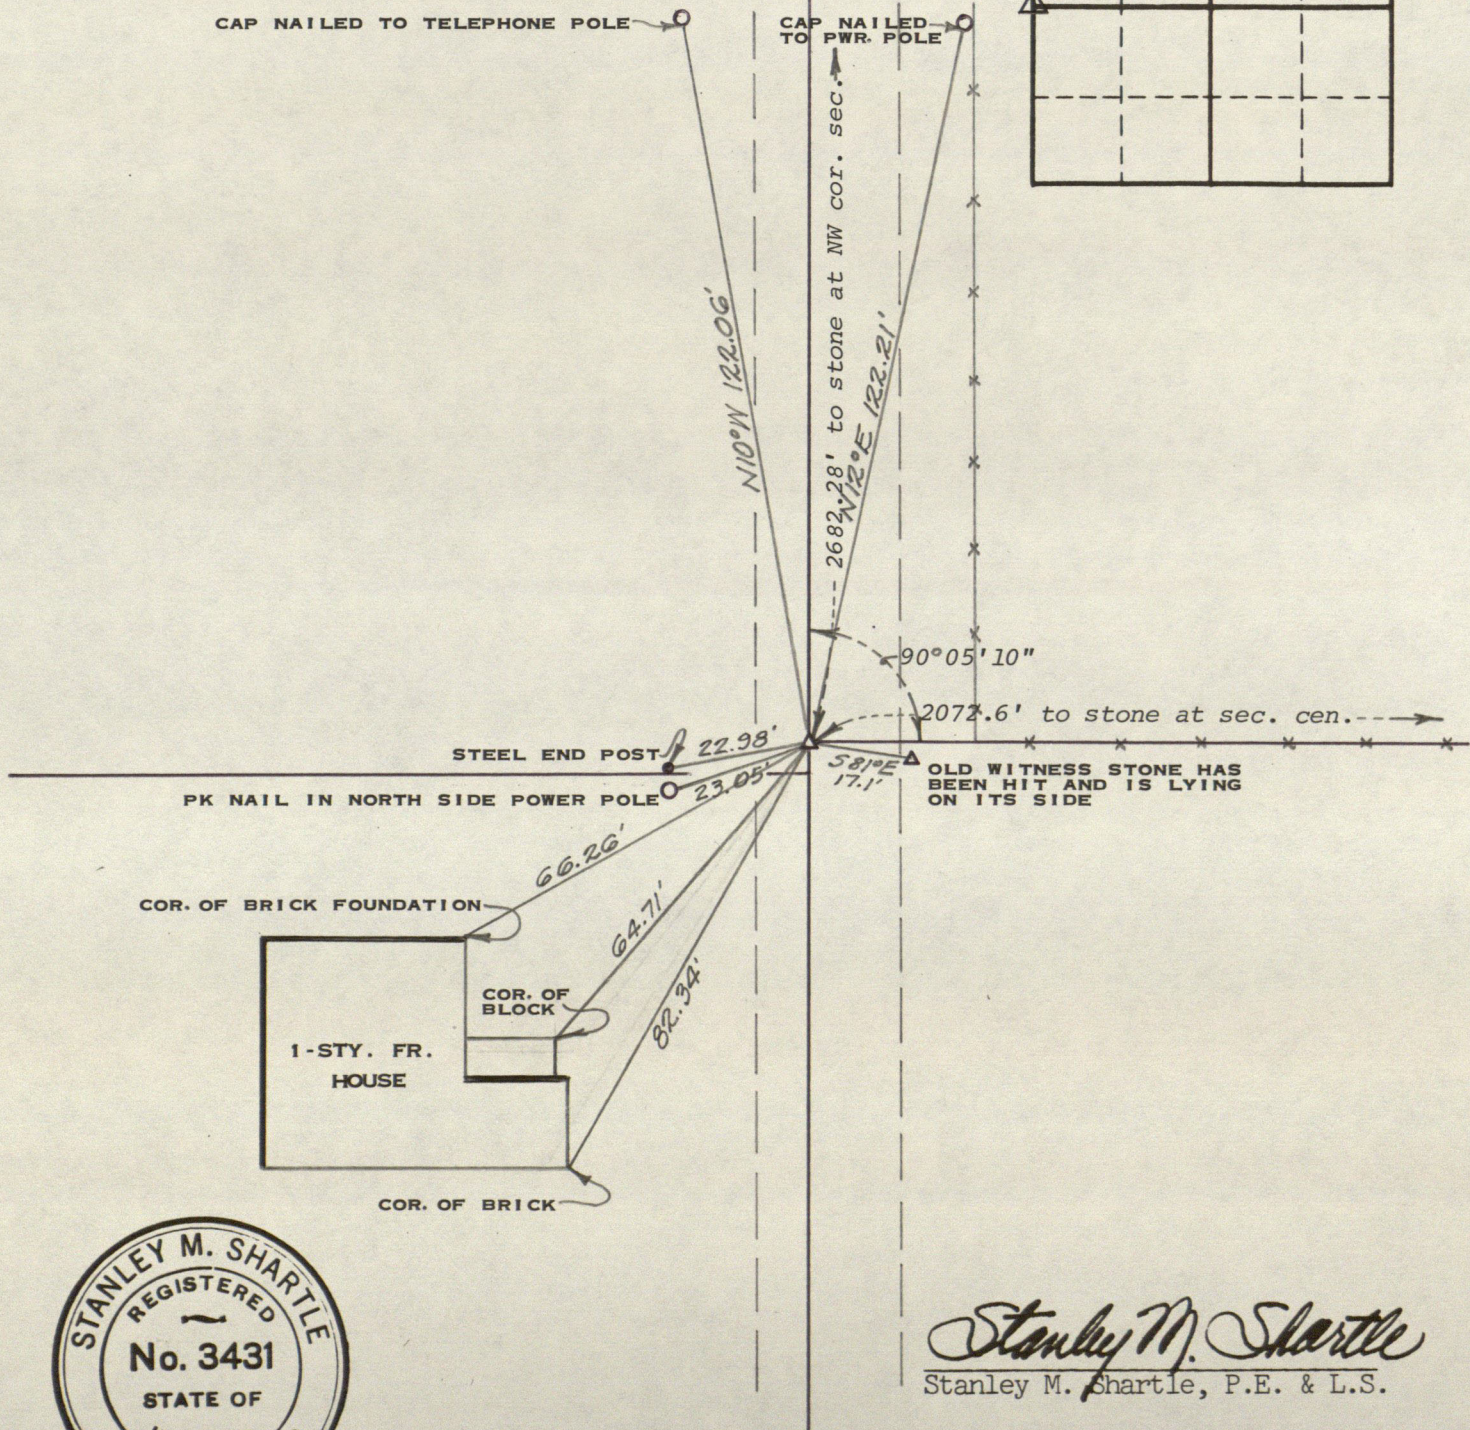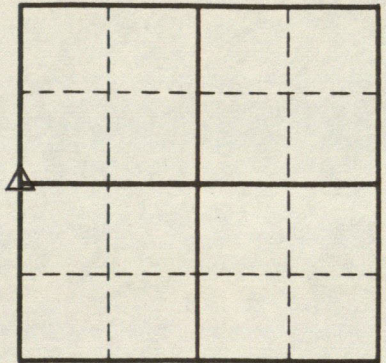

Stanley M. Shartle
Stanley M. Shartle, P.E. & L.S.

Date: July 31, 1985



RECORD OF CORNER

LOCATION OF MONUMENT: SECTION 31, T. 16 N., R. 2 E.

Found: Set: ☒ Depth: flush with ground

Description: + on stone 10x10x14 inches

Bearings to reference objects are magnetic unless a contrary mode is shown.

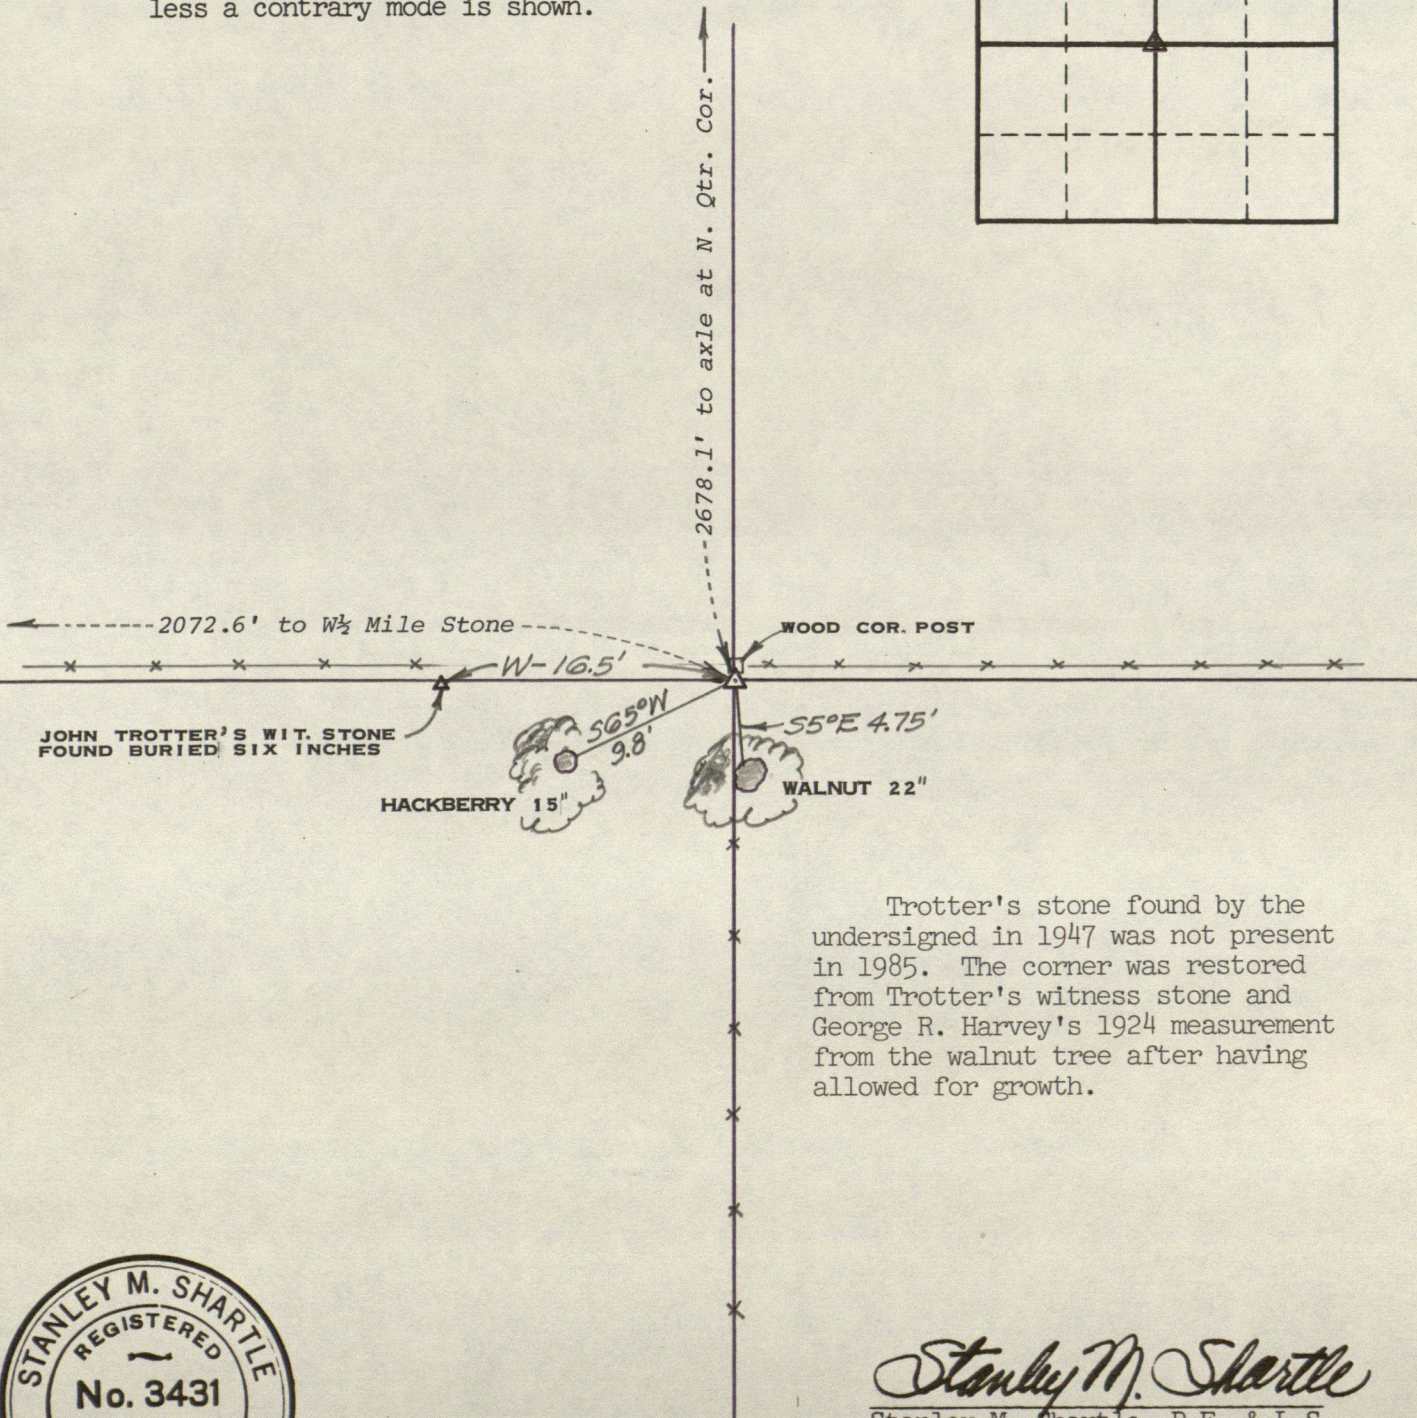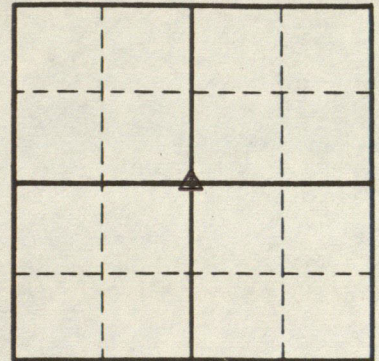

Trotter's stone found by the undersigned in 1947 was not present in 1985. The corner was restored from Trotter's witness stone and George R. Harvey's 1924 measurement from the walnut tree after having allowed for growth.



Stanley M. Shartle
Stanley M. Shartle, P.E. & L.S.

Date: July 16, 1985

RECORD OF CORNER


LOCATION OF MONUMENT: SECTION 31, T. 16 N., R. 2 E.

Found: ☒ Set: Depth: 5 inches

Description: hole drilled into top of old stone


Bearings to reference objects are magnetic unless a contrary mode is shown.

2-STY. BRICK HOUSE
AND GARAGE

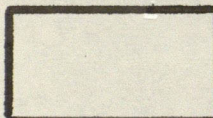

COUNTY ROAD 900 EAST

1-1/2 STY. FRAME
HOUSE

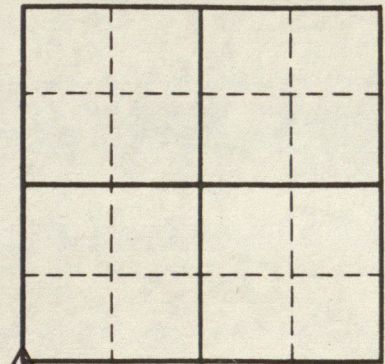

COUNTY ROAD 100 NORTH


10th STREET

8

1. Cor. of brick N 46°W 140.20'
2. PK nail in pwr. pole N 60°W 40.07'
3. Near edge tel. MH cover N 50°W 39.03'
4. Nail & cap in pwr. pole N 16°W 76.57'
5. Center gas valve cover N 13°W 49.65'
6. PK nail in pwr. pole N 17°E 77.48'
7. Cor. of block foundation N 31°E 156.71'
8. Nail & cap in pwr. pole S 80°E 107.28'
9. Cor. of block foundation S 27½°E 109.81'
10. Cor. of block foundation S 40½°E 94.34'
11. Cor. of block foundation S 48°E 108.75'

10
9

1-STY. FRAME HOUSE

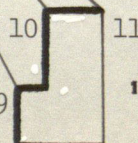

Stanley M. Shartle
Stanley M. Shartle, P.E. & L.S.

Date: July 17, 1985

Sec. 6

recovered $5\frac{1}{2}$ lbs

2 lbs

good search
here 7-17-85
no stone
found.
S.M.S.

Trotter's W² mi. stone 10x10x2 (second)

S $77\frac{1}{2}$ ° E 25.5 ft

E - 25 lbs

Trotter's unit. stone 7x10x14


Trotter's W² mi. Stone 31-16-2E (first)

An analysis on old
surveys fixing the
W² mi. stone Sec. 31-16-2E

77-867

No. 17, 72

Time Time

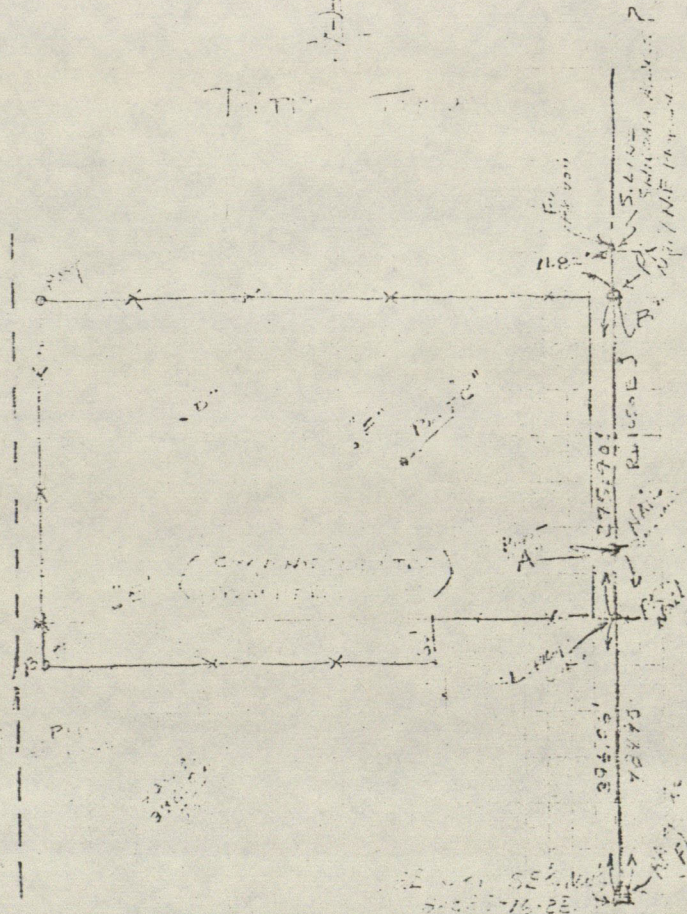

Center of Section 32, T16N, 2E

HENDRICKS COUNTY

DESIGNATION OF MARKER CENTER SEC. 32 T. 16 N. 25 R.

Marker found: yes ✓ no

Type of Marker: STONE

Description: FROM TOPO SURVEY



Depth and Marking:

References set: yes no ✓

Sketch References below.

Date: NOV. 17, 1972 Set by: LEWIS ENGINEERING

Comments:

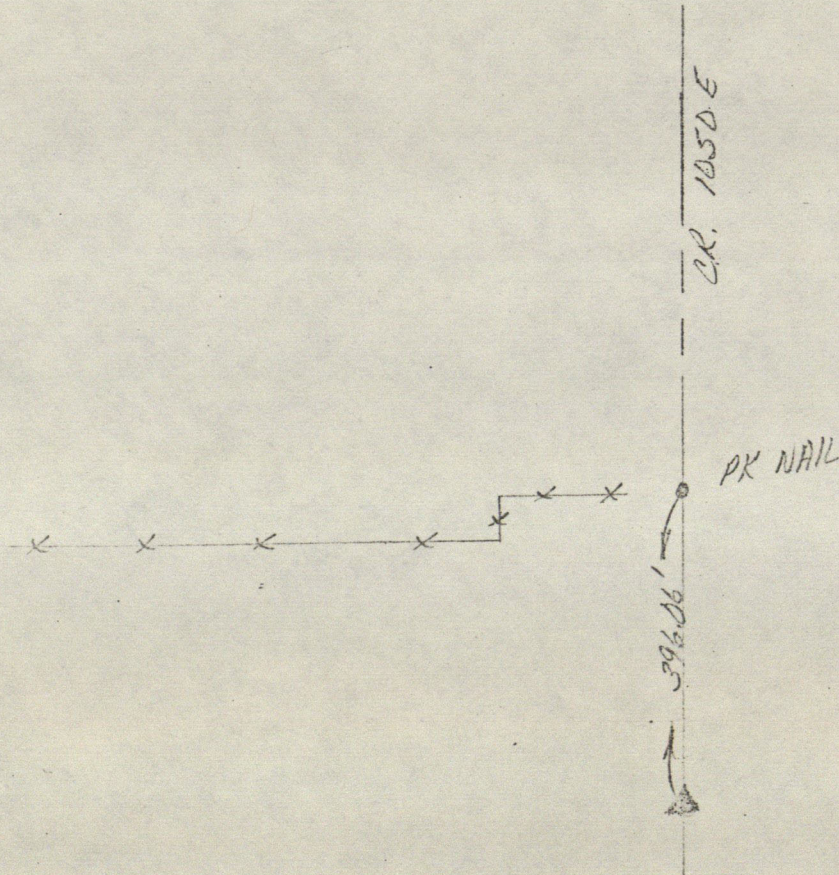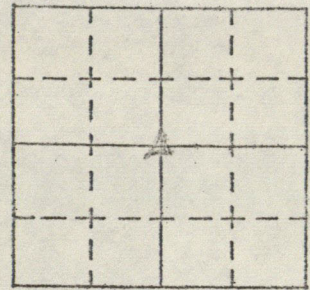



RECORD OF CORNER

LOCATION OF MONUMENT: SECTION 32, T.16 N., R.2 E.

Found: ☒ Set: ☐ Depth: About 5 inches

Description: Brass plug in concrete pavement

Bearings to reference objects are magnetic unless a contrary mode is shown.

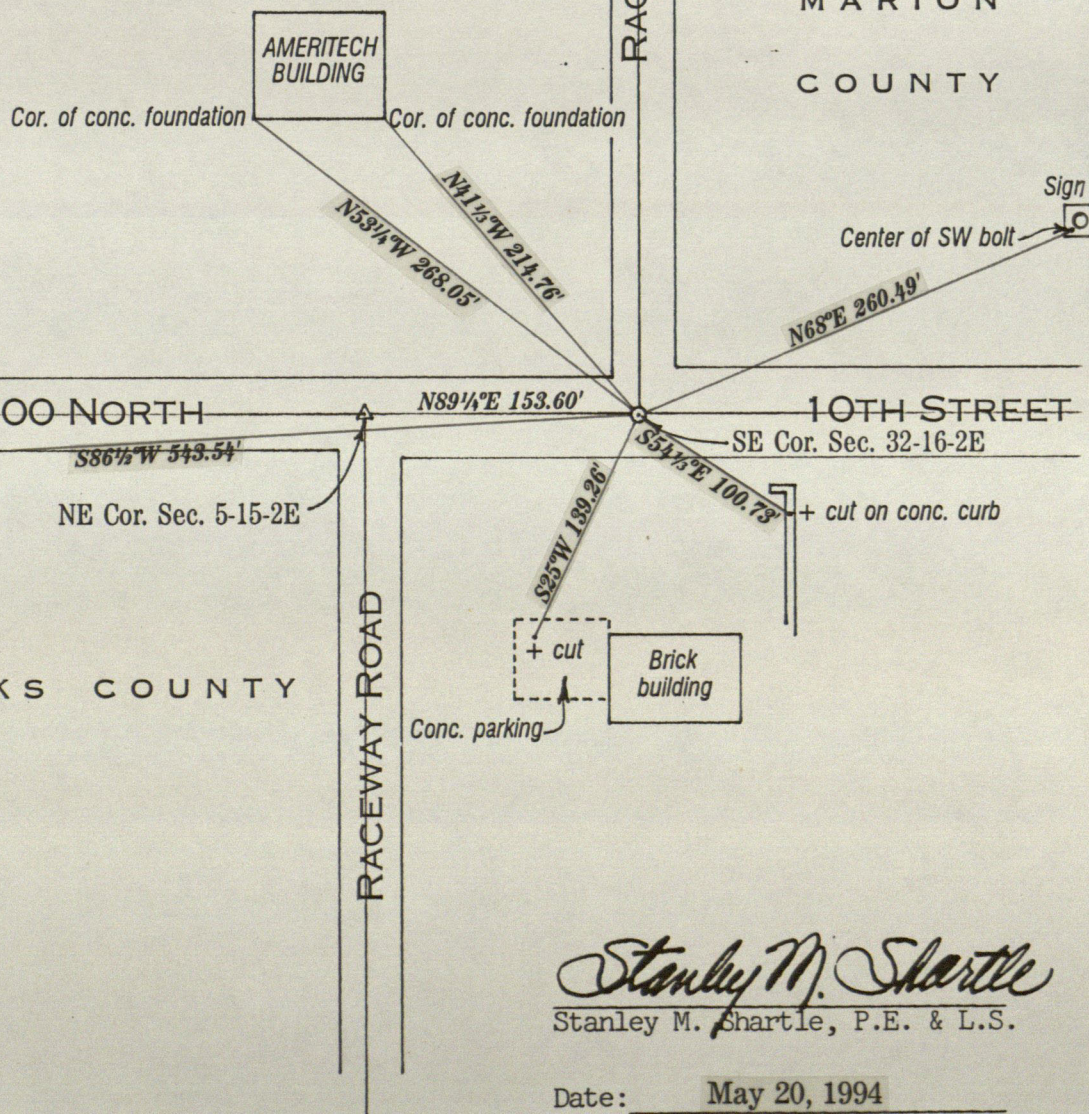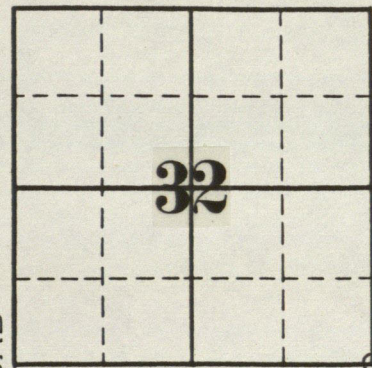

Stanley M. Shartle
Stanley M. Shartle, P.E. & L.S.

Date: May 20, 1994

HENDRICKS COUNTY

DESIGNATION OF MARKER

Sec. 32 T. 16 N R 2 E

Marker found: yes _____ no _____

Type of Marker: _____

Description: _____



Depth and Marking _____

References set: yes _____ no _____

Sketch References below.

Date: _____ Set by: _____

Comments:

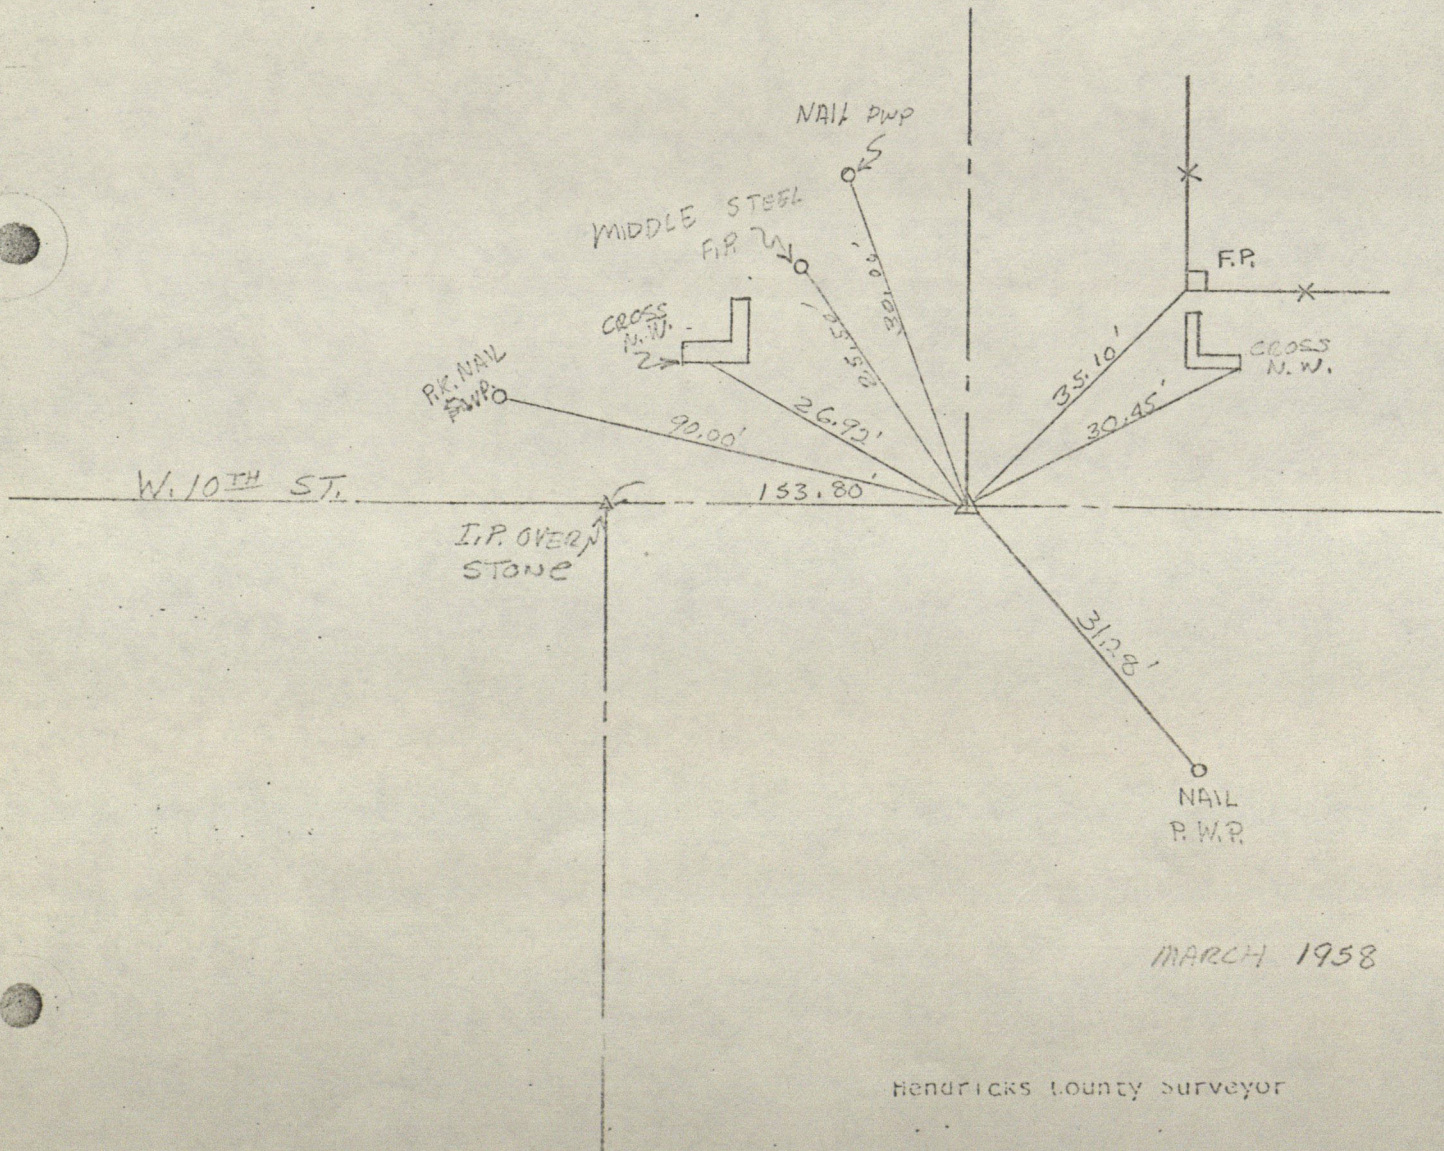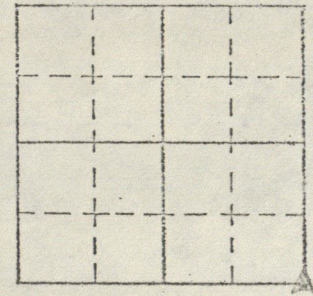

HENDRICKS COUNTY

DESIGNATION OF MARKER _____

Sec. 32 T 16 N R 2 E

Marker found: yes _____ no _____

Type of Marker: _____

Description: _____



Depth and Marking _____

References set: yes _____ no _____

Sketch References below.

Date: _____ Set by: _____

Comments:

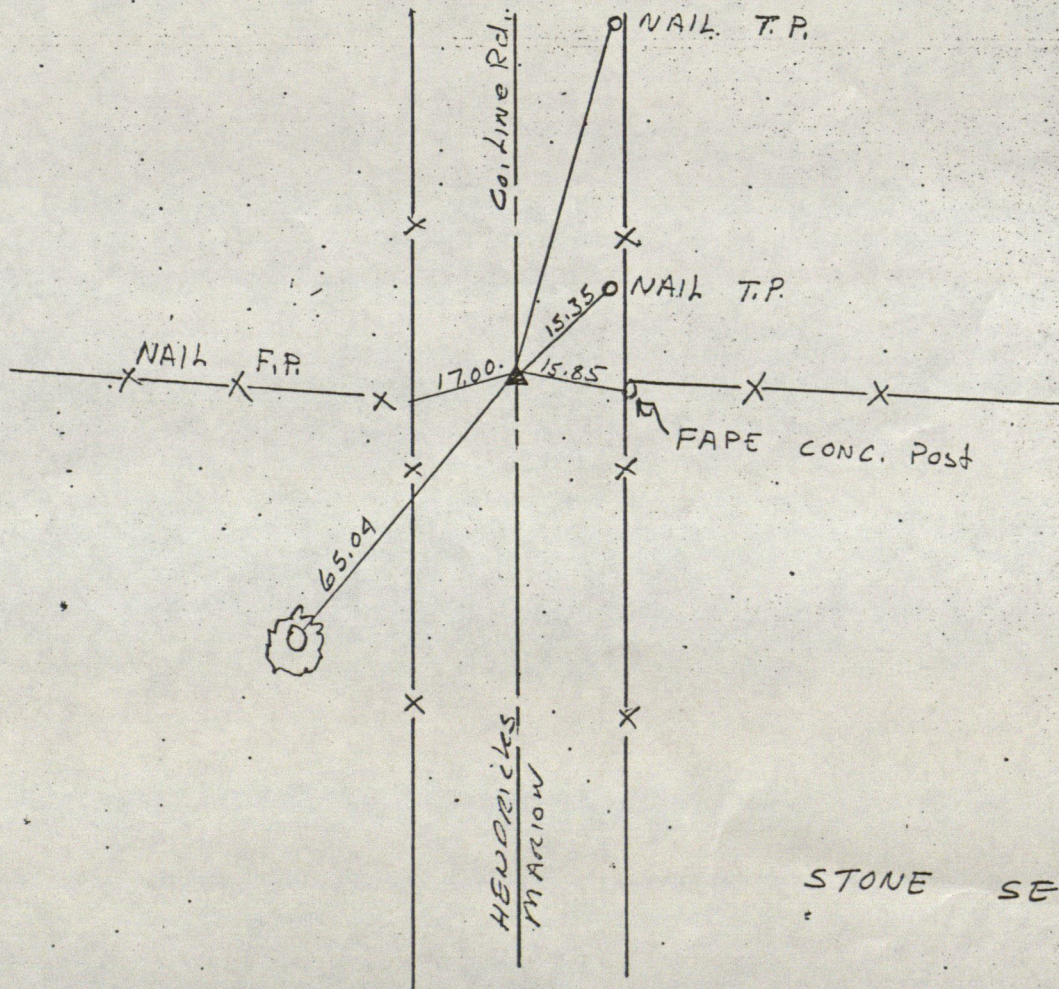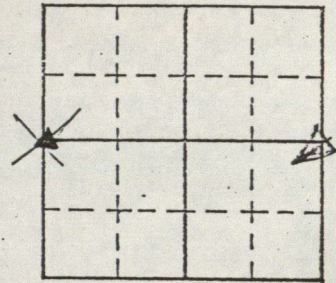

STONE SET 4/13/43



Hendricks County Surveyor

Hendricks-Marion County Line

HENDRICKS COUNTY

DESIGNATION OF MARKER E 1/2 mile

SEC 22 TWP 16 RANGE 2E

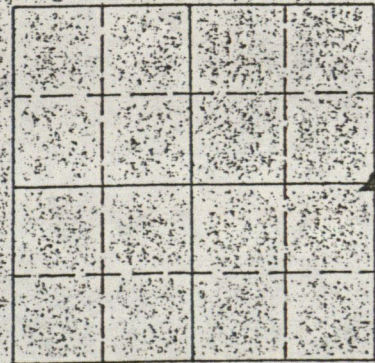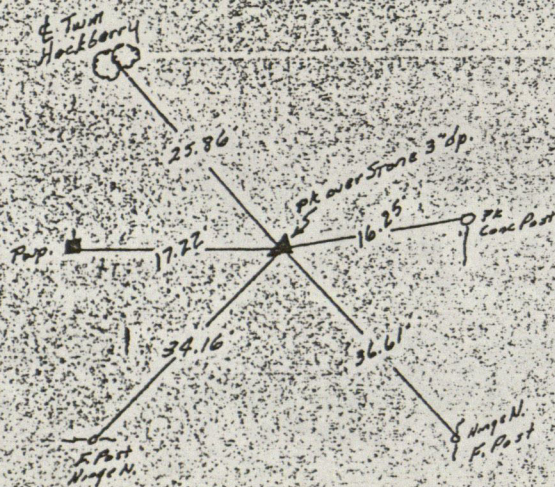

E 1/2 Mile, Sec. 32-16-2E


9-24-67
DDW

Hendricks-Marion County Line


INDEX TO LANDMARKS

THE MARION COUNTY SURVEYOR'S OFFICE

SECTION 33 TOWNSHIP 16 N., RANGE 2 E.

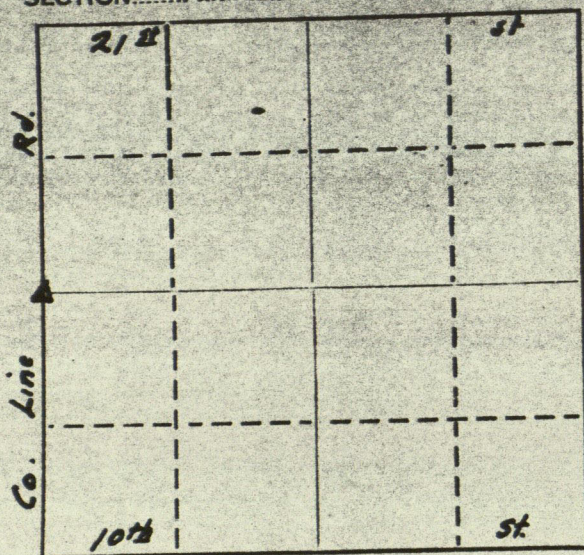

REMARKS

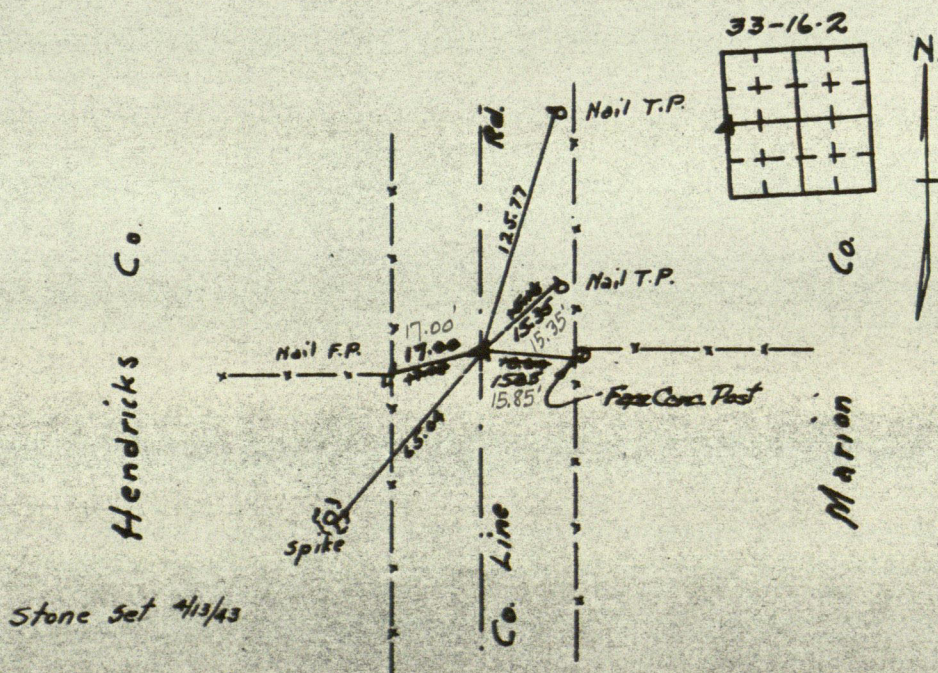

SECTION CORNER RECORD MARION COUNTY, INDIANA

Sec. 33 T. 16 R. 2



DATE : 7/25/77

CREW : P.C. - R MILLER

Inst. - D KENT Rod. - T SMITH

TYPE of MARKER : STONE DOWN 12" Cond. of MARKER : GOOD

METHOD of ESTABLISHMENT : COUNTY TIES

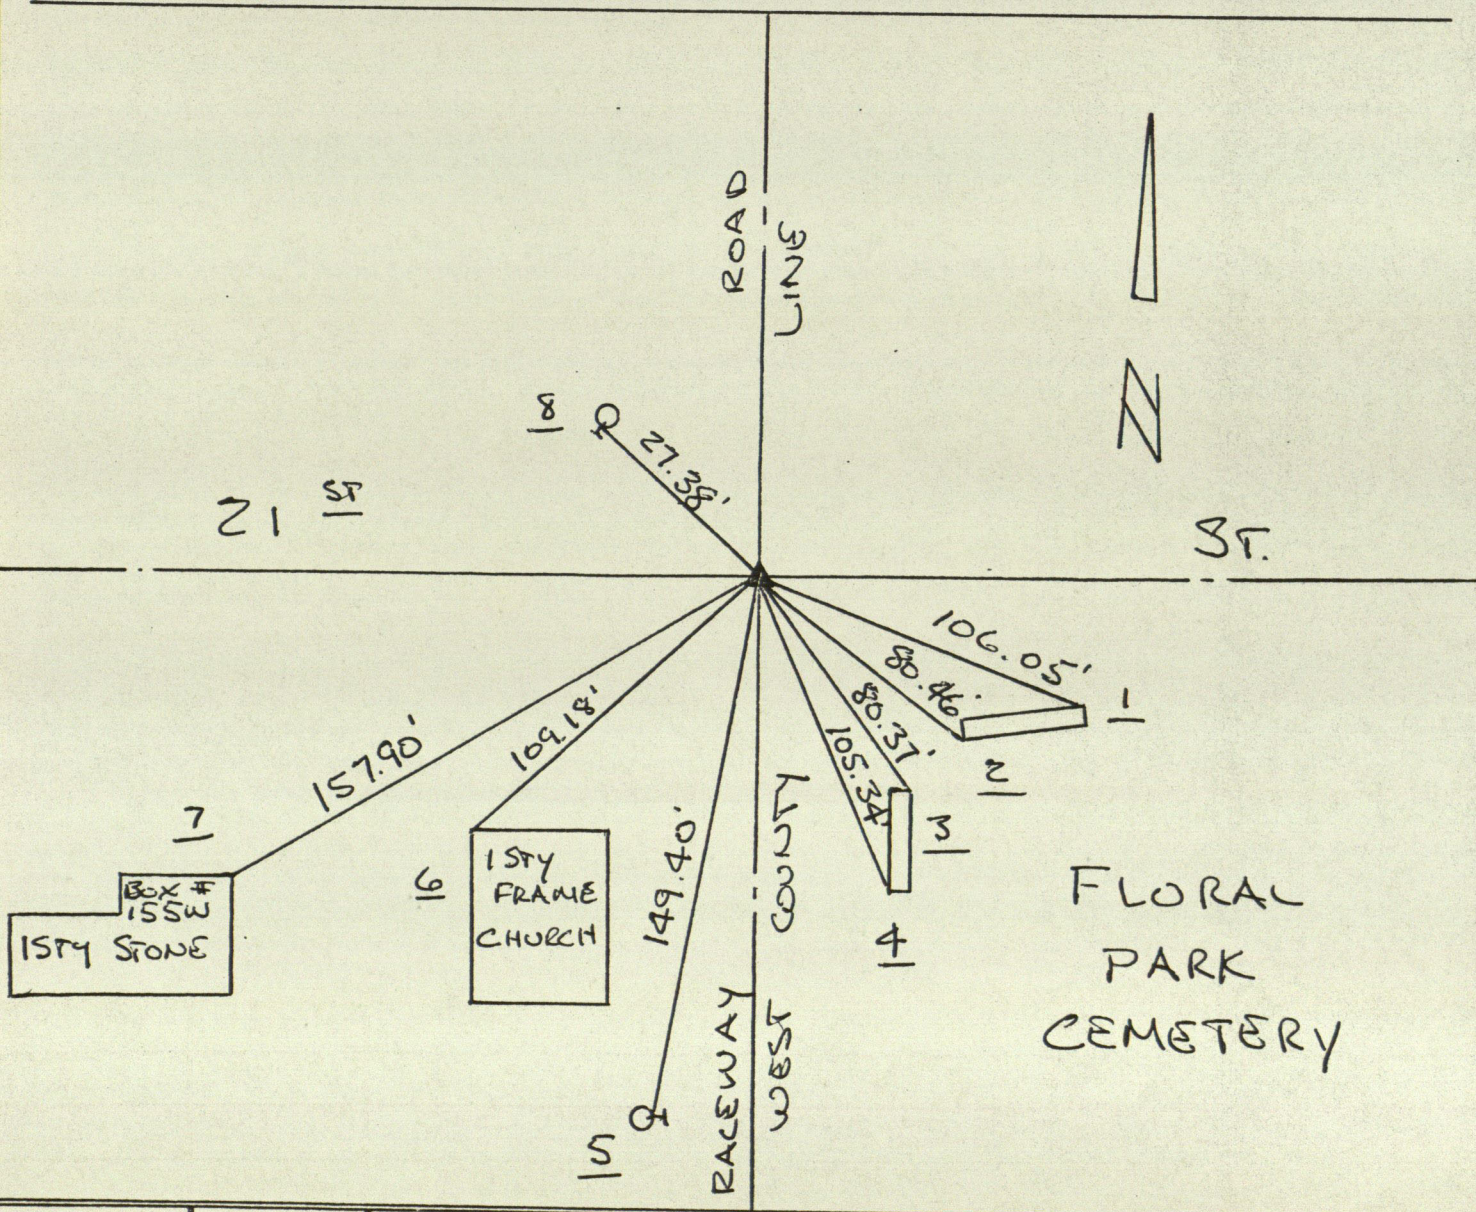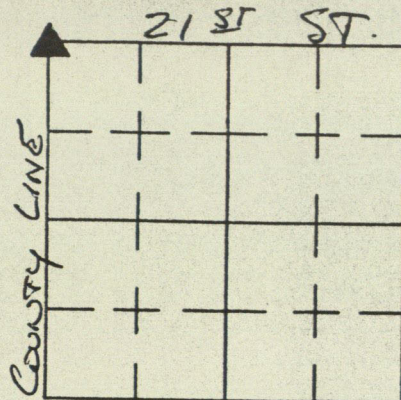

REFERENCE	DISTANCE	DESCRIPTION
1	106.05'	NE COR of STONE WALL
2	80.46	SW COR of STONE WALL
3	80.37	NE COR of STONE WALL
4	105.34	SW COR of STONE WALL
5	149.40	Rd Nail East Side PWP — 12" Up
6	109.18	NW COR of CHURCH @ FOUNDATION
7	157.90	NE COR of HOUSE @ STONE 5' Up
8	27.38	Rd Nail SW Corner PWP 1-451VW 12" Up

SECTION CORNER RECORD MARION COUNTY, INDIANA

Sec. 33 T. 16 R. 2


DATE 3-12-19

CREW P. D. Miller

INST. Leica Rod Bow

TYPE OF MARKER Brass Plug Cond. of MARKER Good


METHOD OF ESTABLISHMENT County File 12-1-11

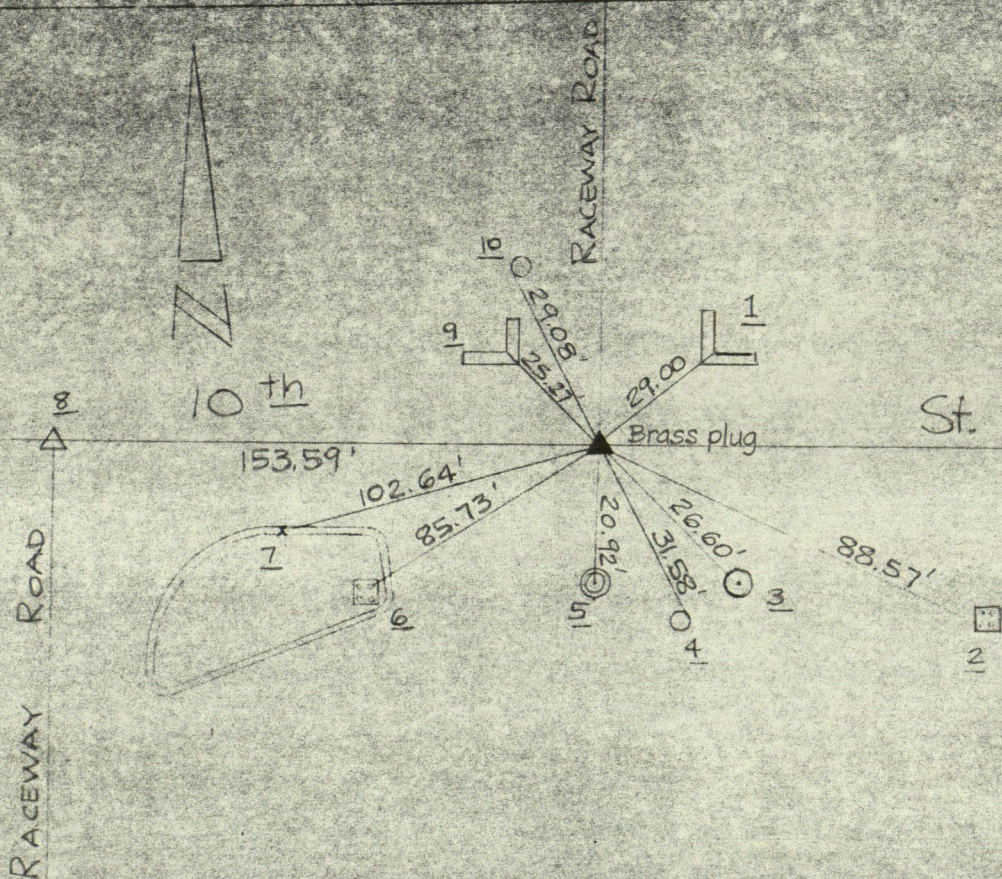


REFERENCE	STANCE	DESCRIPTION
1	29.00	Inside Corner of HDWL.
2	88.57	SW Anchor Bolt of Light Pole Base
3	26.60	Center of Bell MH
4	31.58	Rd Nail NE Side of Guy Pole* — 6" Up
5	20.92	Center of Bell MH
6	85.73	NE Anchor Bolt of Light Pole Base
7	102.64	Cut Cross in Conc Curb
8	153.59	Stone @ NW Corner of Section 4-15-2E
9	25.27	Inside Corner of HDWL
10	29.08	PK Nail in SW Side PwP* 4 1/2" DIA 4" Up

SECTION CORNER RECORD
MARION COUNTY, INDIANA
Sec. 33 T. 16 R. 2

DATE : 7/25/77
CREW : P.C. - R MILLER
Inst. - D KENT Rod. - T SMITH

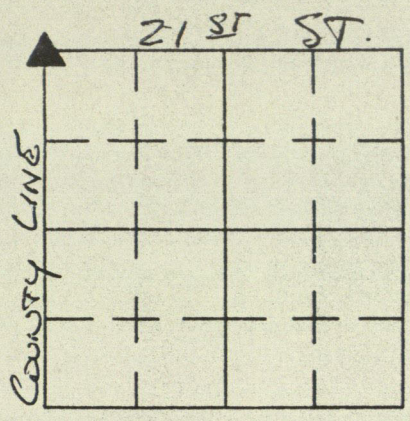

TYPE of MARKER : STONE DOWN 12" Cond. of MARKER : GOOD
METHOD of ESTABLISHMENT : COUNTY TIES

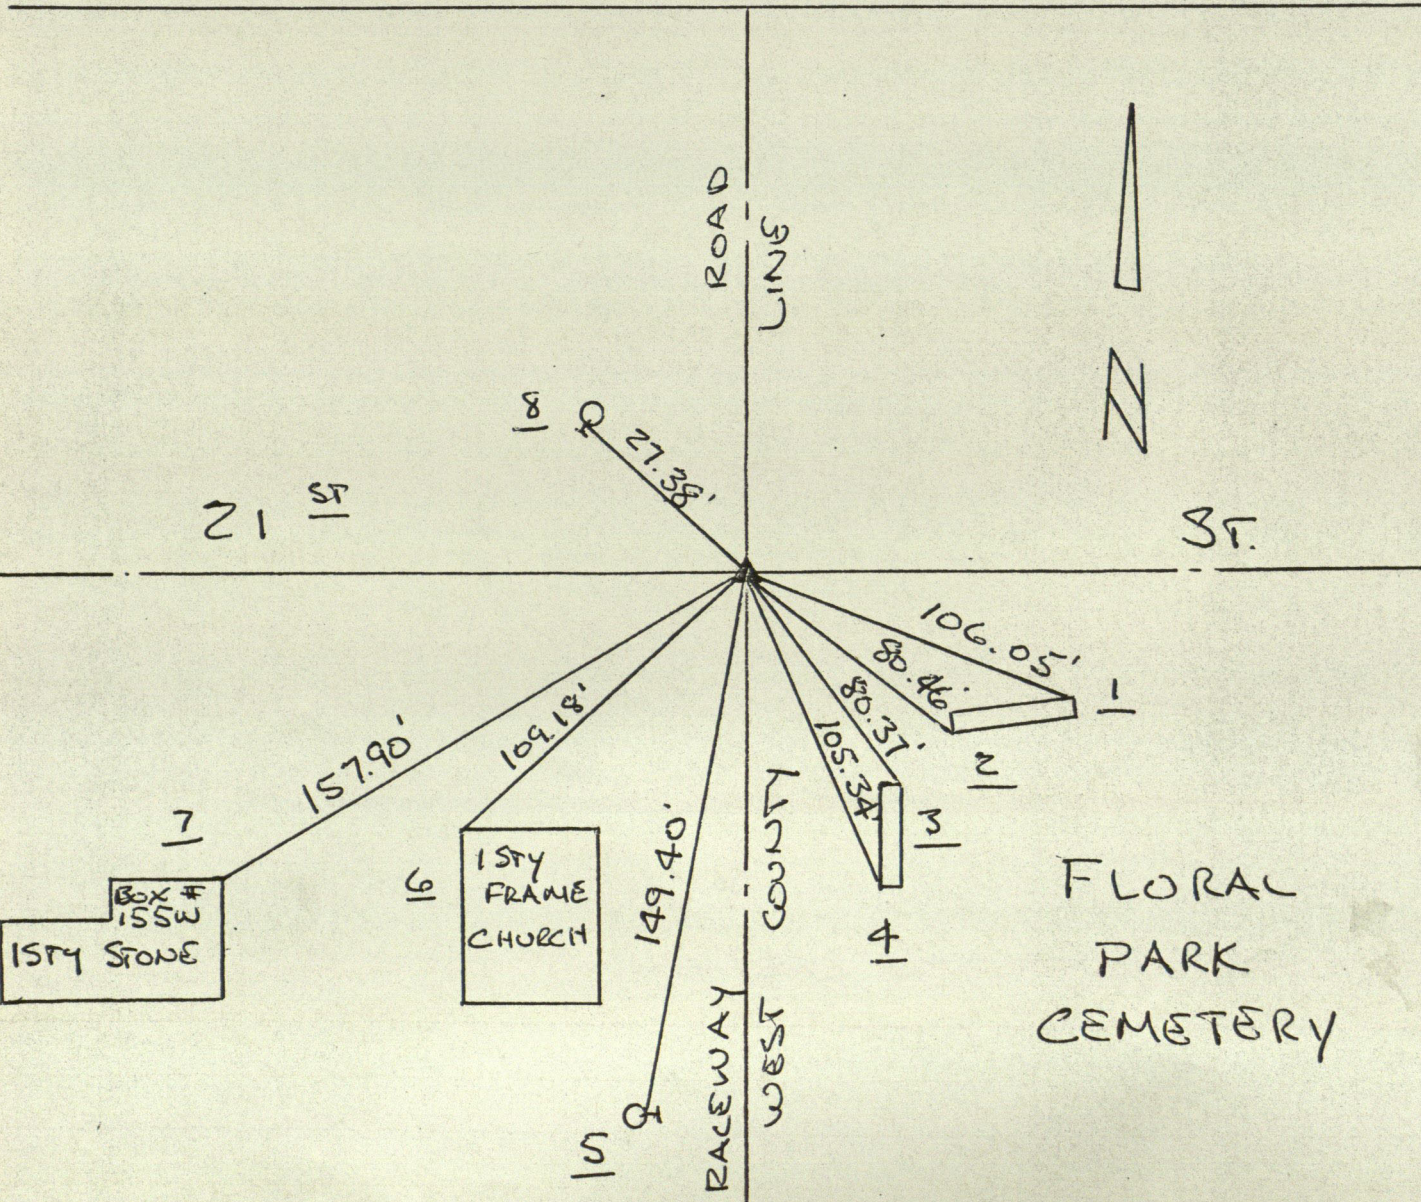

REFERENCE	DISTANCE	DESCRIPTION
1	106.05'	NE COR of STONE WALL
2	80.46	SW COR of STONE WALL
3	80.37	NE COR of STONE WALL
4	105.34	SW COR of STONE WALL
5	149.40	Rd Nail East Side RWP — 12" Up
6	109.18	NW COR of CHURCH @ FOUNDATION
7	157.90	NE COR of HOUSE @ STONE 5' Up
8	27.38	Rd Nail SW C 108 RWP #1-451VW 12" Up